



"SHEET 3"  
HARMON COAL CORPORATION  
MINE NO. 1  
REDBANK TWP. ARMSTRONG COUNTY  
PENNSYLVANIA  
SCALE 1"=100'

JOHN HUFFMAN

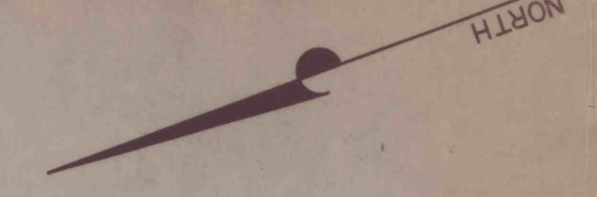

SMITH, COLBERT & KING

ARNOLD SHICK

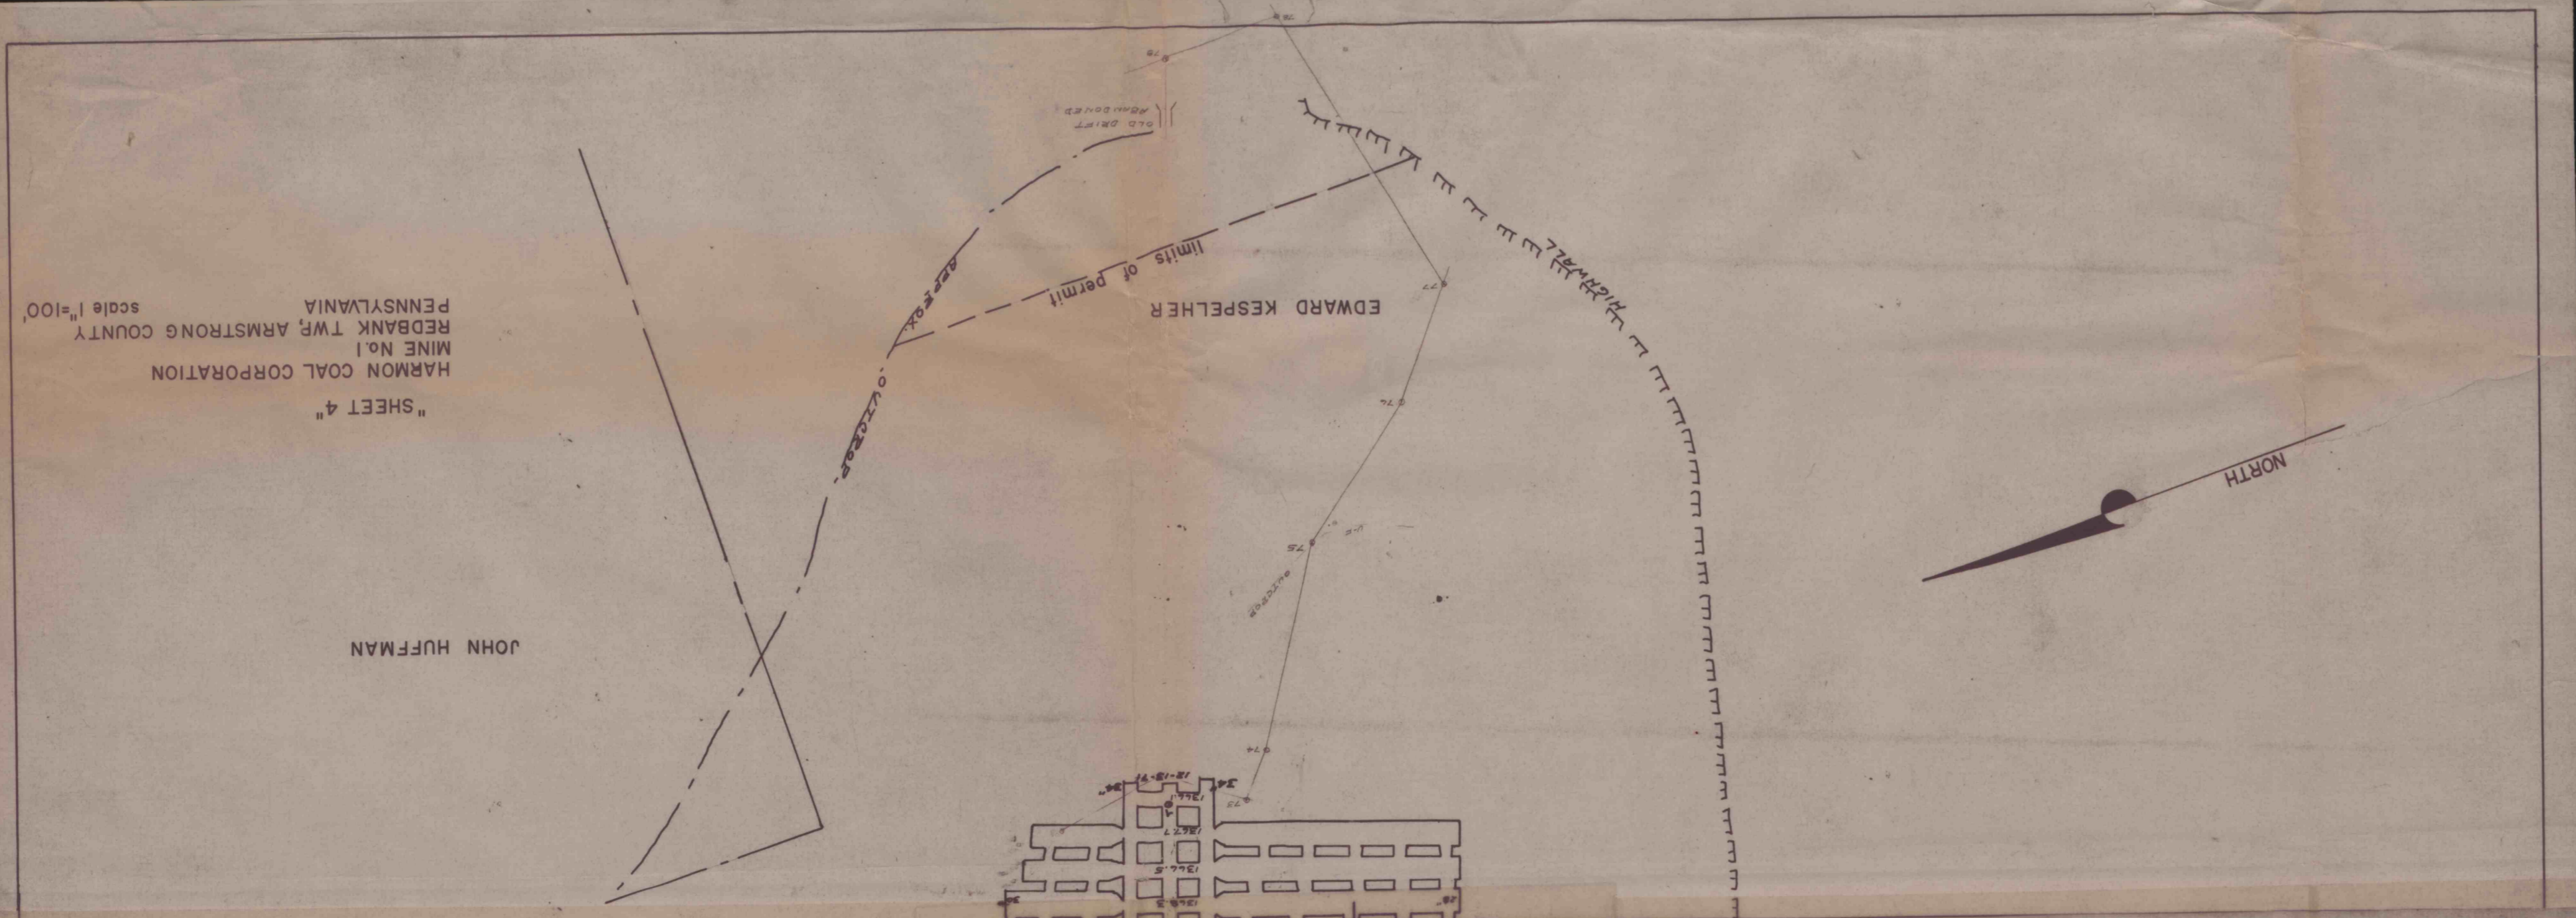


"SHEET 4"  
HARMON COAL CORPORATION  
MINE NO. 1  
REDBANK TWP. ARMSTRONG COUNTY  
PENNSYLVANIA  
SCALE 1"=100'

JOHN HUFFMAN

HARMON COAL CORPORATION  
MINE NO. 1  
REDBANK TOWNSHIP ARMSTRONG COUNTY  
PENNSYLVANIA  
JULY 1966  
1"=100'

EDWARD KESPELHER

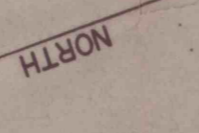

LEGEND  
CONTINGENT MINING 3-1-72-9-1-72  
MINING COMPLETED  
ACTIVE ENTRIES  
DRAWN STUMPS



AS SHOWN ON THE RECORD MAP OF THE COMMONWEALTH OF PENNSYLVANIA



NOTE: All mining is completed on sheet and as shown.

"SHEET 1"

JOSEPH R. HOFFMAN

