
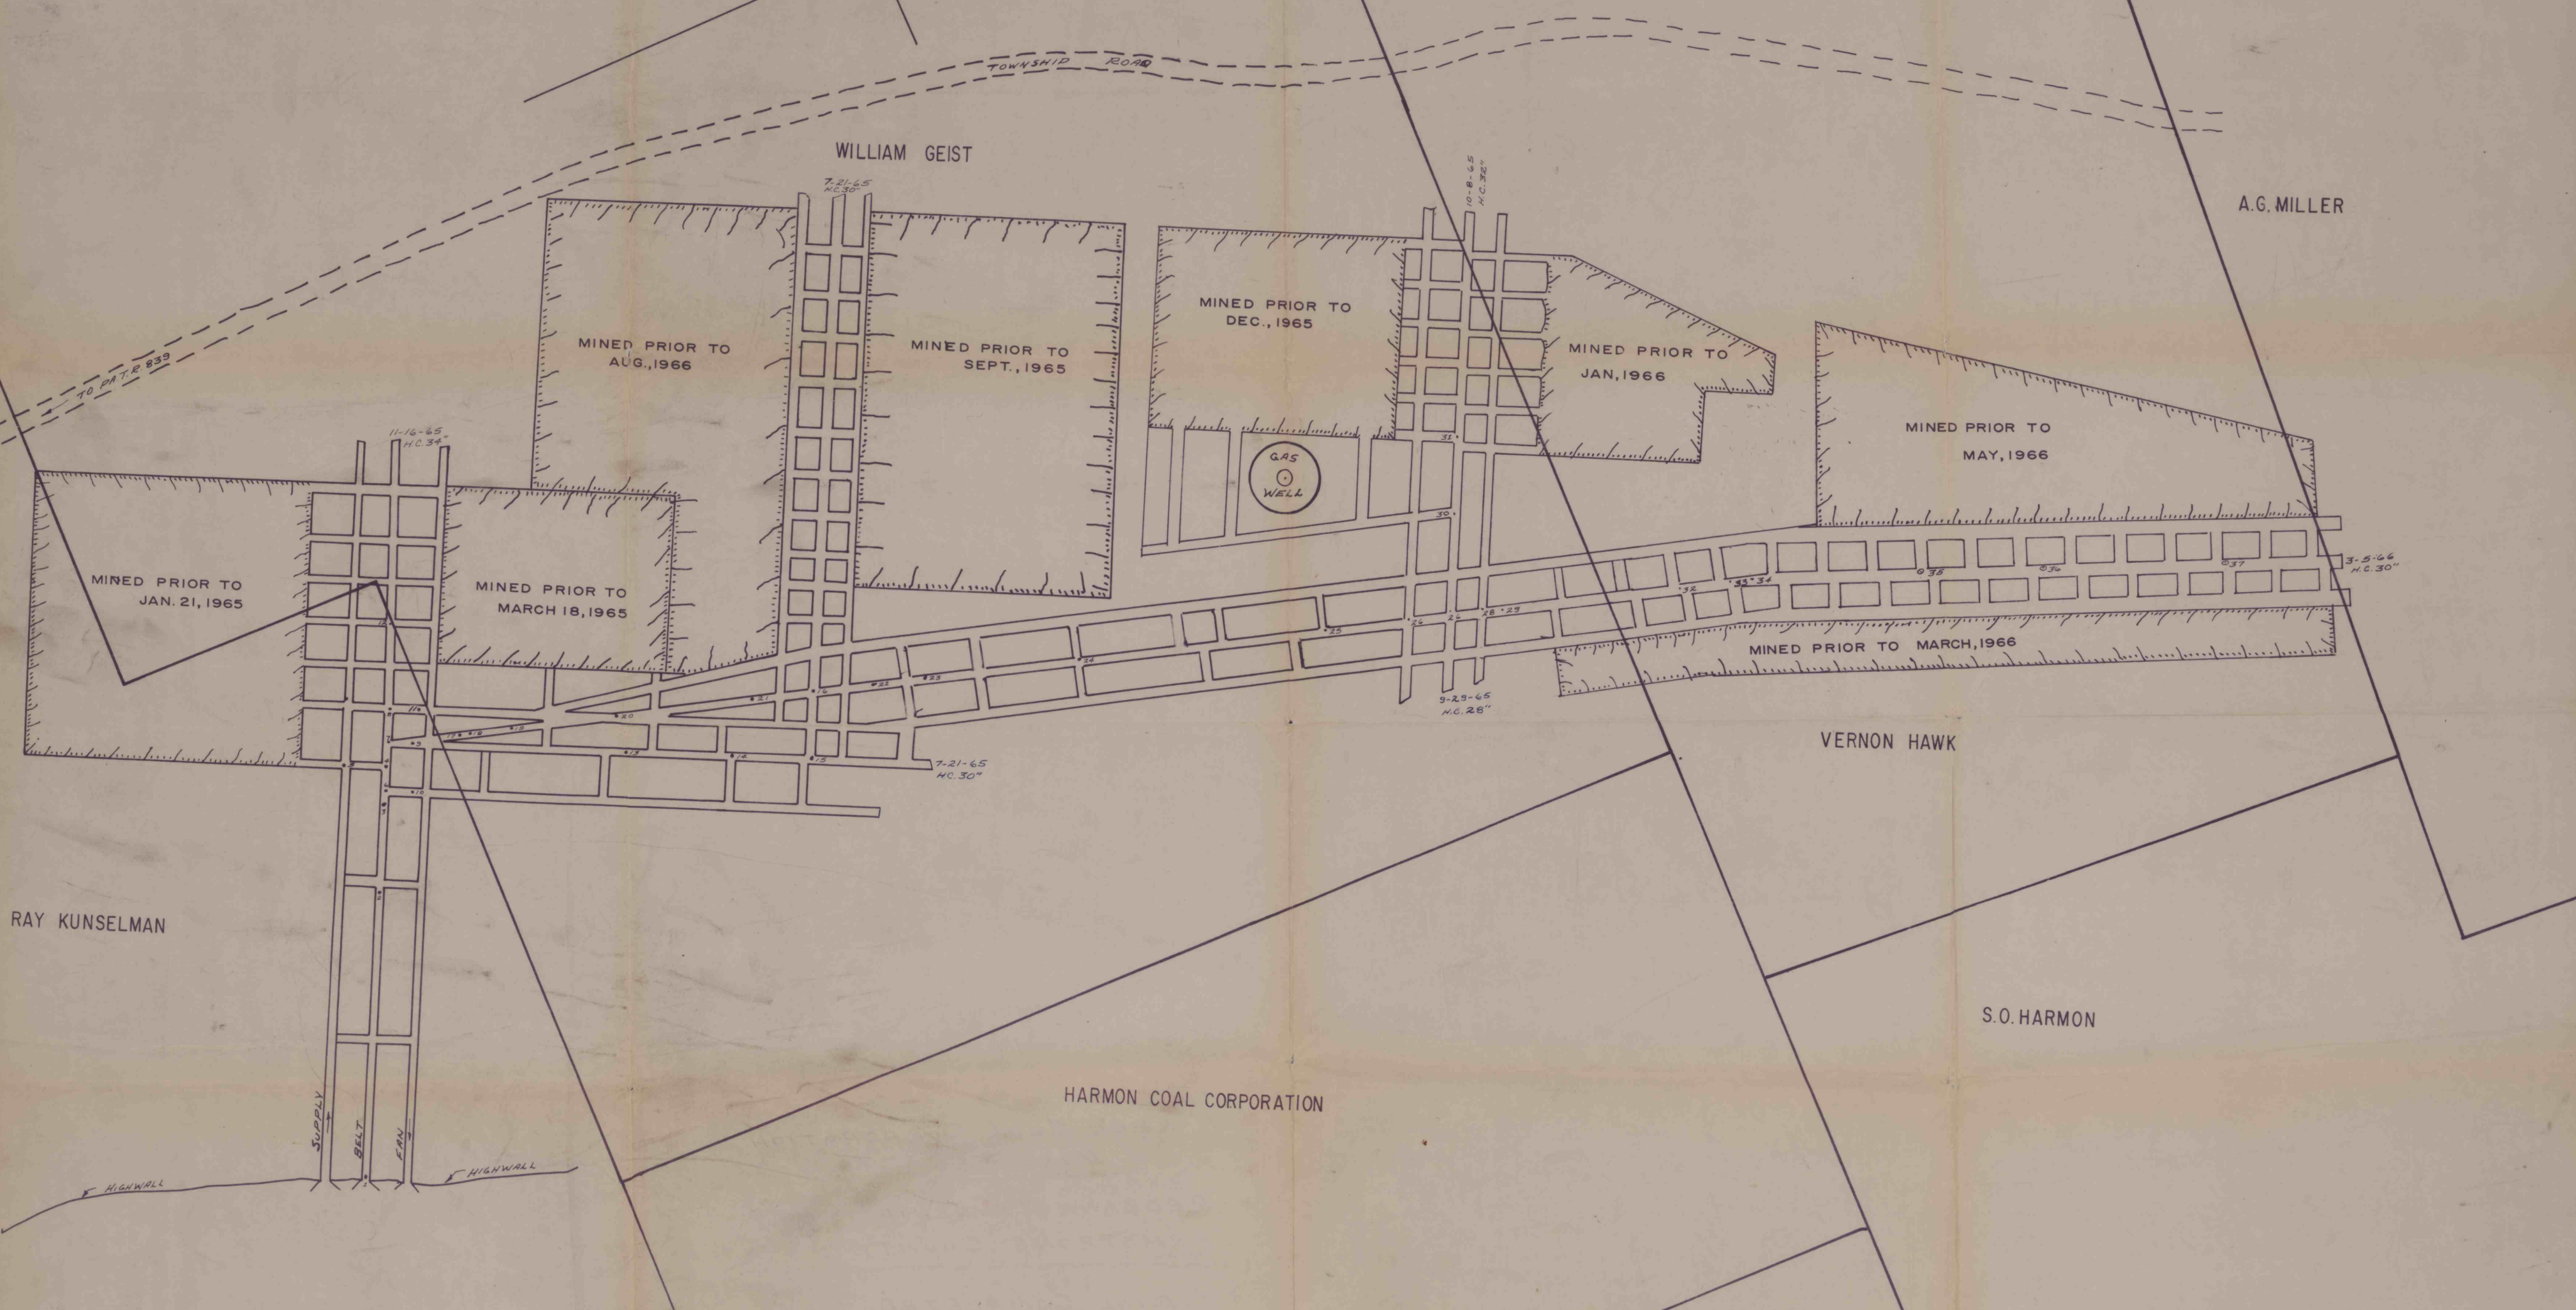


SURVEY RECORD	
DATE	STATIONS
JULY 1, 1964	1-2
NOVEMBER 11, 1964	3-5
NOVEMBER 16, 1964	6-12
JANUARY 21, 1965	13
MARCH 19, 1965	14-15
APRIL 12, 1965	16
JULY 21, 1965	17-20
AUGUST 4, 1965	21-22
SEPTEMBER 3, 1965	23-30
OCTOBER 8, 1965	31-33
DECEMBER 1, 1965	34-37
MARCH 5, 1966	38-39

MINE COMPLETED & SEALED-MAY, 1966

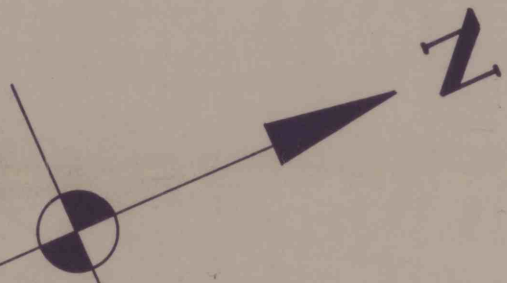

HARMON COAL CORPORATION
MINE No. 5
REDBANK TOWNSHIP-ARMSTRONG COUNTY
PENNSYLVANIA

SCALE: 1"=100'



#1207
7-24-99
G.C.