


FREE BROOK CORPORATION

WILLIAM GEIST



RAY KUNSELMAN

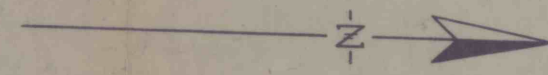

MINE MAP  
**HARMON COAL CO.**  
 COAL MINE

DATE OF SURVEY

Jan. 22,	1958
Feb. 21,	1958
July 30,	1958
Nov. 4,	1958
Feb. 18,	1959
Feb. 29,	1960

REDBANK TOWNSHIP, ARMSTRONG COUNTY, PENNA.  
 SCALE 1"=100' JANUARY 30, 1958  
 WALTER J. ZIMMERMAN SURVEYOR ENGINEER PUNXSUTAWNEY, PA.

RECEIVED  
 DEPT. OF REVENUE  
 HARRISBURG, PA.  
 FEB 15 PM 1:58

I HERBY CERTIFY THAT THIS MAP IS A TRUE, COMPLETE, AND CORRECT MAP AND SURVEY OF ALL THE EXCAVATIONS MADE IN THIS MINE

*Walter Zimmerman*  
 REGISTERED PROFESSIONAL ENGINEER  
 No. 4940  
 I hereby certify that this print is a true and correct copy of the original map of this mine. *Walter Zimmerman*  
 R.P.E. 4940