



FREEBROOK CORPORATION

WILLIAM GEIST

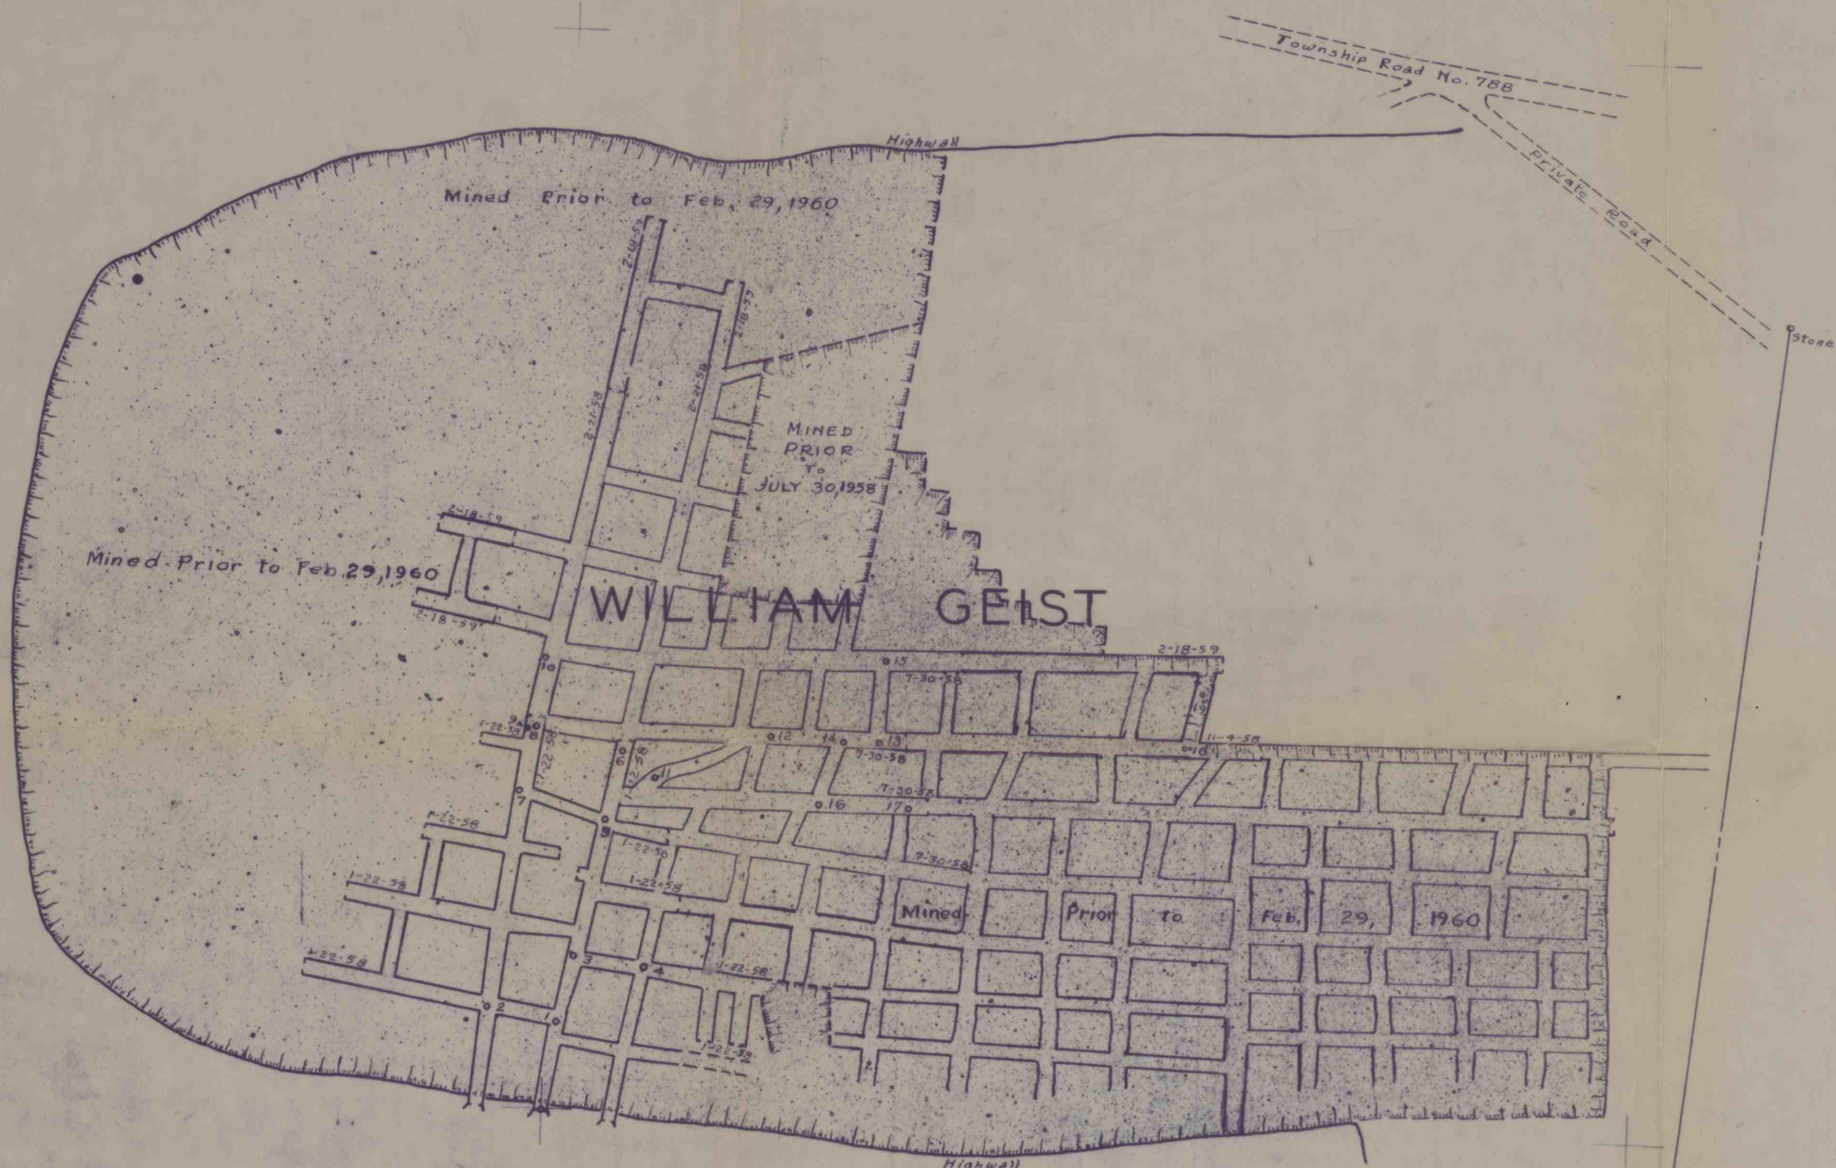

RAY KUNSELMAN

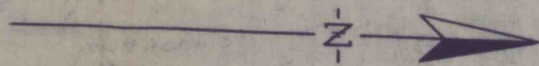

MINE MAP
HARMON COAL CO.
 COAL MINE

REDBANK TOWNSHIP, ARMSTRONG COUNTY, PENNA.

SCALE 1"=100' JANUARY 30, 1958

WALTER J. ZIMMERMAN SURVEYOR ENGINEER PUNXSUTAWNEY, PA.

DATE OF SURVEY

- Jan. 22, 1958
- Feb. 21, 1958
- July 30, 1958
- Nov. 4, 1958
- Feb. 18, 1959
- Feb. 29, 1960

I HERBY CERTIFY THAT THIS MAP IS A TRUE, COMPLETE, AND CORRECT MAP AND SURVEY OF ALL THE EXCAVATIONS MADE IN THIS MINE

Walter J. Zimmerman
 REGISTERED PROFESSIONAL ENGINEER
 NO. 4940

I hereby certify that this print is a true and correct copy of the original map of this mine.
Walter J. Zimmerman
 R.P.E. #4940