




"SHEET 1"

"SHEET 3"
HARMON COAL CORPORATION
MINE No. 1
REDBANK TWP. ARMSTRONG COUNTY
PENNSYLVANIA
scale 1"=100'

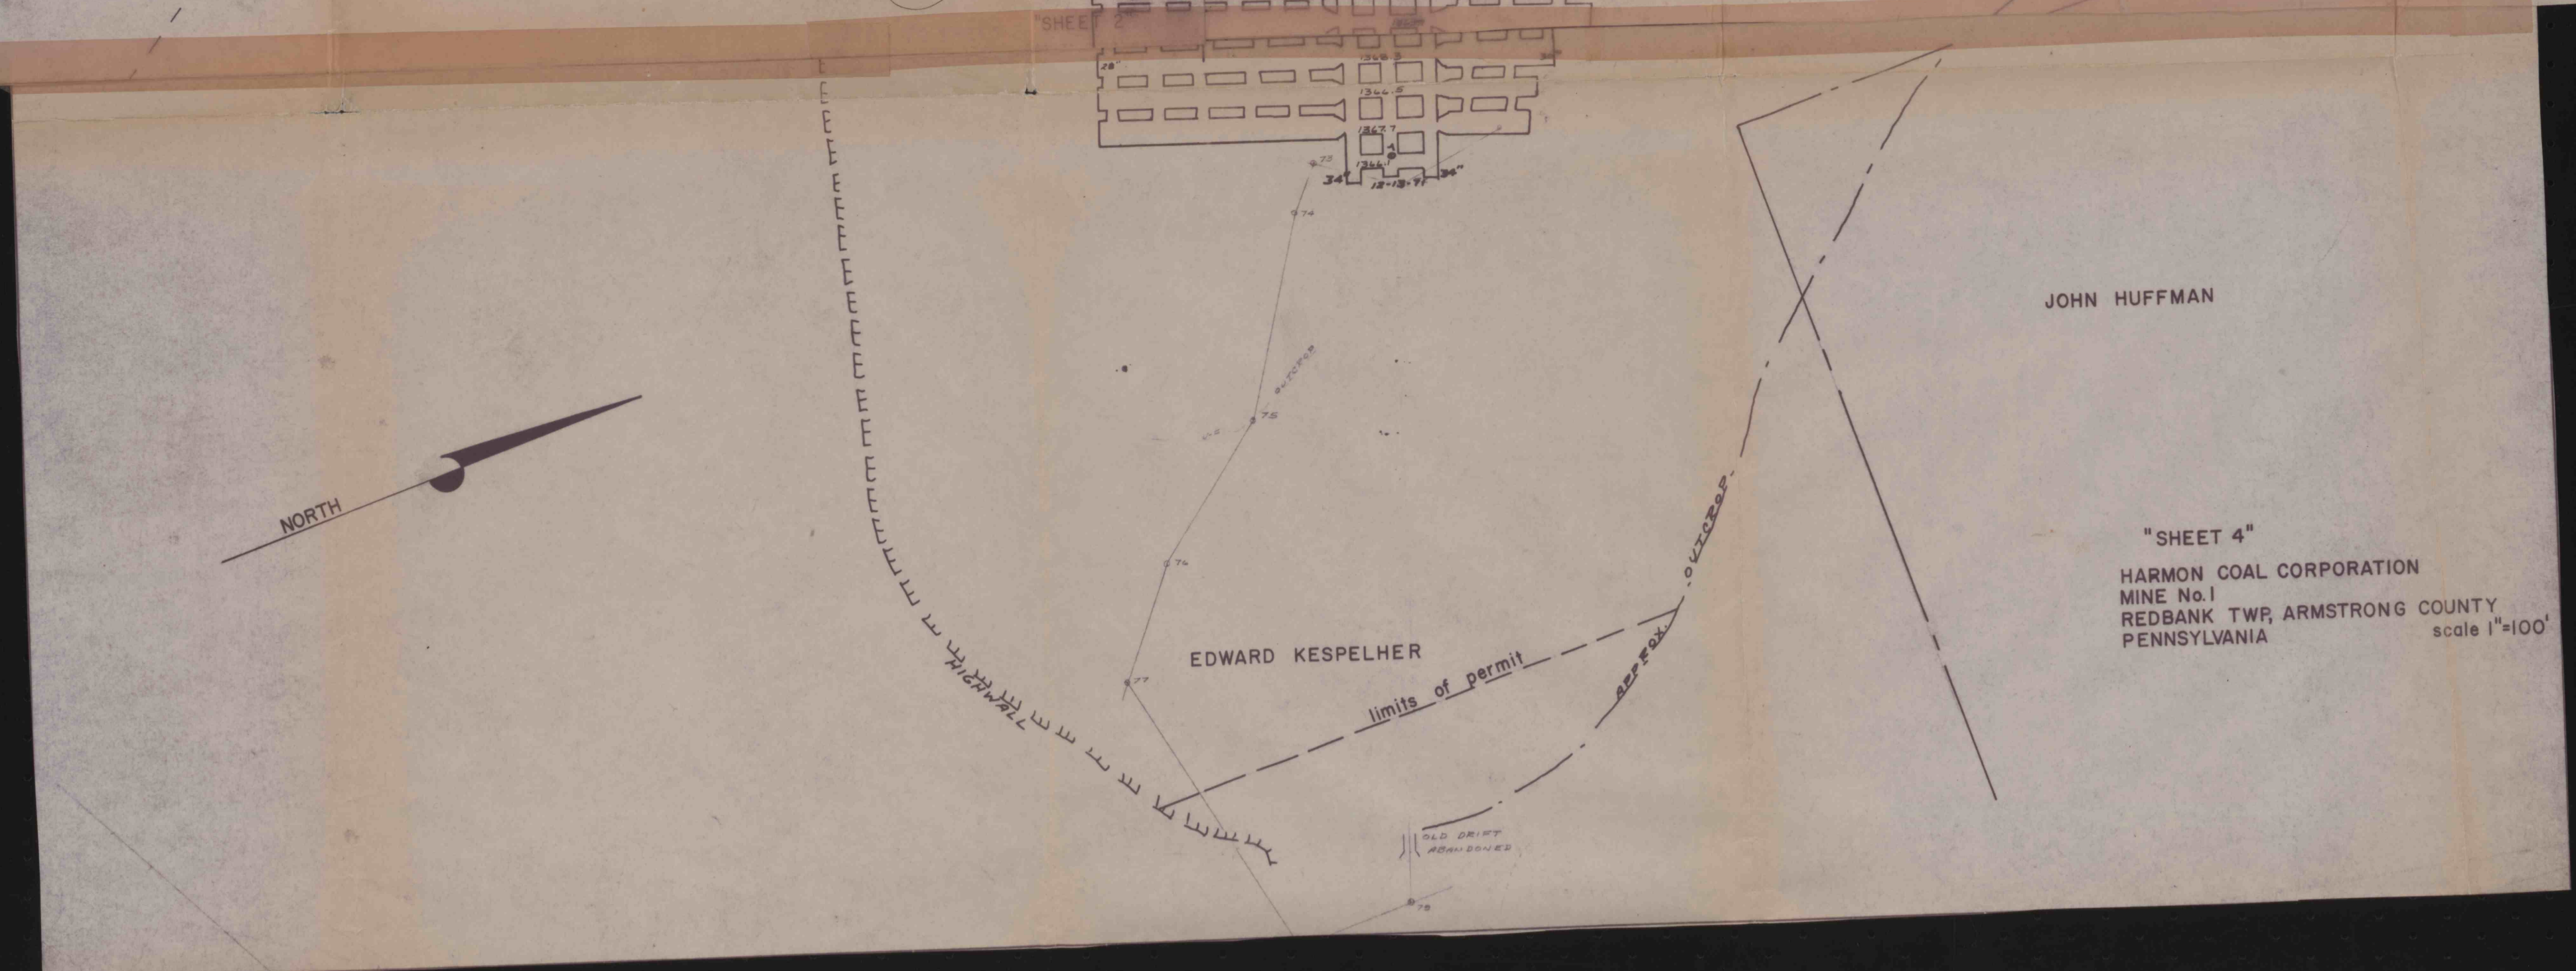

"SHEET 4"
HARMON COAL CORPORATION
MINE No. 1
REDBANK TWP. ARMSTRONG COUNTY
PENNSYLVANIA
scale 1"=100'