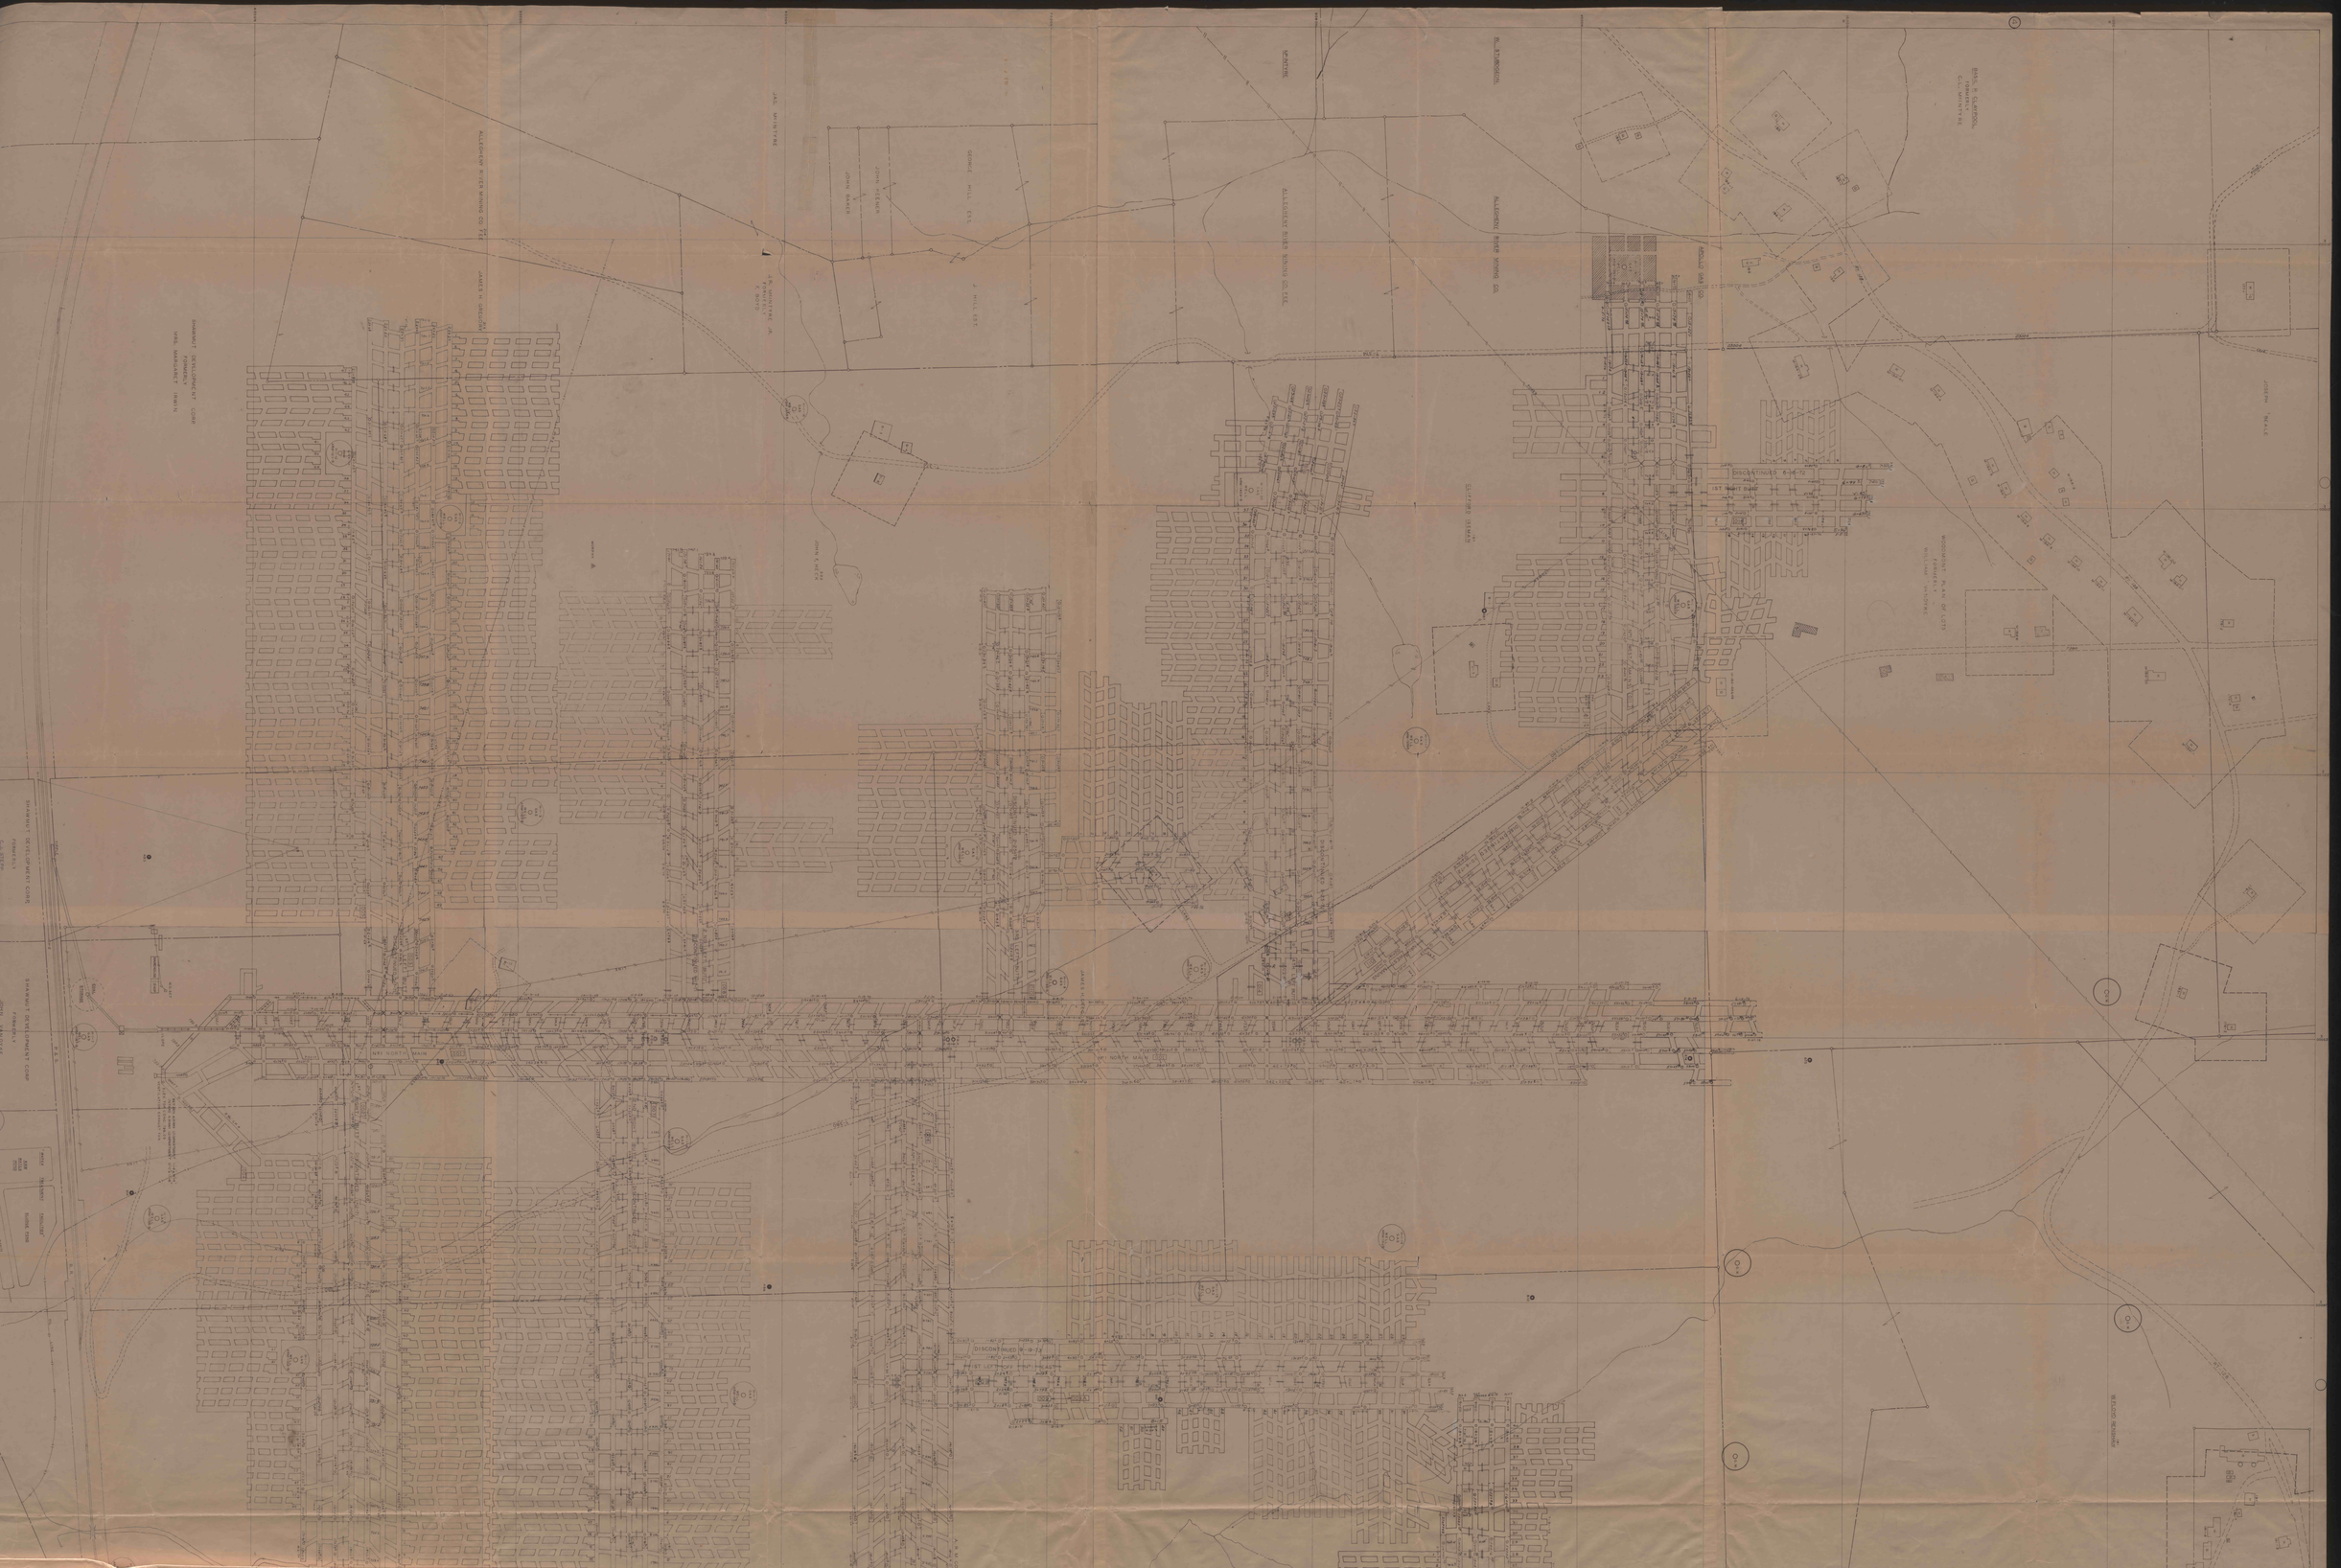
ALLEGHENY RIVER MINING CO. ETC.
JAS. MCINTYRE
JOHN KERR
GEORGE HILL ESTATE
J. HILLES ETC.
JAMES M. GIBSON
ALLEGHENY RIVER MINING CO.
CLIFFORD STEWART
JOHN KERR
JOHN WALZ
DISCONTINUED 4-24-74
1ST PART FILED
DISCONTINUED 10-12-74
NO FILM
1ST PART FILED
MAIN
NORTH
SOUTH
WEST
EAST