


Abandoned workings from Foreman Mine
Traced from blue print of Masband Surveys by W. A. Sullivan, Engr.

40' BARRIER PILLAR
N 40° 26' E

FOREMAN-WHITE COAL CO.

2310.6 50' BARRIER

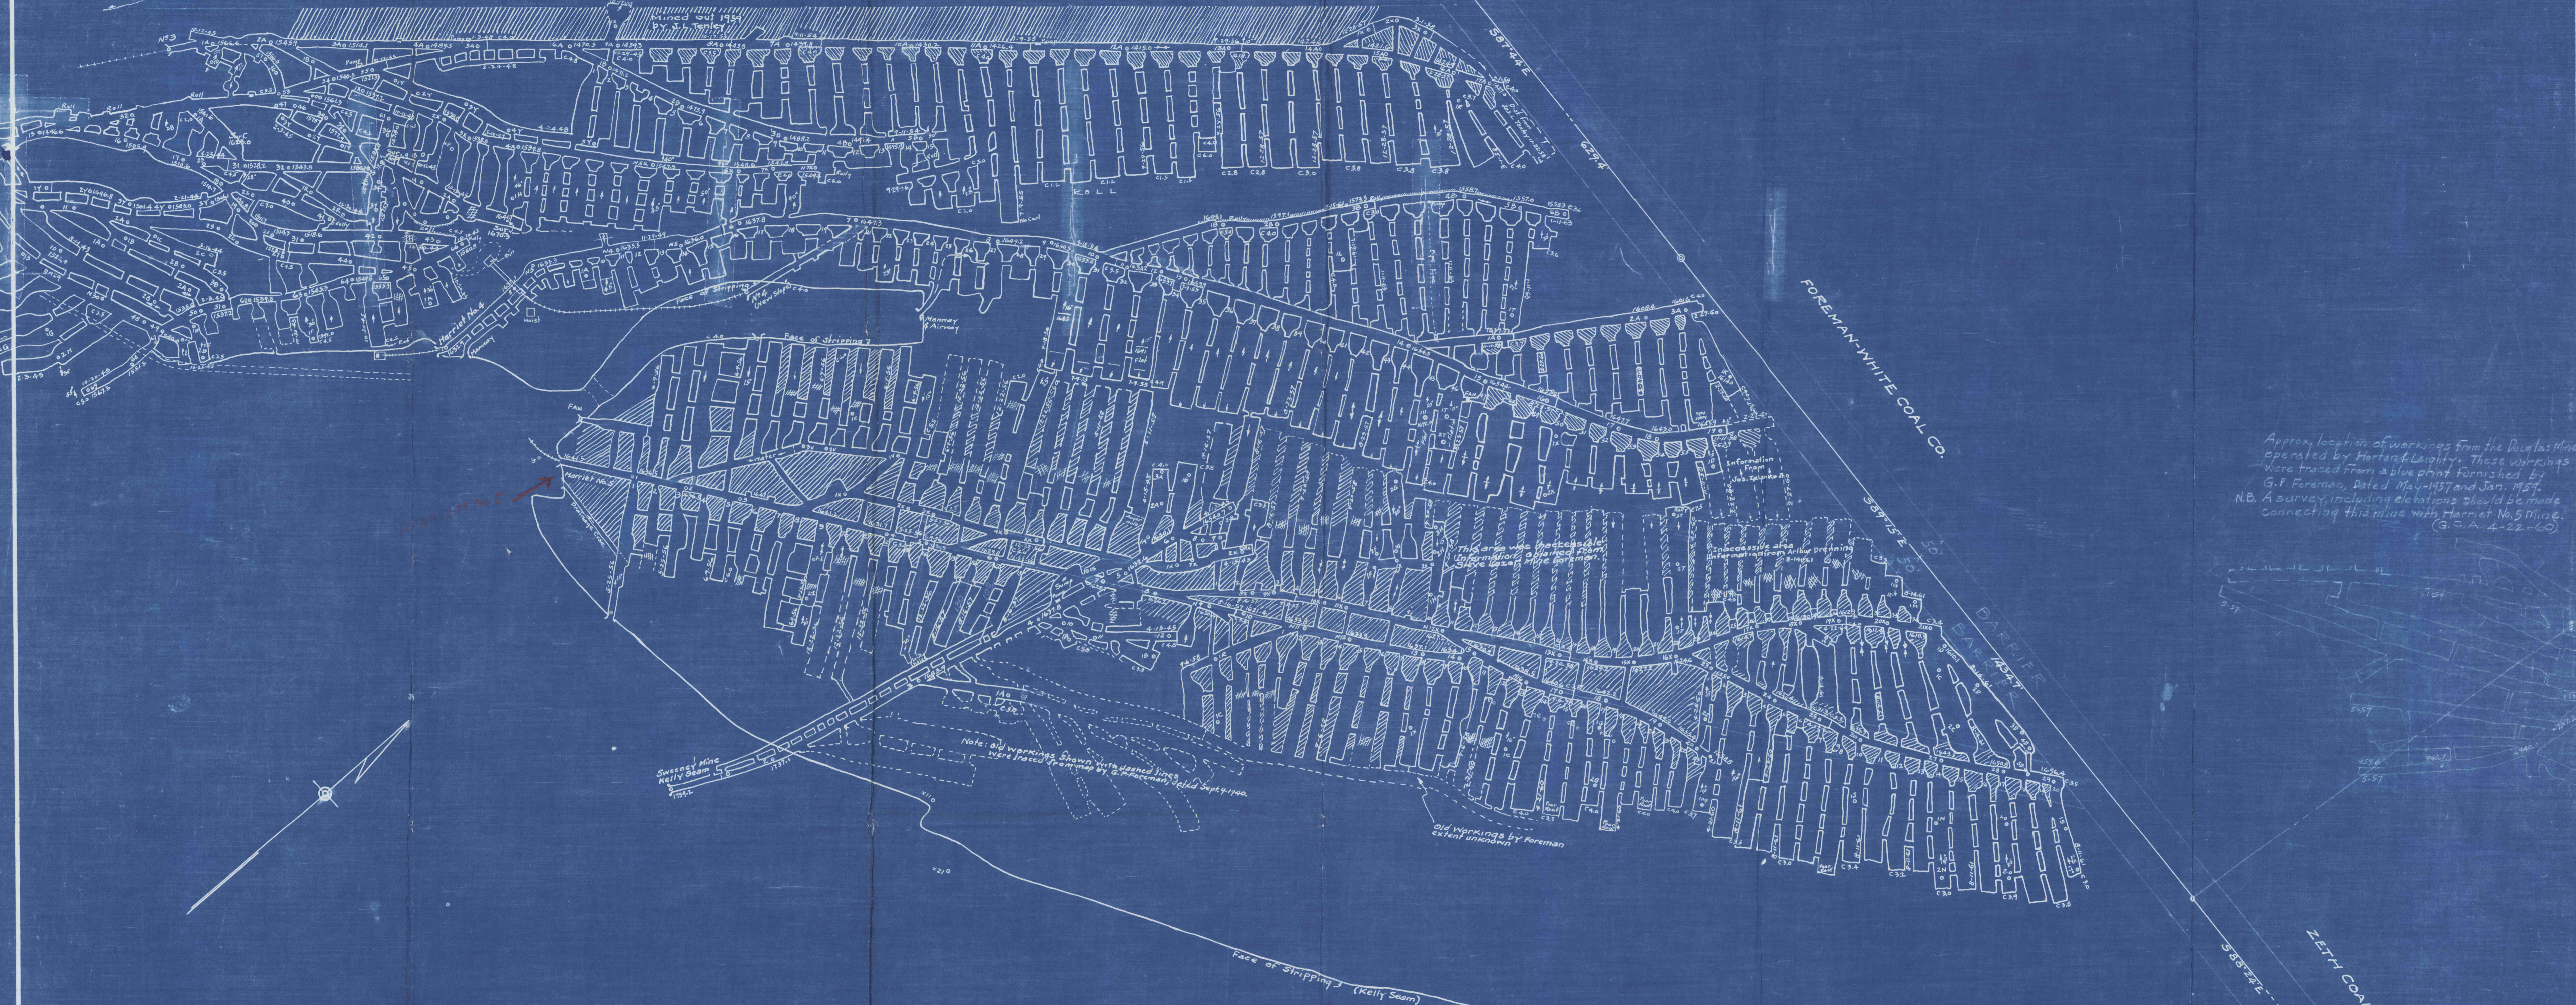

Approx. location of workings from the Douglas Mine
operated by Horton & Leighty. These workings
were traced from a blue print furnished by
G. P. Foreman, dated May-1957 and Jan. 1957.
N.B. A survey, including elevations should be made
connecting this mine with Harriet No. 5 Mine.
(G.S.A. 4-22-60)

HARRIET MINES


OWNED BY
J. H. SIMON & SON

BROADTOP TOWNSHIP - BEDFORD COUNTY

Scale: 1" = 100'

(KELLY SEAM)

Guy C. Askey, Min. Engr.
Bedford, Pa.

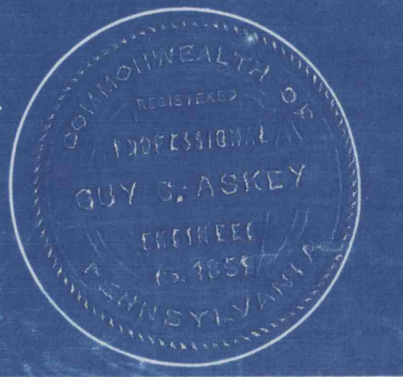

OPERATORS

- No. 3 MINE - J. L. TENLEY (completed 1959)
- No. 4 MINE - JOSEPH ZELANKO & SON
- No. 5 MINE - **ARK COAL CO.** (completed 1963)