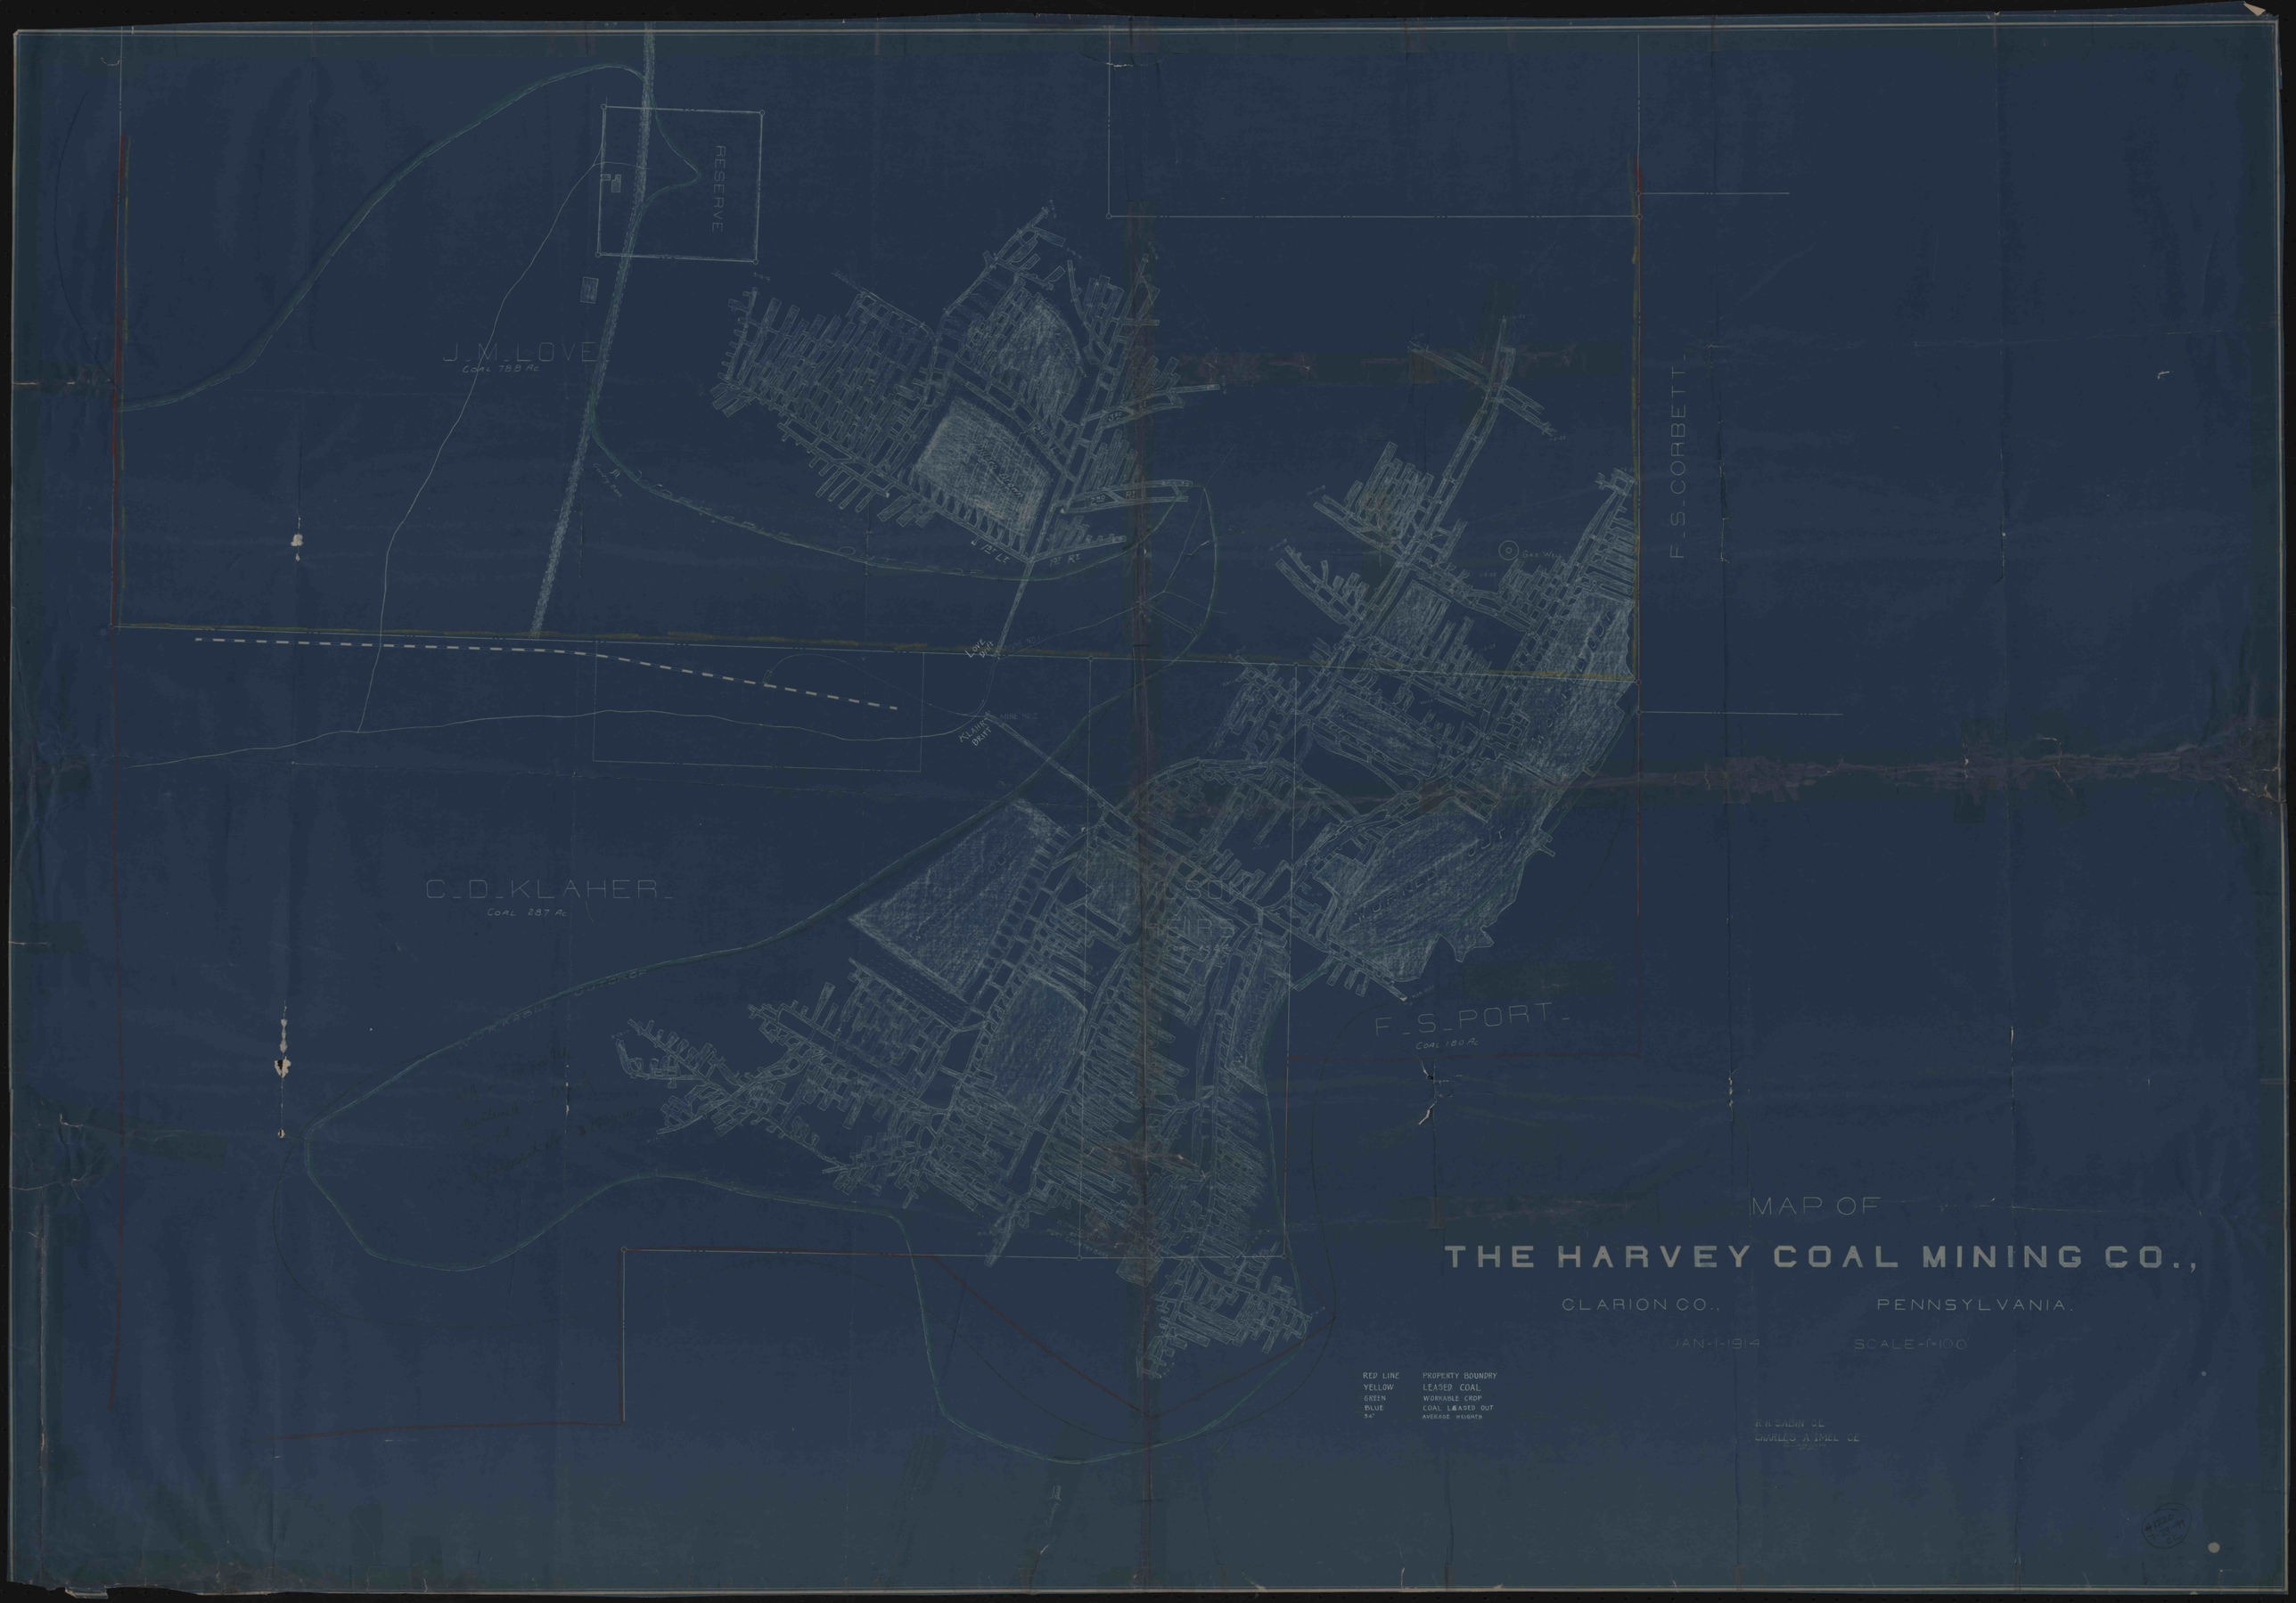
RESERVE
J.M.LOVE
Coal 788 Ac
F.S.CORBETT
C.D.KLAHER
Coal 287 Ac
F.S.PORT
Coal 180 Ac
MAP OF
THE HARVEY COAL MINING CO.,
CLARION CO., PENNSYLVANIA.
JAN-1-1914
SCALE-1"=100'
RED LINE PROPERTY BOUNDRY
YELLOW LEASED COAL
GREEN WORKABLE CROP
BLUE COAL LEASED OUT
34" AVERAGE HEIGHTS
R.H. SABIN CE
CHARLES A. IMEL CE