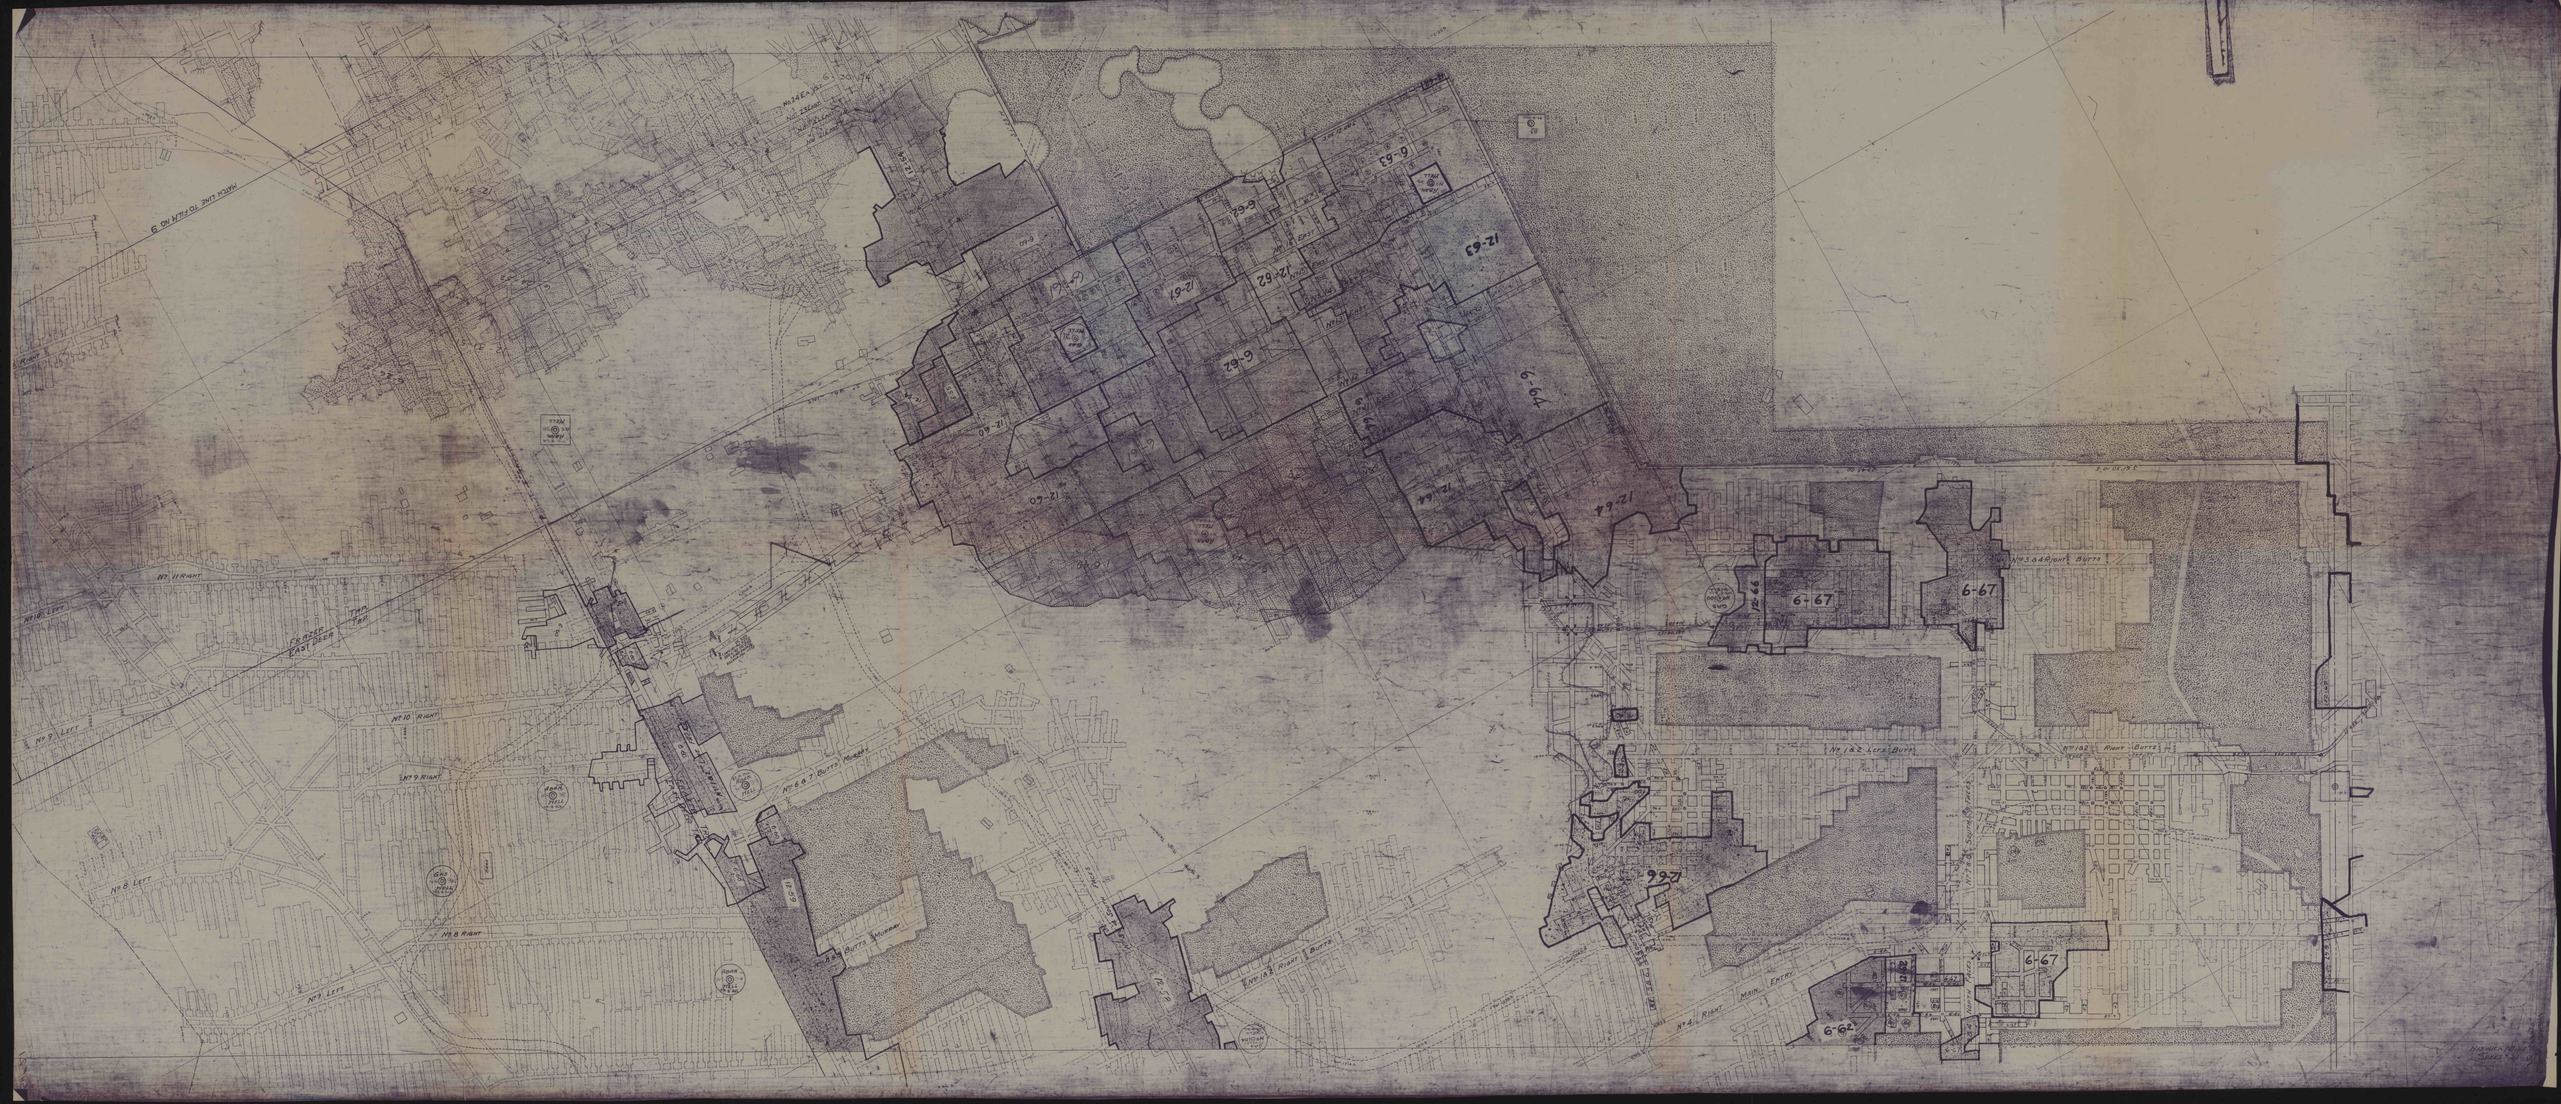

6-63
6-62
12-63
12-62
12-61
6-64
12-64
12-60
6-67
6-67
6-67
6-62
12-66
12-66
12-67
MATCH LINE TO FILM NO 9
FRAZER TWP
EAST DEER TWP
No 11 RIGHT
No 10 RIGHT
No 9 RIGHT
No 8 RIGHT
No 7 LEFT
No 6 & 7 BUTTS MURRAY
No 4 RIGHT MAIN ENTRY
No 3 & 4 RIGHT BUTTS
No 1 & 2 LEFT BUTTS
No 1 & 2 RIGHT BUTTS