



HARWICK MINE  
 INDIANA, FRAZIER, SPRINGDALE AND HARMAR TOWNSHIPS  
 ALLEGHENY COUNTY, PA.

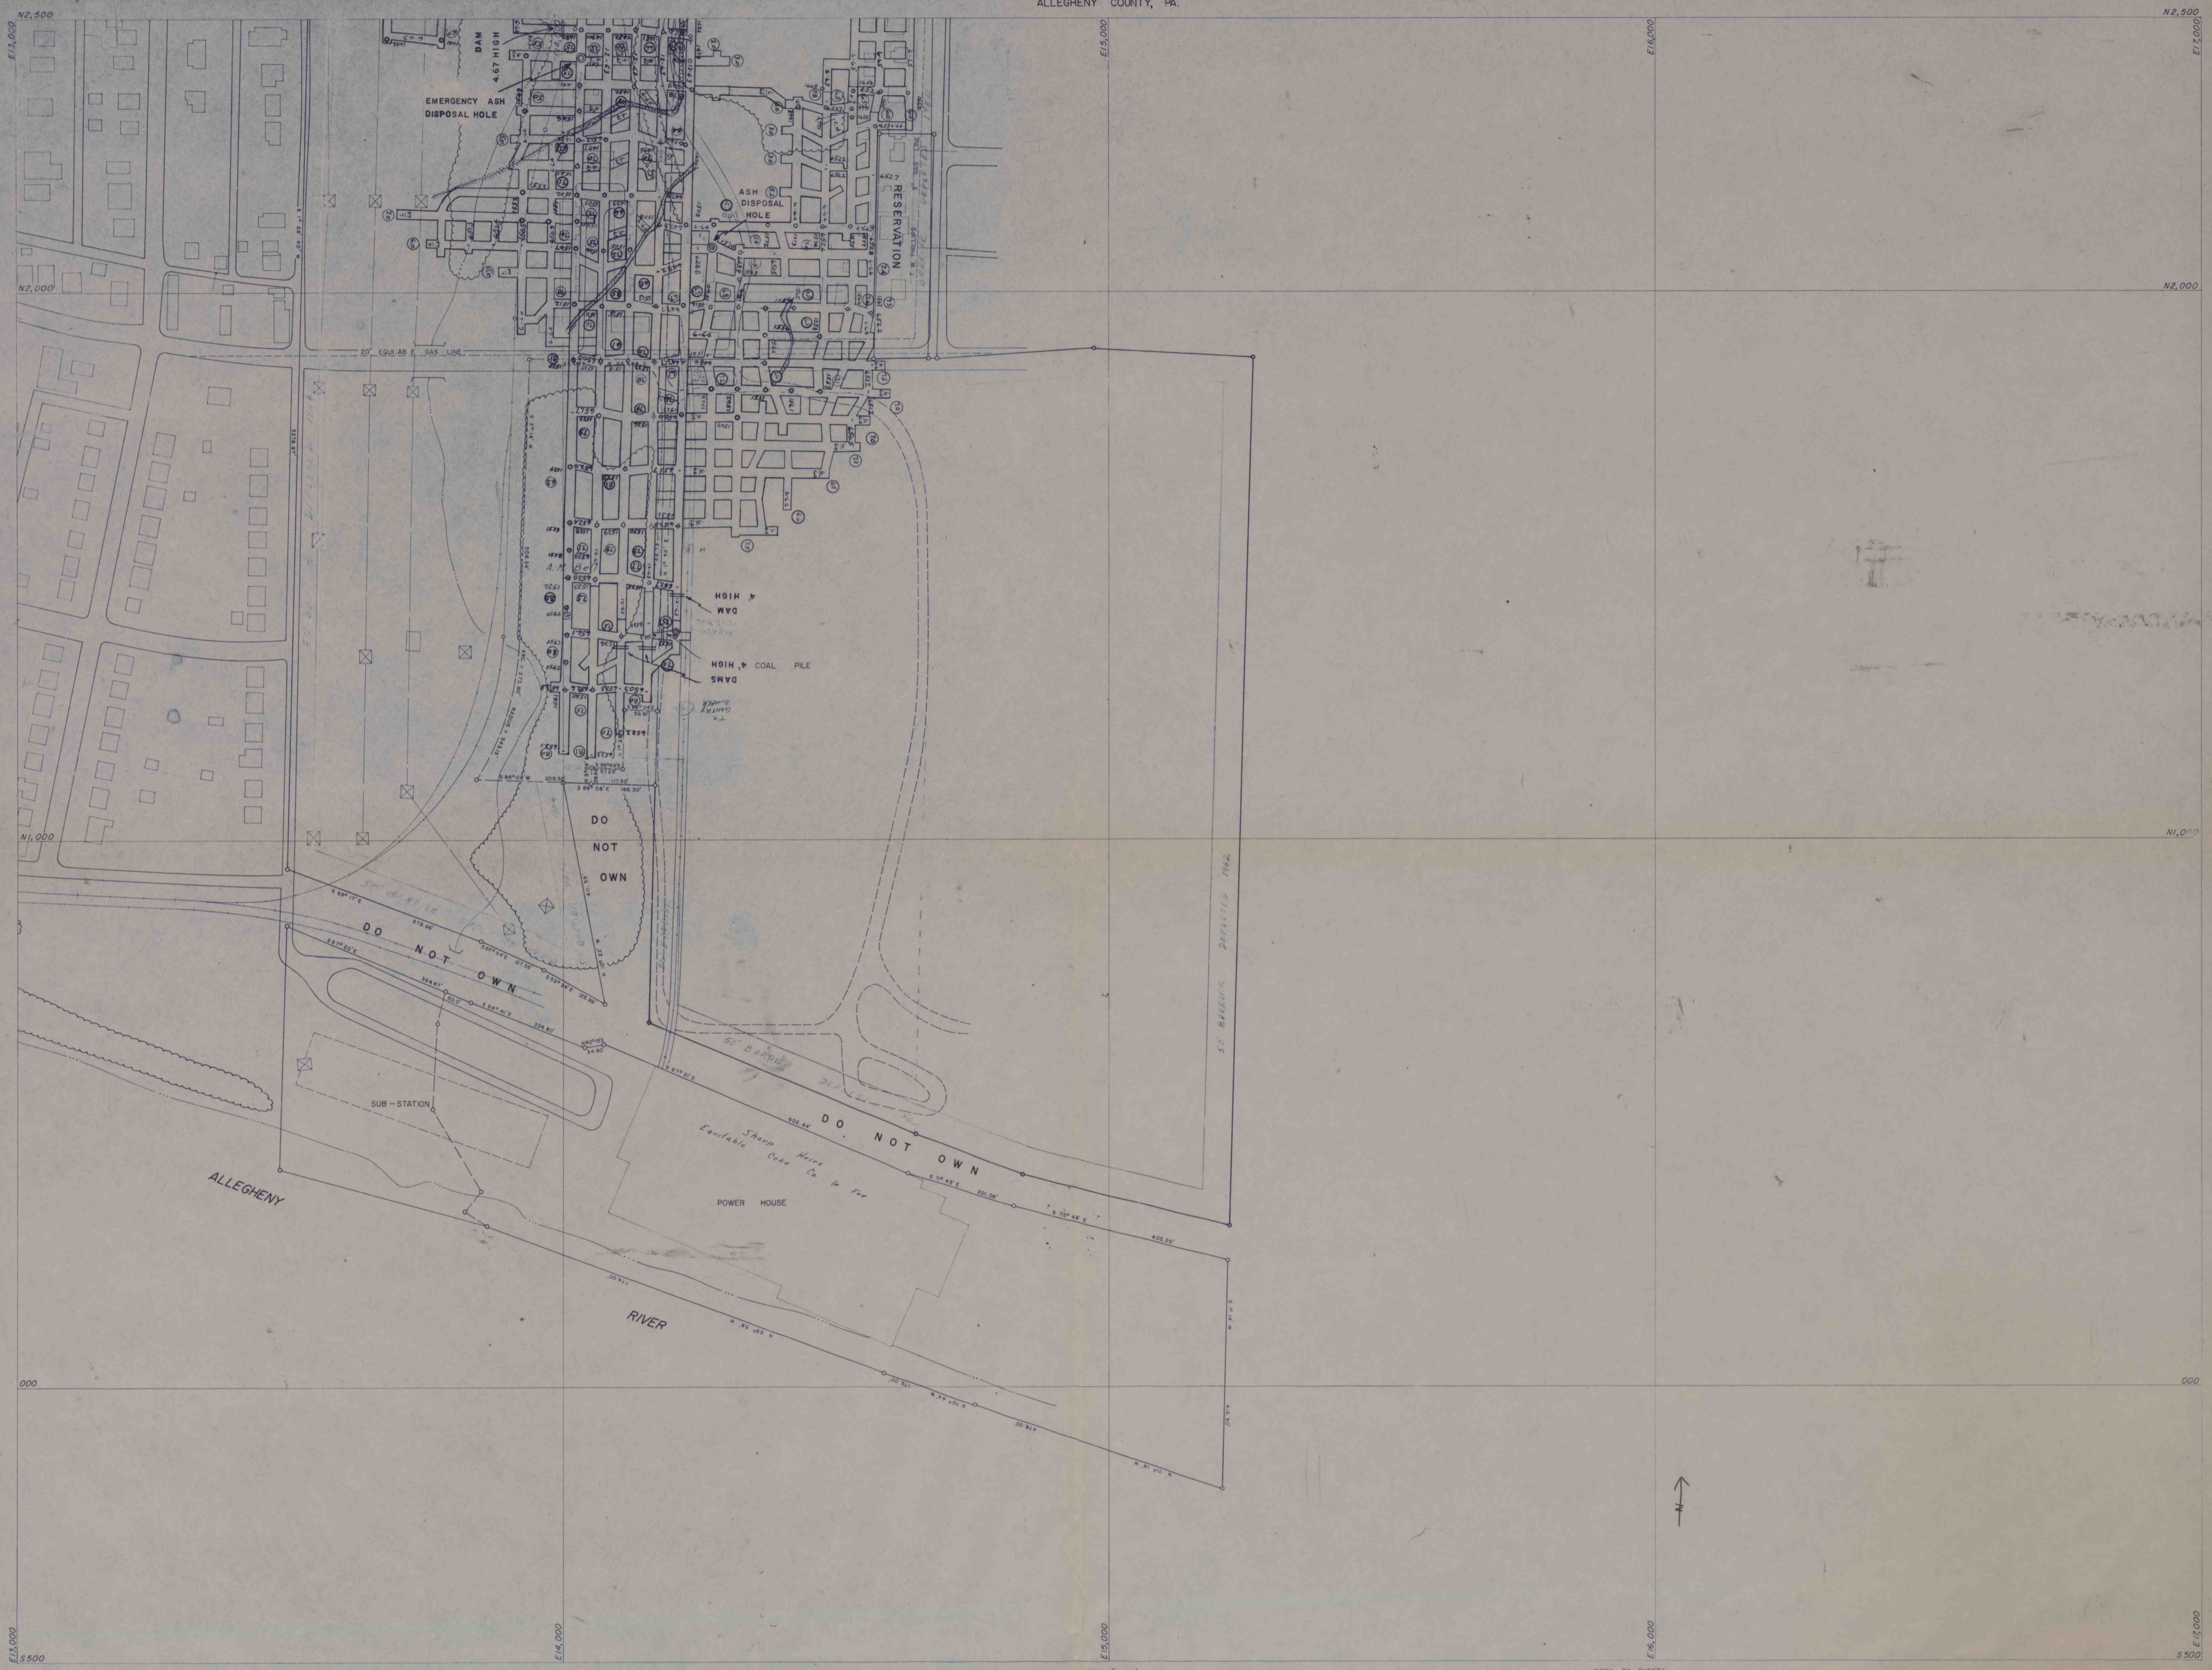

PREPARED BY  
 AMERICAN AIR SURVEYS, INC.  
 907 PENN. AVENUE  
 PITTSBURGH, PA.  
 DECEMBER, 1959

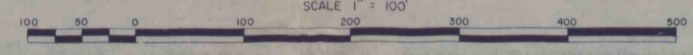

INDEX TO SHEETS

9	10
6	7
3	4
1	2

PREPARED FOR  
 DUQUESNE LIGHT COMPANY  
 COAL DEPARTMENT  
 435 SIXTH AVENUE  
 PITTSBURGH 19, PA.