


HARWICK MINE
 INDIANA, FRAZIER, SPRINGDALE AND HARMAR TOWNSHIPS
 ALLEGHENY COUNTY, PA.

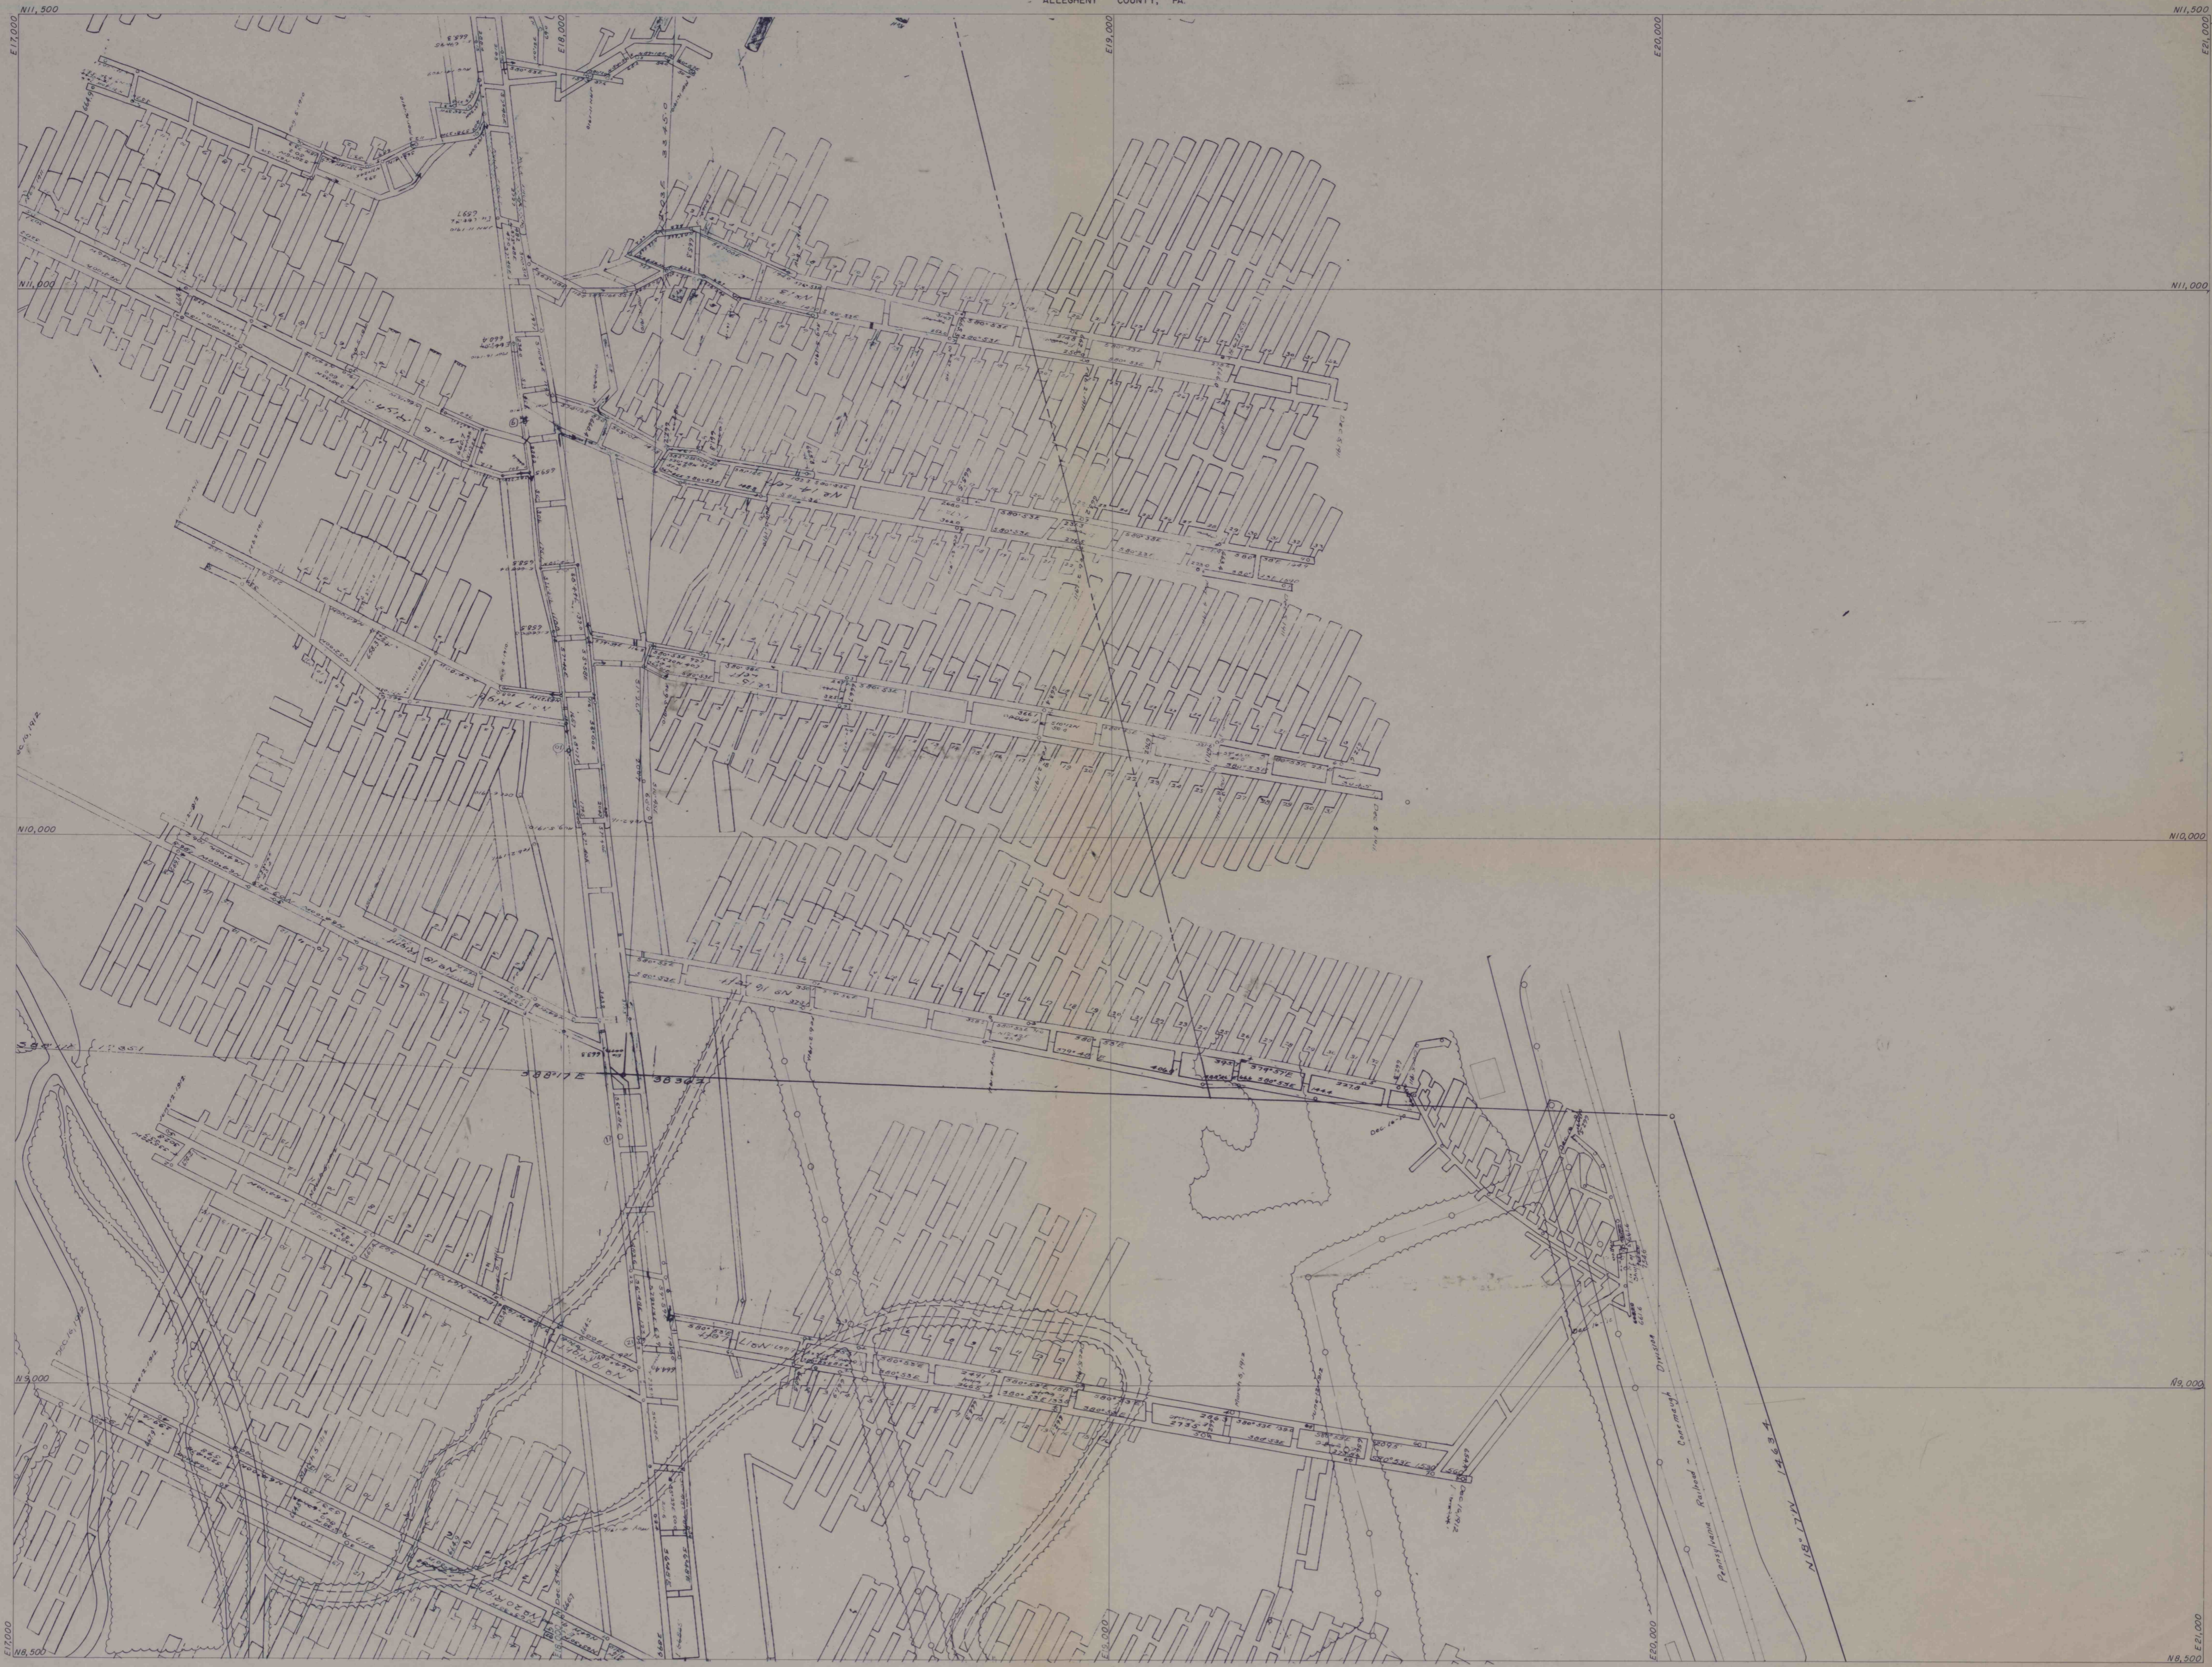

PREPARED BY
 AMERICAN AIR SURVEYS, INC.
 907 PENN AVENUE
 PITTSBURGH, PA.
 DECEMBER, 1959

SCALE 1" = 100'

INDEX TO SHEETS

9	10
6	7
3	4
1	2

PREPARED FOR
 DUQUESNE LIGHT COMPANY
 COAL DEPARTMENT
 435 SIXTH AVENUE
 PITTSBURGH 19, PA.