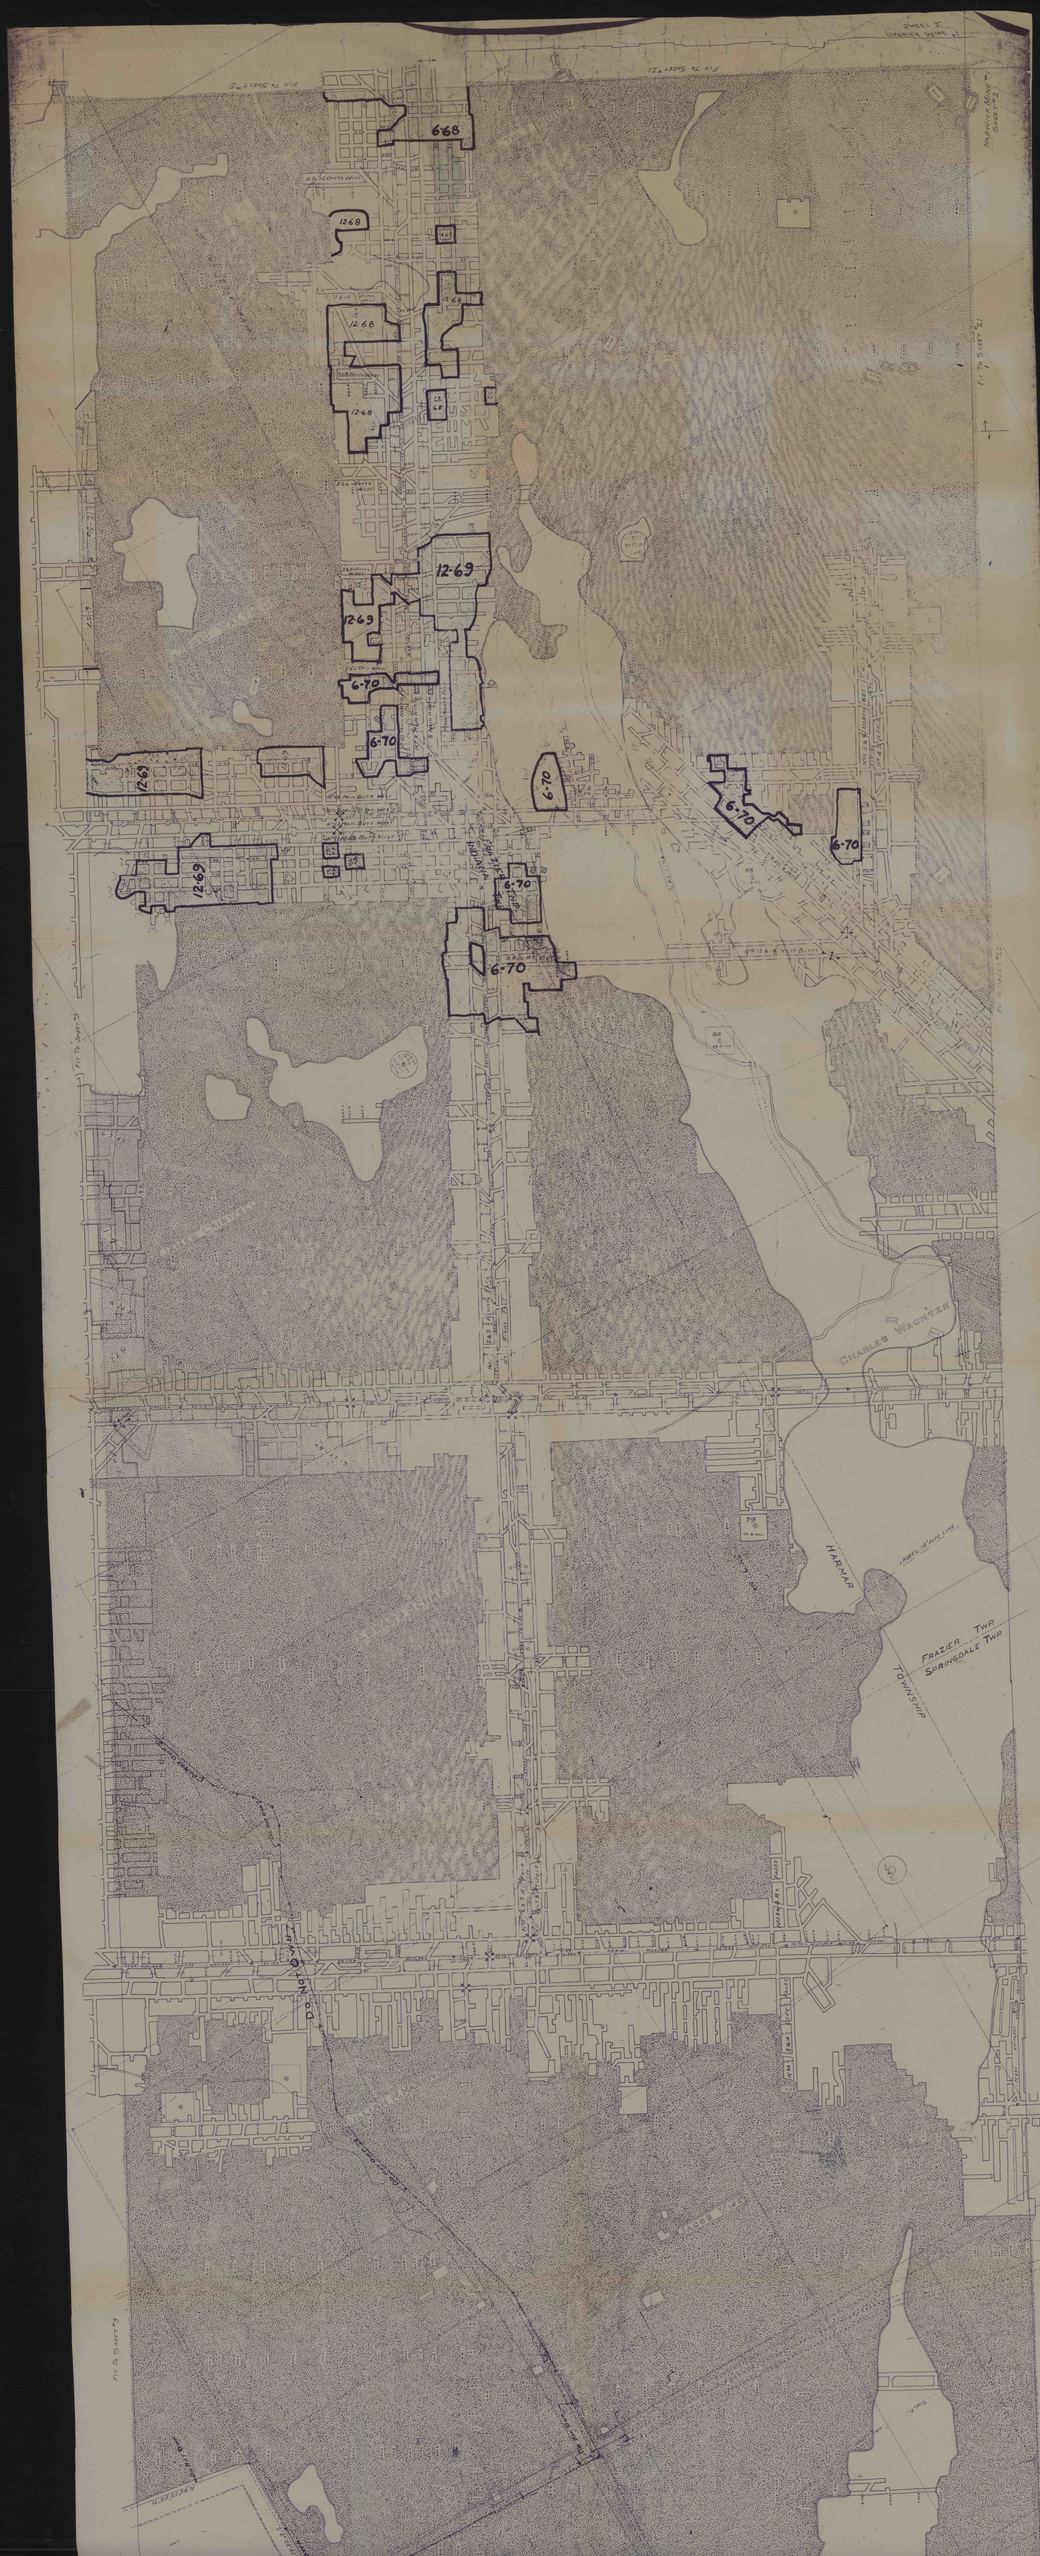
6-68
12-68
12-68
12-68
12-69
12-69
6-70
6-70
12-69
12-69
6-70
6-70
6-70
6-70
6-70
CHARLES MACKEYER
HARMAR
FRAZIER TWP
SPRINGDALE TWP
TOWNSHIP