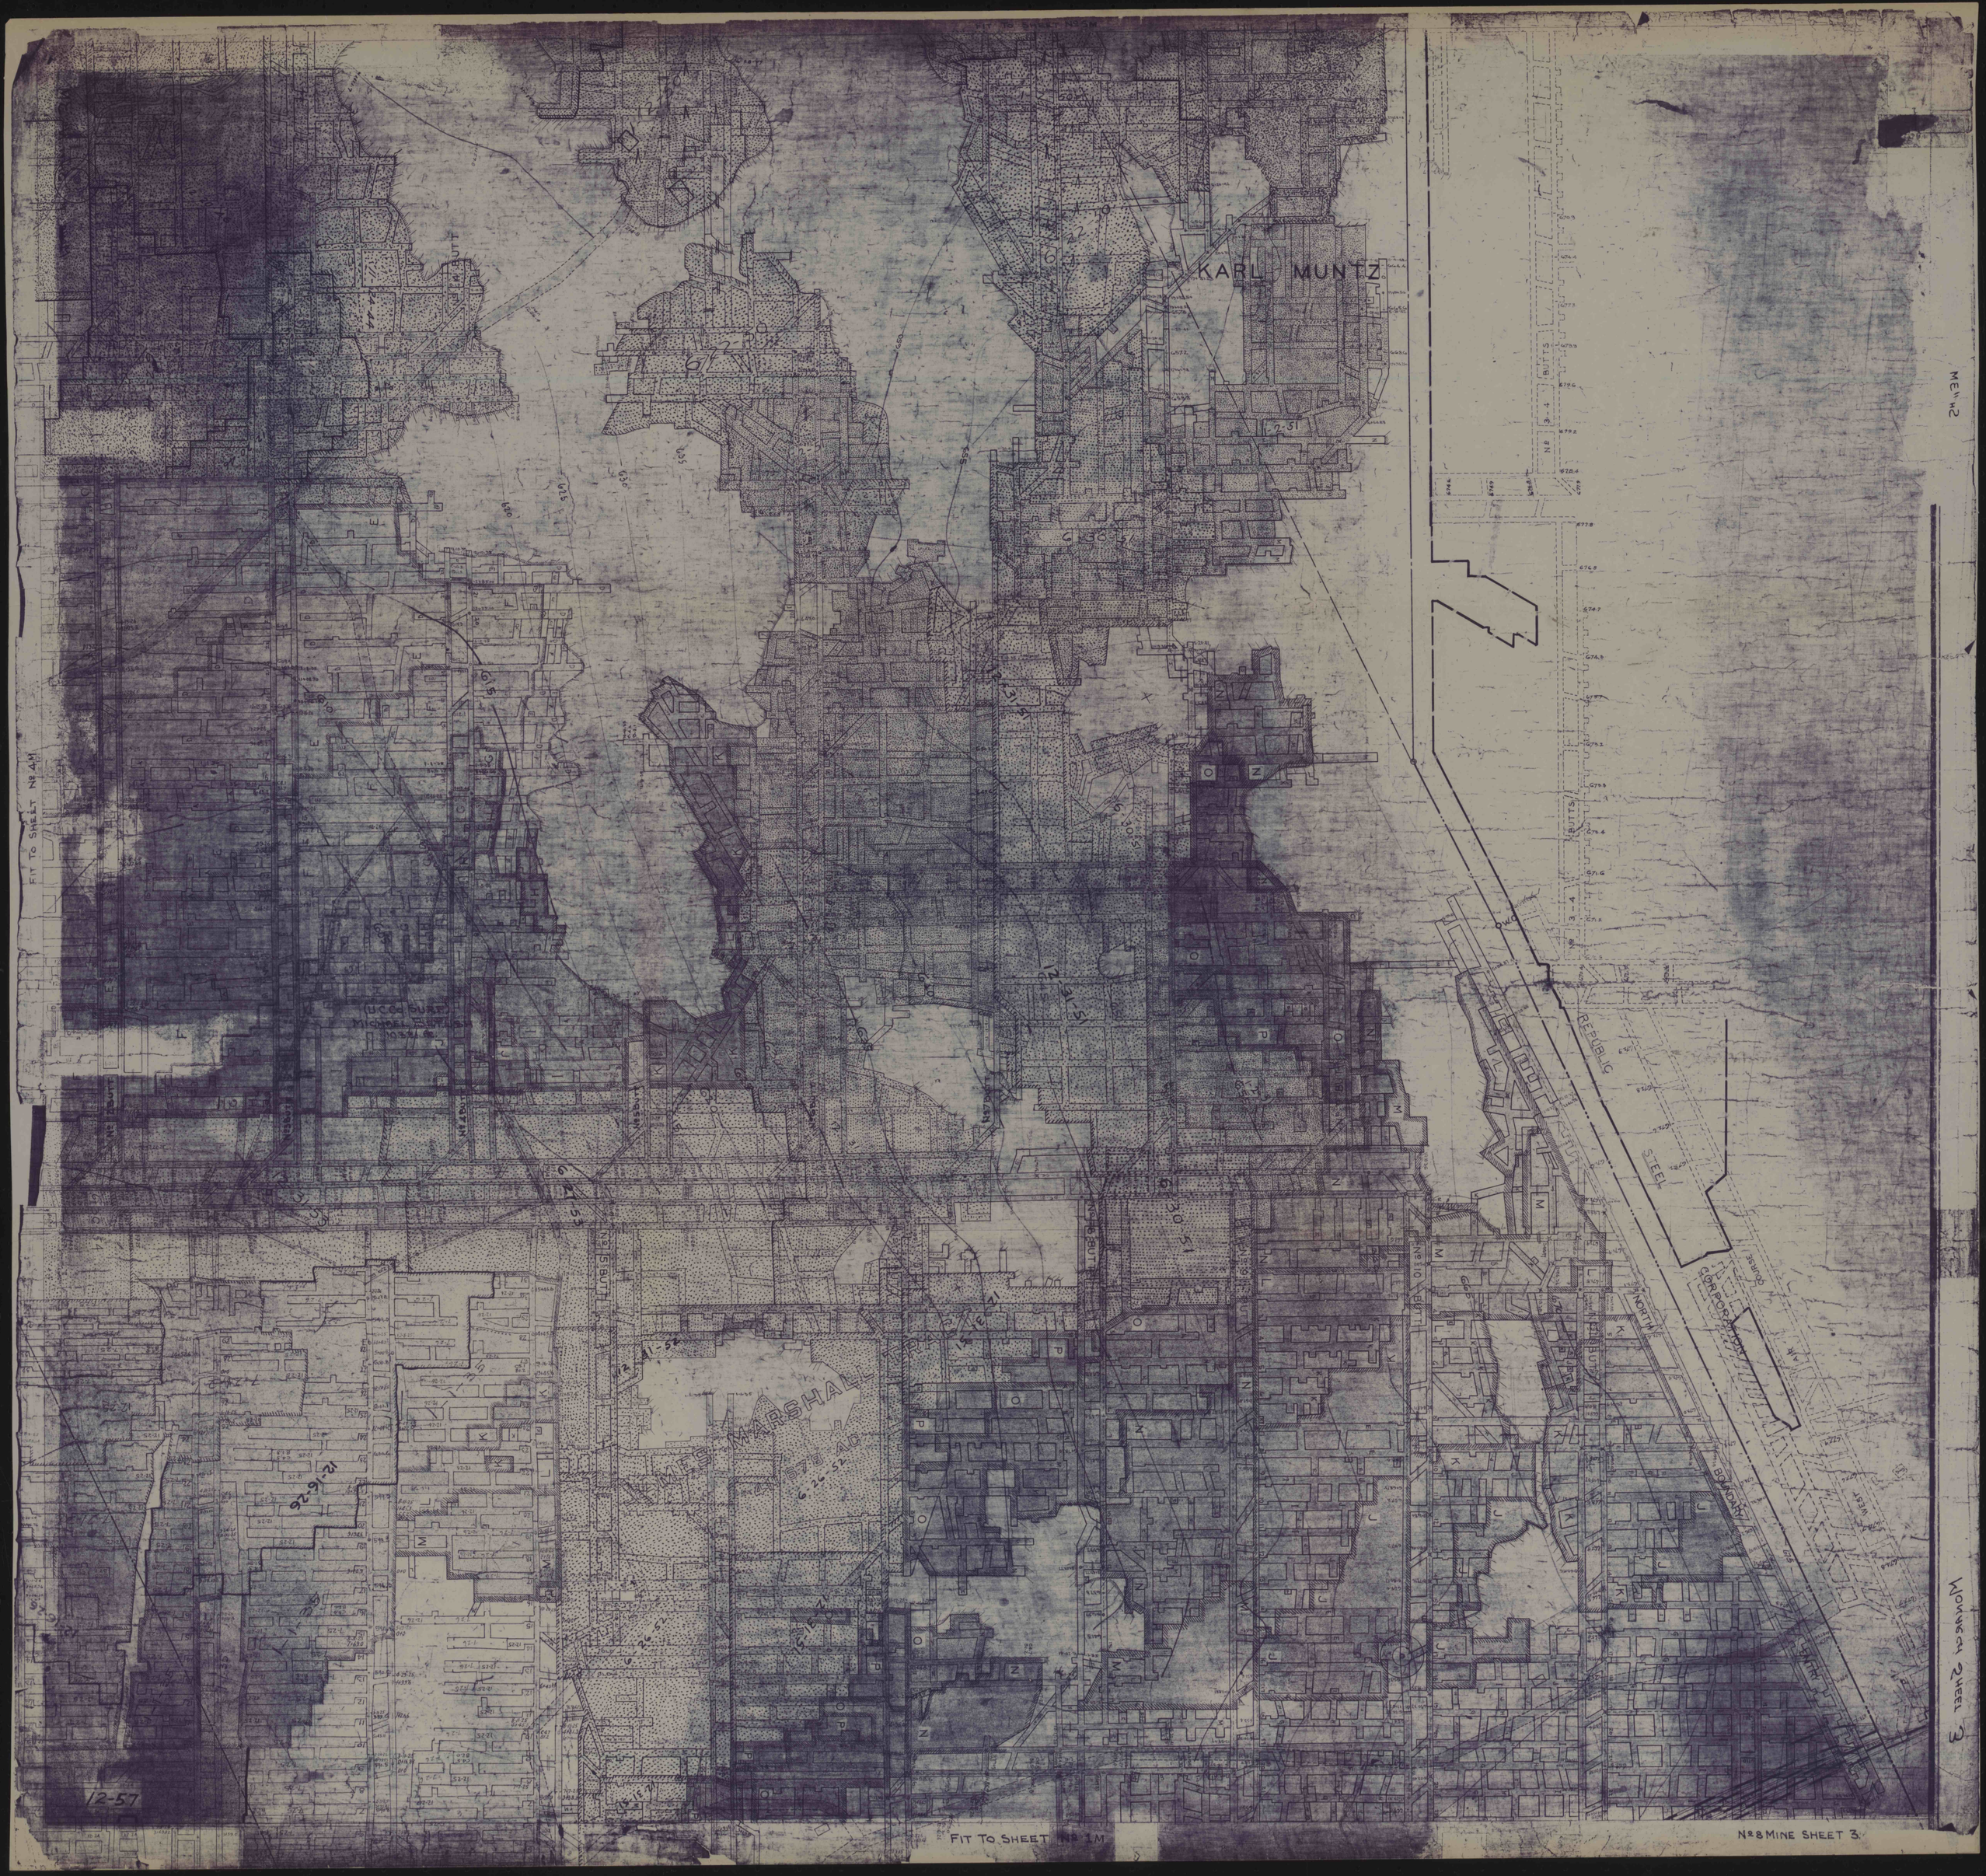
KARL MUNTZ
REPUBLIC STEEL
CORPORATION
NORTH BOUNDARY
MARSHALL
FIT TO SHEET No 4M
FIT TO SHEET No 1M
No 8 MINE SHEET 3.
12-57
12-16-26
6-26-52
12-31-51
6-30-51
6-22-50
6-27-53
6-30-51