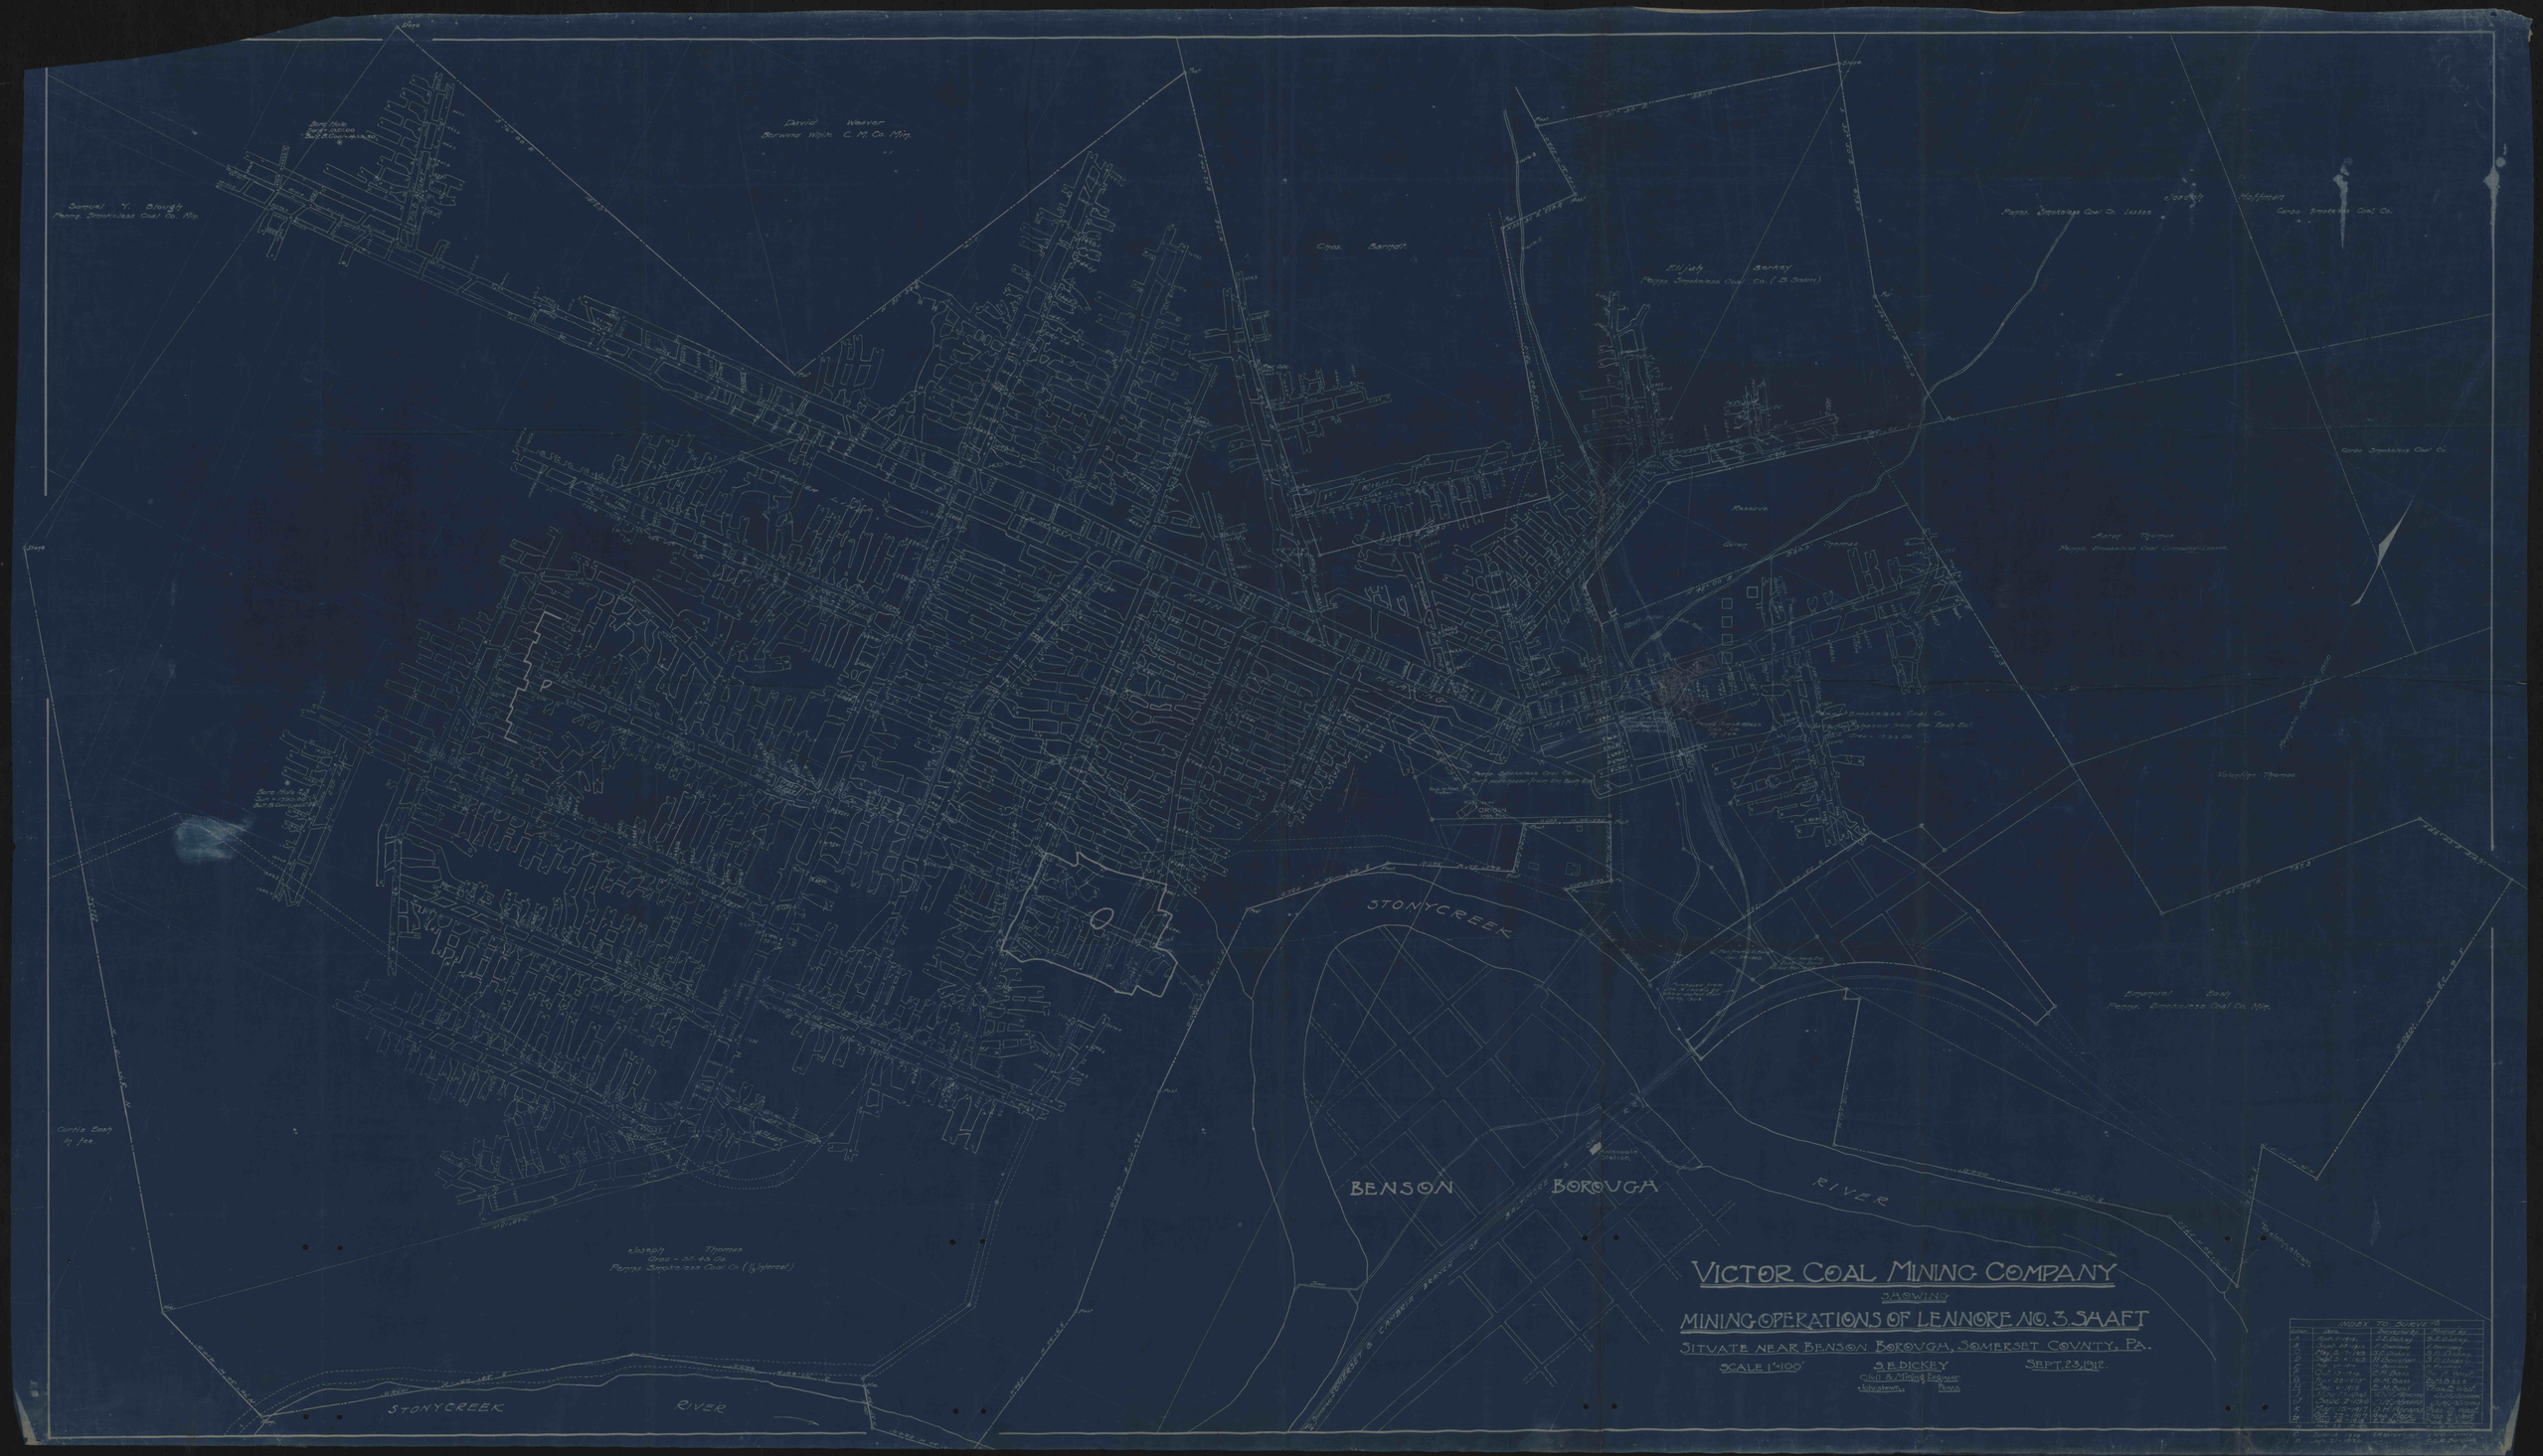

David Weaver
Berwind White C. M. Co. Min.
Samuel T. Blough
Penna. Smokeless Coal Co. Min.
Chas. Barndt
Elijah Berkey
Penna. Smokeless Coal Co. (B Seam)
Joseph Hoffman
Penna. Smokeless Coal Co. Lessee
Carbo Smokeless Coal Co.
Carbo Smokeless Coal Co.
Reserve
Aaron Thomas
Penna. Smokeless Coal Company Lessee
Valentine Thomas
Emanuel Eash
Penna. Smokeless Coal Co. Min.
Curtis Eash
In fee
Joseph Thomas
Penna. Smokeless Coal Co. (1/3 Interest)
STONYCREEK
RIVER
BENSON
BOROUGH
STONYCREEK
RIVER
VICTOR COAL MINING COMPANY
SHOWING
MINING OPERATIONS OF LENNORE NO. 3 SHAFT
SITUATE NEAR BENSON BOROUGH, SOMERSET COUNTY, PA.
SCALE 1"=100'
S. E. DICKEY
Civil & Mining Engineer
Johnstown, Penna.
SEPT. 23, 1912.
INDEX TO SURVEYS