


HAZEL MINE
SCALE 1"=100'
LAST MEAS. 1/200'



Pittsburgh Coal Co.

Pittsburgh Coal Co. Engineers

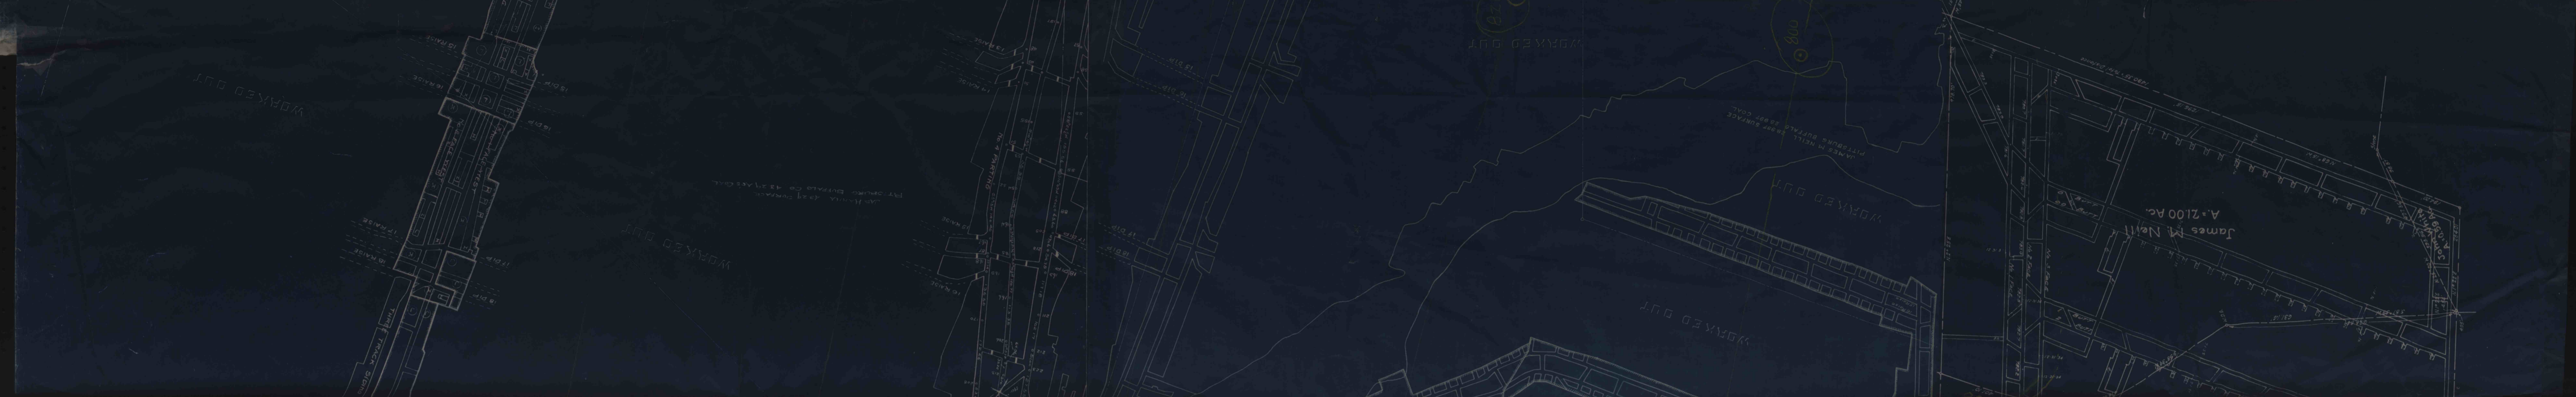

James M. Neff
A. 2100 Ac.