


Handwritten notes on a piece of aged paper at the top left, including a table with numbers and some illegible text.

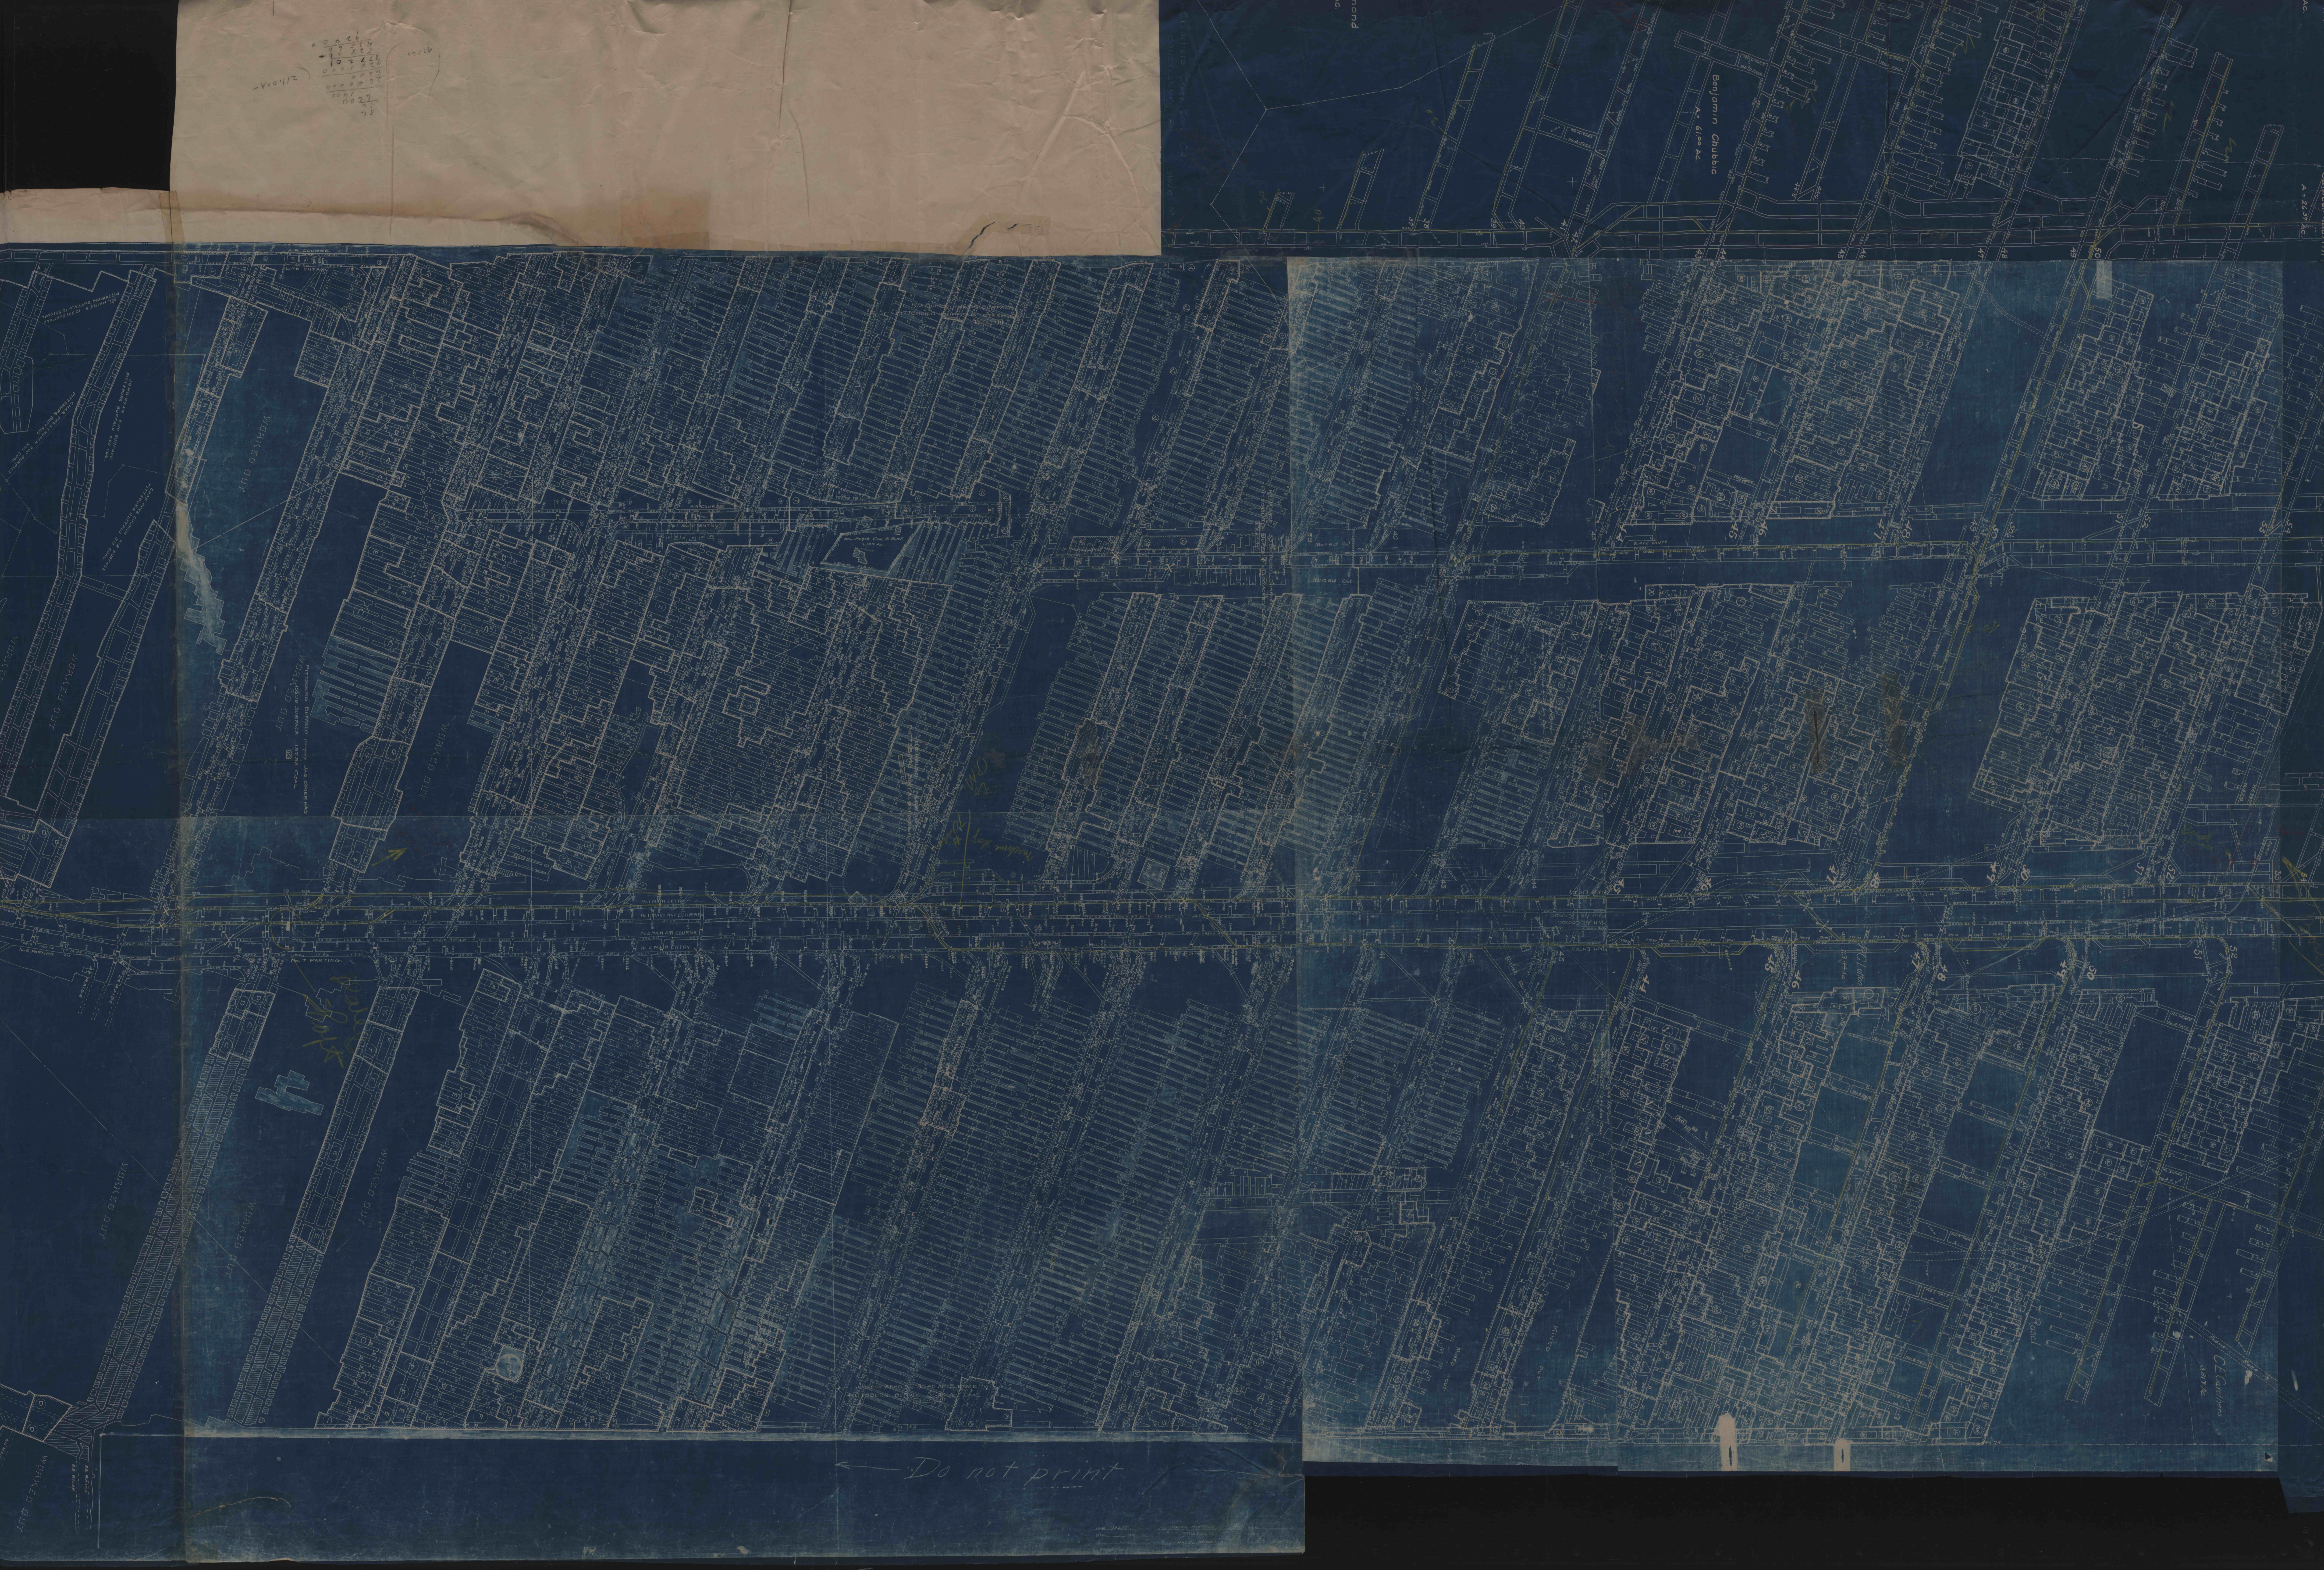

Do not print