


PETER STINEMAN -

FT TO 42

BRINKERTON  
HECLA NO 1 - NO 3

41

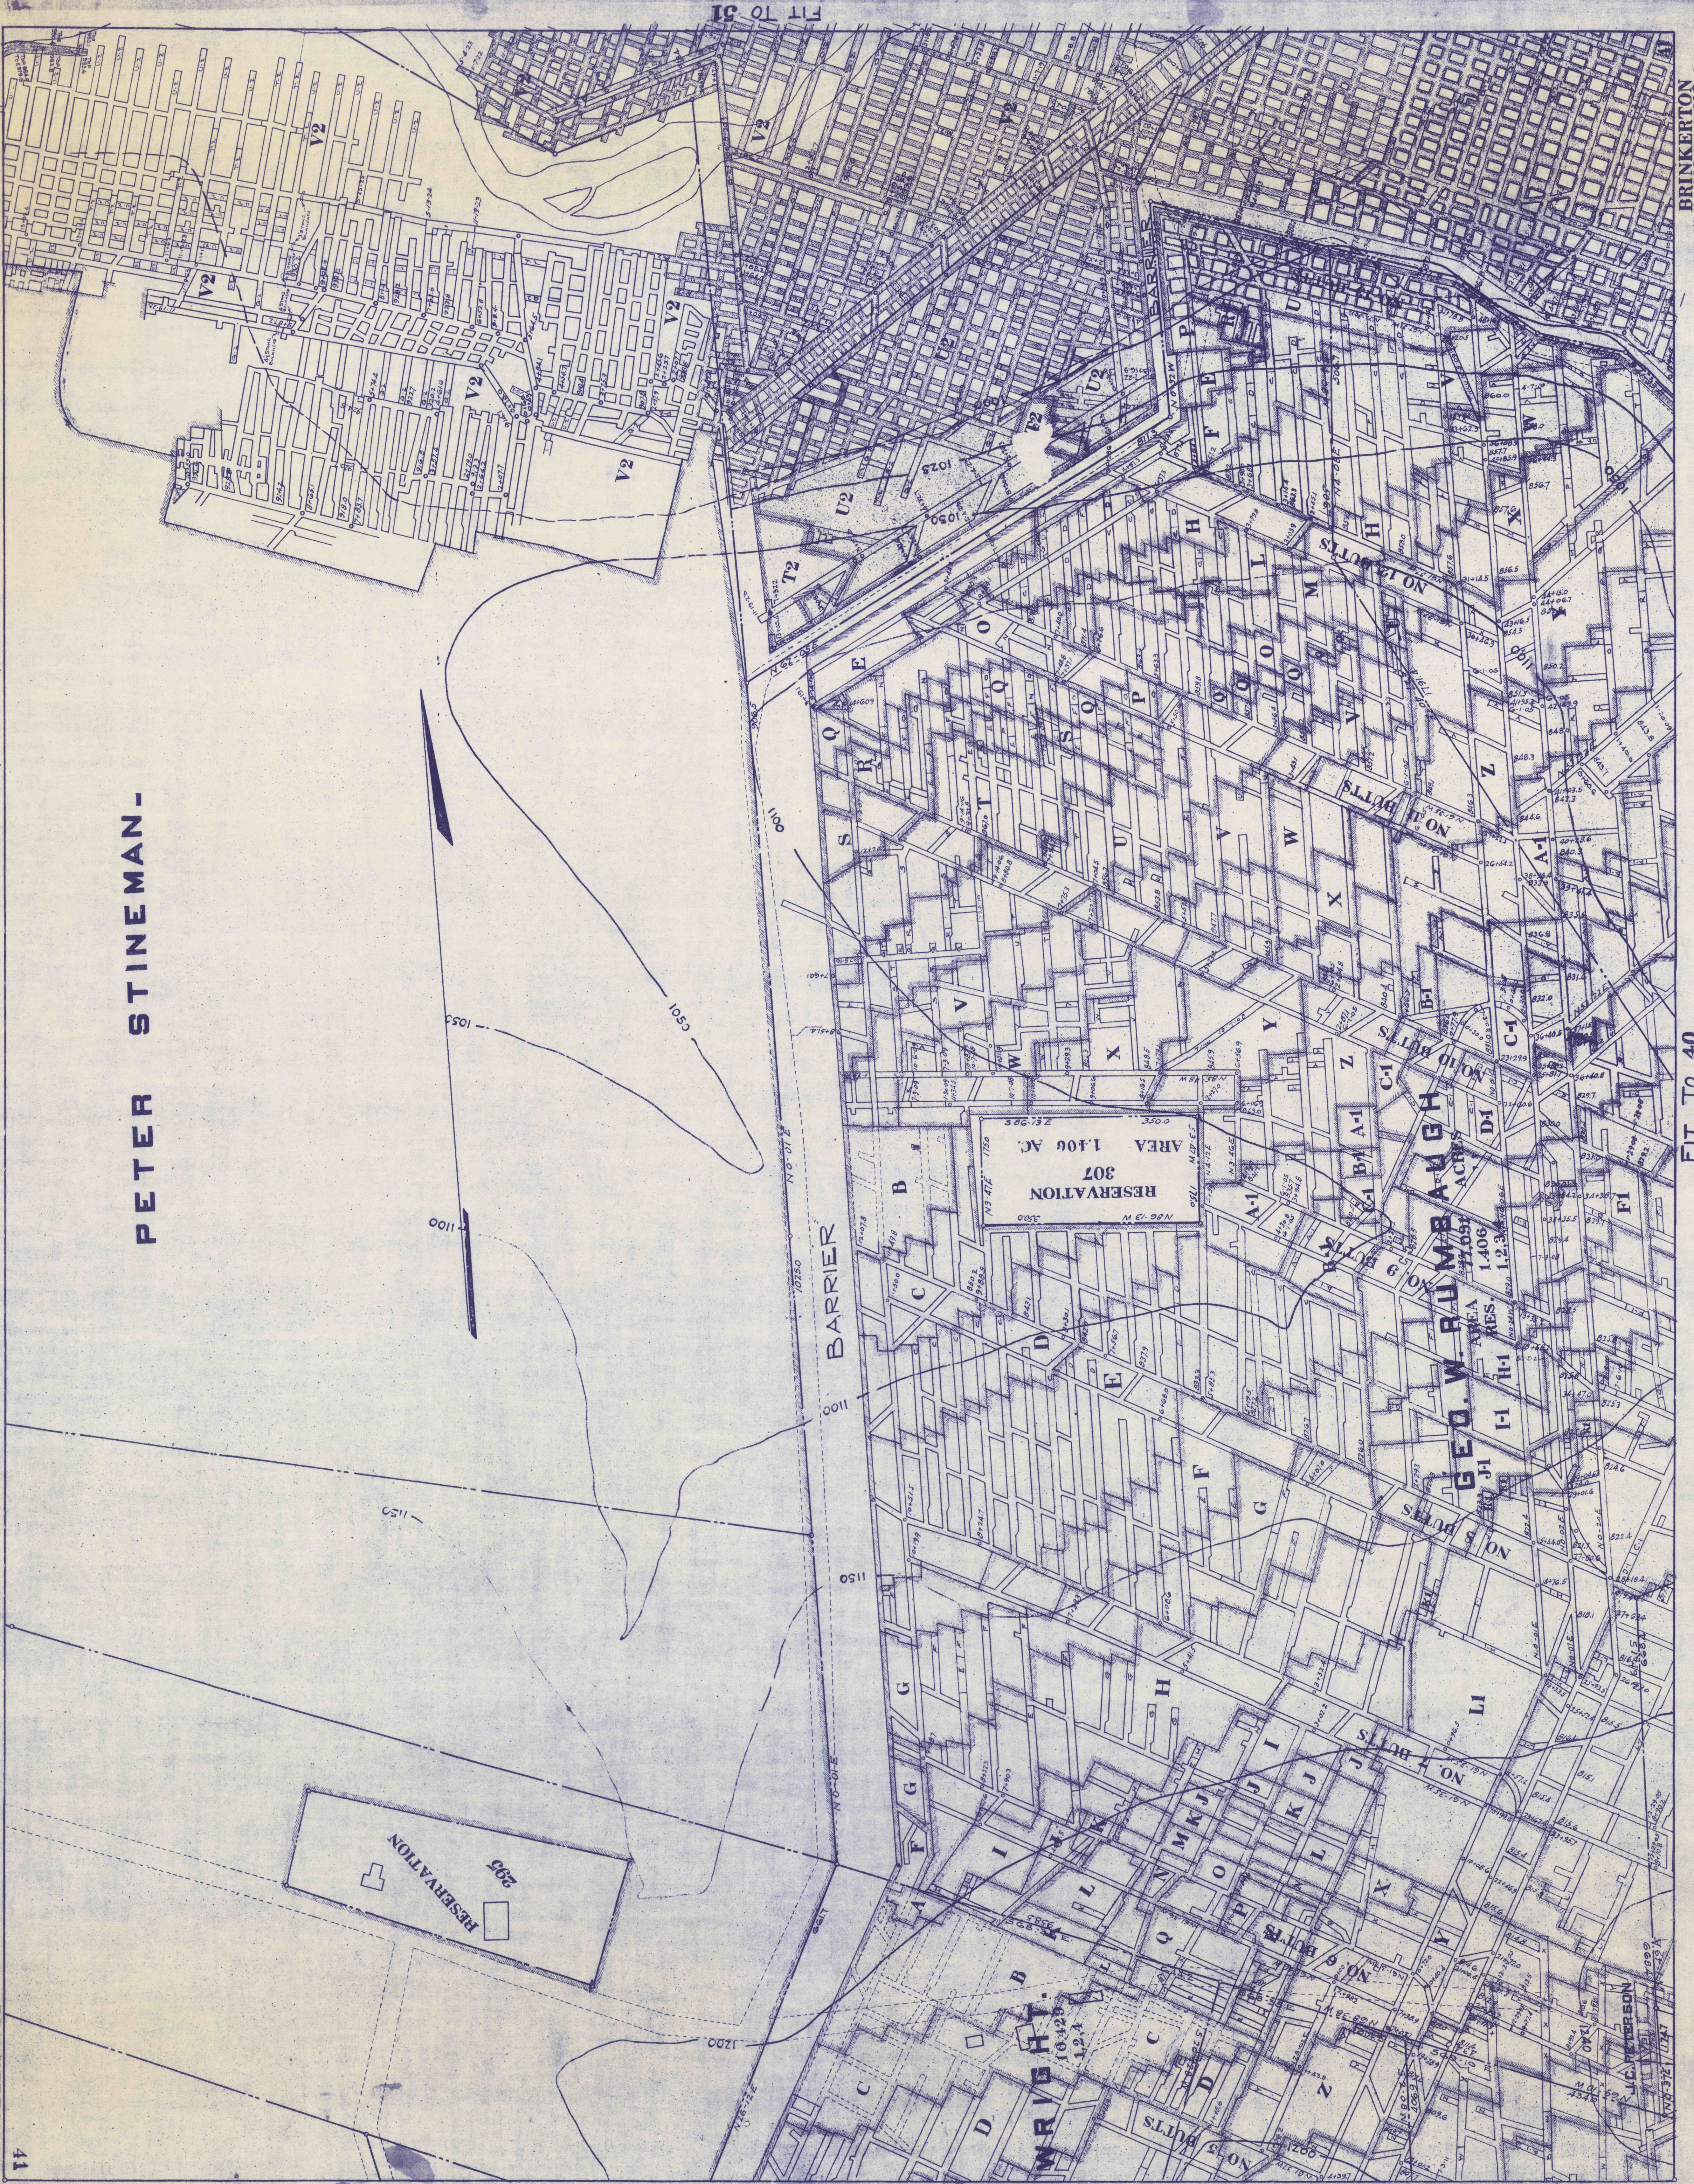

FT TO 30

FT TO 40

BRINKERTON  
HECLA NO 1 & NO 3