



# HECLA NO. 2 MINE


OF THE

## W. C. FRICK COKE CO.

MT. PLEASANT & UNITY TWP. - WESTMORELAND CO. - PA.

DATUM OF LEVELS 16.1 FT. BELOW MEAN TIDE AT SANDY HOOK

SCALE 1"=100'

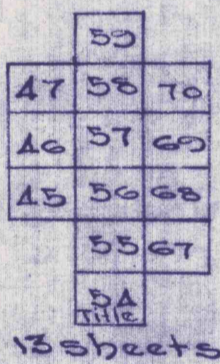

### DATE OF SURVEYS

| DATE     | Letter | W.S.   | W.F.S. | W.R.S.     | DATE    | Letter | W.S.   | W.F.S. | W.R.S.       | DATE    | Letter | W.S.   | W.F.S. | W.R.S.     |
|----------|--------|--------|--------|------------|---------|--------|--------|--------|--------------|---------|--------|--------|--------|------------|
| 12-27-05 | A      | W.F.S. | W.F.S. | W.F.S.     | 7-1-17  | A-1    | W.S.   | W.F.S. | W.F.S.       | 1-10-23 | A-2    | L.R.E. | L.R.E. | Joint Sur. |
| 3-7-06   | B      | W.F.S. | J.H.H. | W.F.S.     | 10-1-17 | S-1    | R.C.C. | R.C.C. |              | 7-16-23 | B-2    | F.E.D. | F.E.D. |            |
| 7-3-06   | C      | W.F.S. | J.H.H. | W.F.S.     | 1-15-13 | C-1    | W.F.F. | W.F.F. | Joint Sur.   | 1-12-24 | C-2    | L.R.E. | L.R.E. | Joint Sur. |
| 3-26-06  | D      | W.F.S. | J.H.H. | W.F.S.     | 4-1-13  | D-1    | W.F.F. | W.F.F. |              | 7-17-24 | D-2    | F.E.D. | F.E.D. |            |
| 17-31-06 | E      | W.F.S. | J.H.H. | W.F.S.     | 7-2-13  | E-1    | W.F.S. | W.F.S. |              | 1-9-25  | E-2    | L.R.E. | L.R.E. | Joint Sur. |
| 3-21-07  | F      | W.F.S. | W.F.S. | W.F.S.     | 10-1-13 | F-1    | W.F.S. | W.F.S. |              | 4-4-25  | F-2    | L.R.E. | L.R.E. | Joint Sur. |
| 7-8-07   | G      | W.F.S. | W.F.S. | W.F.S.     | 1-21-14 | G-1    | W.F.S. | W.F.S. | Joint Sur.   |         |        |        |        |            |
| 8-26-07  | H      | W.F.S. | W.F.S. | W.F.S.     | 3-21-14 | H-1    | W.F.S. | W.F.S. |              |         |        |        |        |            |
| 1-17-08  | I      | M.A.B. | M.A.B. | Joint Sur. | 7-3-14  | I-1    | W.F.S. | W.F.S. |              |         |        |        |        |            |
| 2-21-08  | J      | M.A.B. | M.A.B. |            | 10-1-14 | J-1    | E.C.B. | E.C.B. |              |         |        |        |        |            |
| 7-3-08   | K      | W.F.S. | W.F.S. |            | 1-13-15 | K-1    | W.F.S. | W.F.S. | Joint Sur.   |         |        |        |        |            |
| 10-1-08  | L      | R.C.C. | R.C.C. |            | 7-12-15 | L-1    | W.F.S. | W.F.S. | Joint Sur.   |         |        |        |        |            |
| 1-13-09  | M      | W.F.S. | W.F.S. | Joint Sur. | 1-13-16 | M-1    | R.C.C. | R.C.C. | Joint Sur.   |         |        |        |        |            |
| 3-30-09  | N      | M.A.B. | M.A.B. |            | 7-7-16  | N-1    | R.C.C. | R.C.C. |              |         |        |        |        |            |
| 8-20-09  | O      | W.F.S. | W.F.S. |            | 7-12-17 | O-1    | W.F.S. | W.F.S. | Joint Sur.   |         |        |        |        |            |
| 9-30-09  | P      | M.A.B. | M.A.B. |            | 7-12-17 | P-1    | R.C.C. | L.R.E. |              |         |        |        |        |            |
| 1-15-10  | Q      | W.F.S. | W.F.S. | Joint Sur. | 1-11-18 | Q-1    | J.W.S. | L.R.E. | Joint Survey |         |        |        |        |            |
| 4-4-10   | R      | R.C.C. | R.C.C. |            | 7-9-18  | R-1    | H.O.S. | H.O.S. |              |         |        |        |        |            |
| 7-1-10   | S      | W.F.S. | W.F.S. |            | 1-15-19 | S-1    | R.C.C. | R.C.C. | Joint Survey |         |        |        |        |            |
| 10-7-10  | T      | W.F.S. | W.F.S. |            | 7-11-10 | T-1    | L.R.E. | L.R.E. |              |         |        |        |        |            |
| 12-30-10 | U      | W.F.S. | W.F.S. | Joint Sur. | 1-12-20 | U-1    | R.C.C. | R.C.C. | Joint Survey |         |        |        |        |            |
| 3-3-11   | V      | W.F.S. | W.F.S. |            | 7-2-20  | V-1    | F.E.D. | F.E.D. |              |         |        |        |        |            |
| 7-3-11   | W      | W.F.S. | W.F.S. |            | 1-8-21  | W-1    | L.R.E. | L.R.E. | Joint Survey |         |        |        |        |            |
| 8-30-11  | X      | W.F.S. | W.F.S. |            | 5-21-21 | X-1    | R.C.C. | S.S.H. |              |         |        |        |        |            |
| 1-18-12  | Y      | W.F.S. | W.F.S. | Joint Sur. | 1-6-22  | Y-1    | L.R.E. | L.R.E. | Joint Sur.   |         |        |        |        |            |
| 3-3-12   | Z      | R.C.C. | R.C.C. |            | 7-3-22  | Z-1    | L.R.E. | L.R.E. |              |         |        |        |        |            |

CLARE COKE CO. MINE

THIS IS TO CERTIFY THAT THIS IS A TRUE AND CORRECT COPY OF THE ORIGINAL MAP OF HECLA #2 MINE AND THAT THE ORIGINAL MAP IS A TRUE COMPLETE AND CORRECT MAP AND SURVEY OF ALL EXCAVATIONS MADE IN HECLA #2 MINE WHICH HAS NOW BEEN ABANDONED

DATED April 13/12 H.C. FRICK COKE COMPANY  
Thomas W. Dawson, CHIEF ENGINEER

STATE OF PENNSYLVANIA }  
COUNTY OF WESTMORELAND } SS:

BEFORE ME, A NOTARY PUBLIC, IN AND FOR SAID COUNTY AND STATE PERSONALLY APPEARED THOMAS W. DAWSON, CHIEF ENGINEER OF THE H.C. FRICK COKE COMPANY, WHO, BEING DULY SWORN ACCORDING TO LAW, DEPOSES AND SAYS THE ABOVE STATEMENT IS TRUE AND CORRECT TO THE BEST OF HIS KNOWLEDGE AND BELIEF

SWORN AND SUBSCRIBED BEFORE ME THIS 13<sup>th</sup> DAY OF April, 1926

B. B. Bree  
NOTARY PUBLIC