

FIT TO 70


67

HECLA #2

FIT TO 68

FIT TO 66

T
R
U
S
T

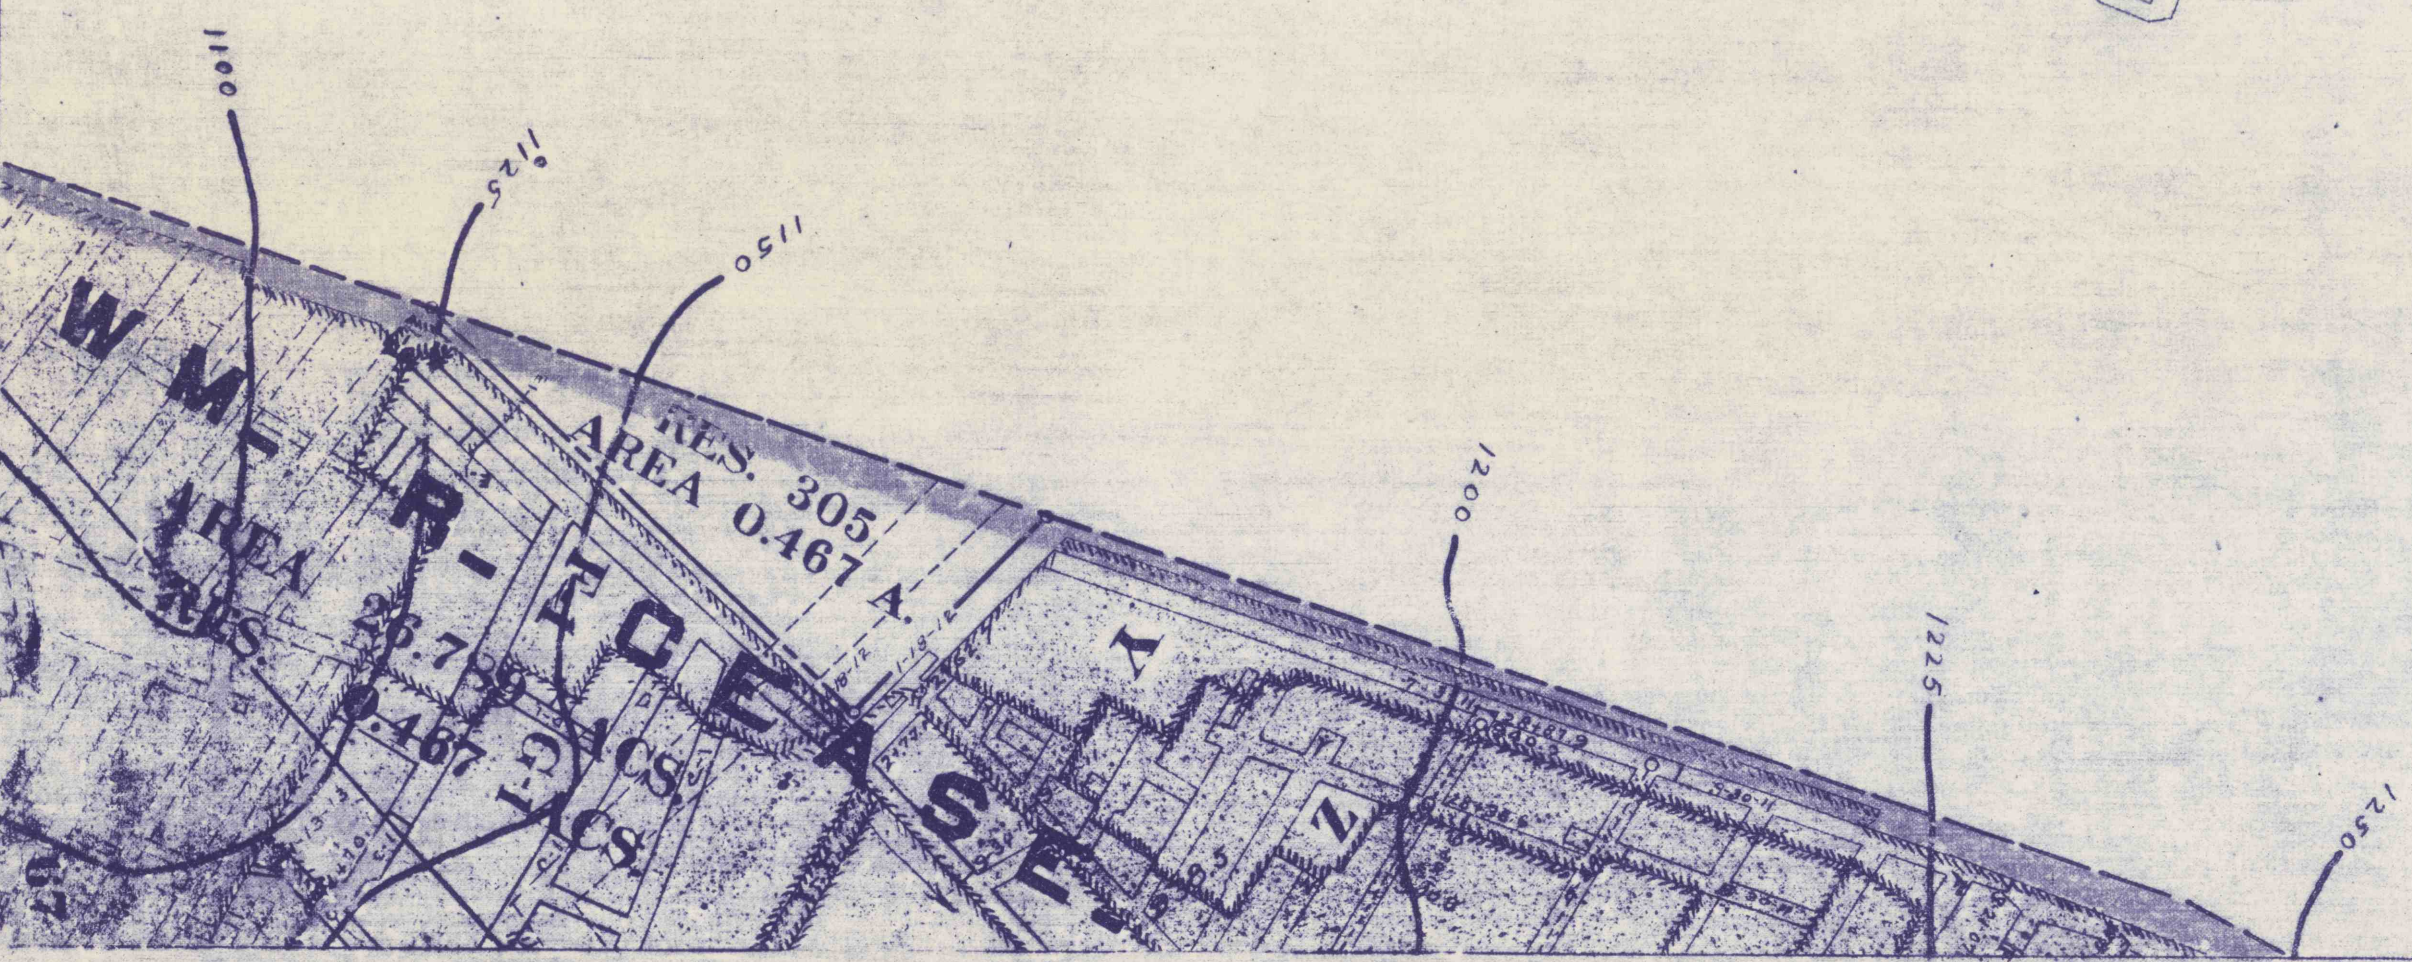

FIT TO 55