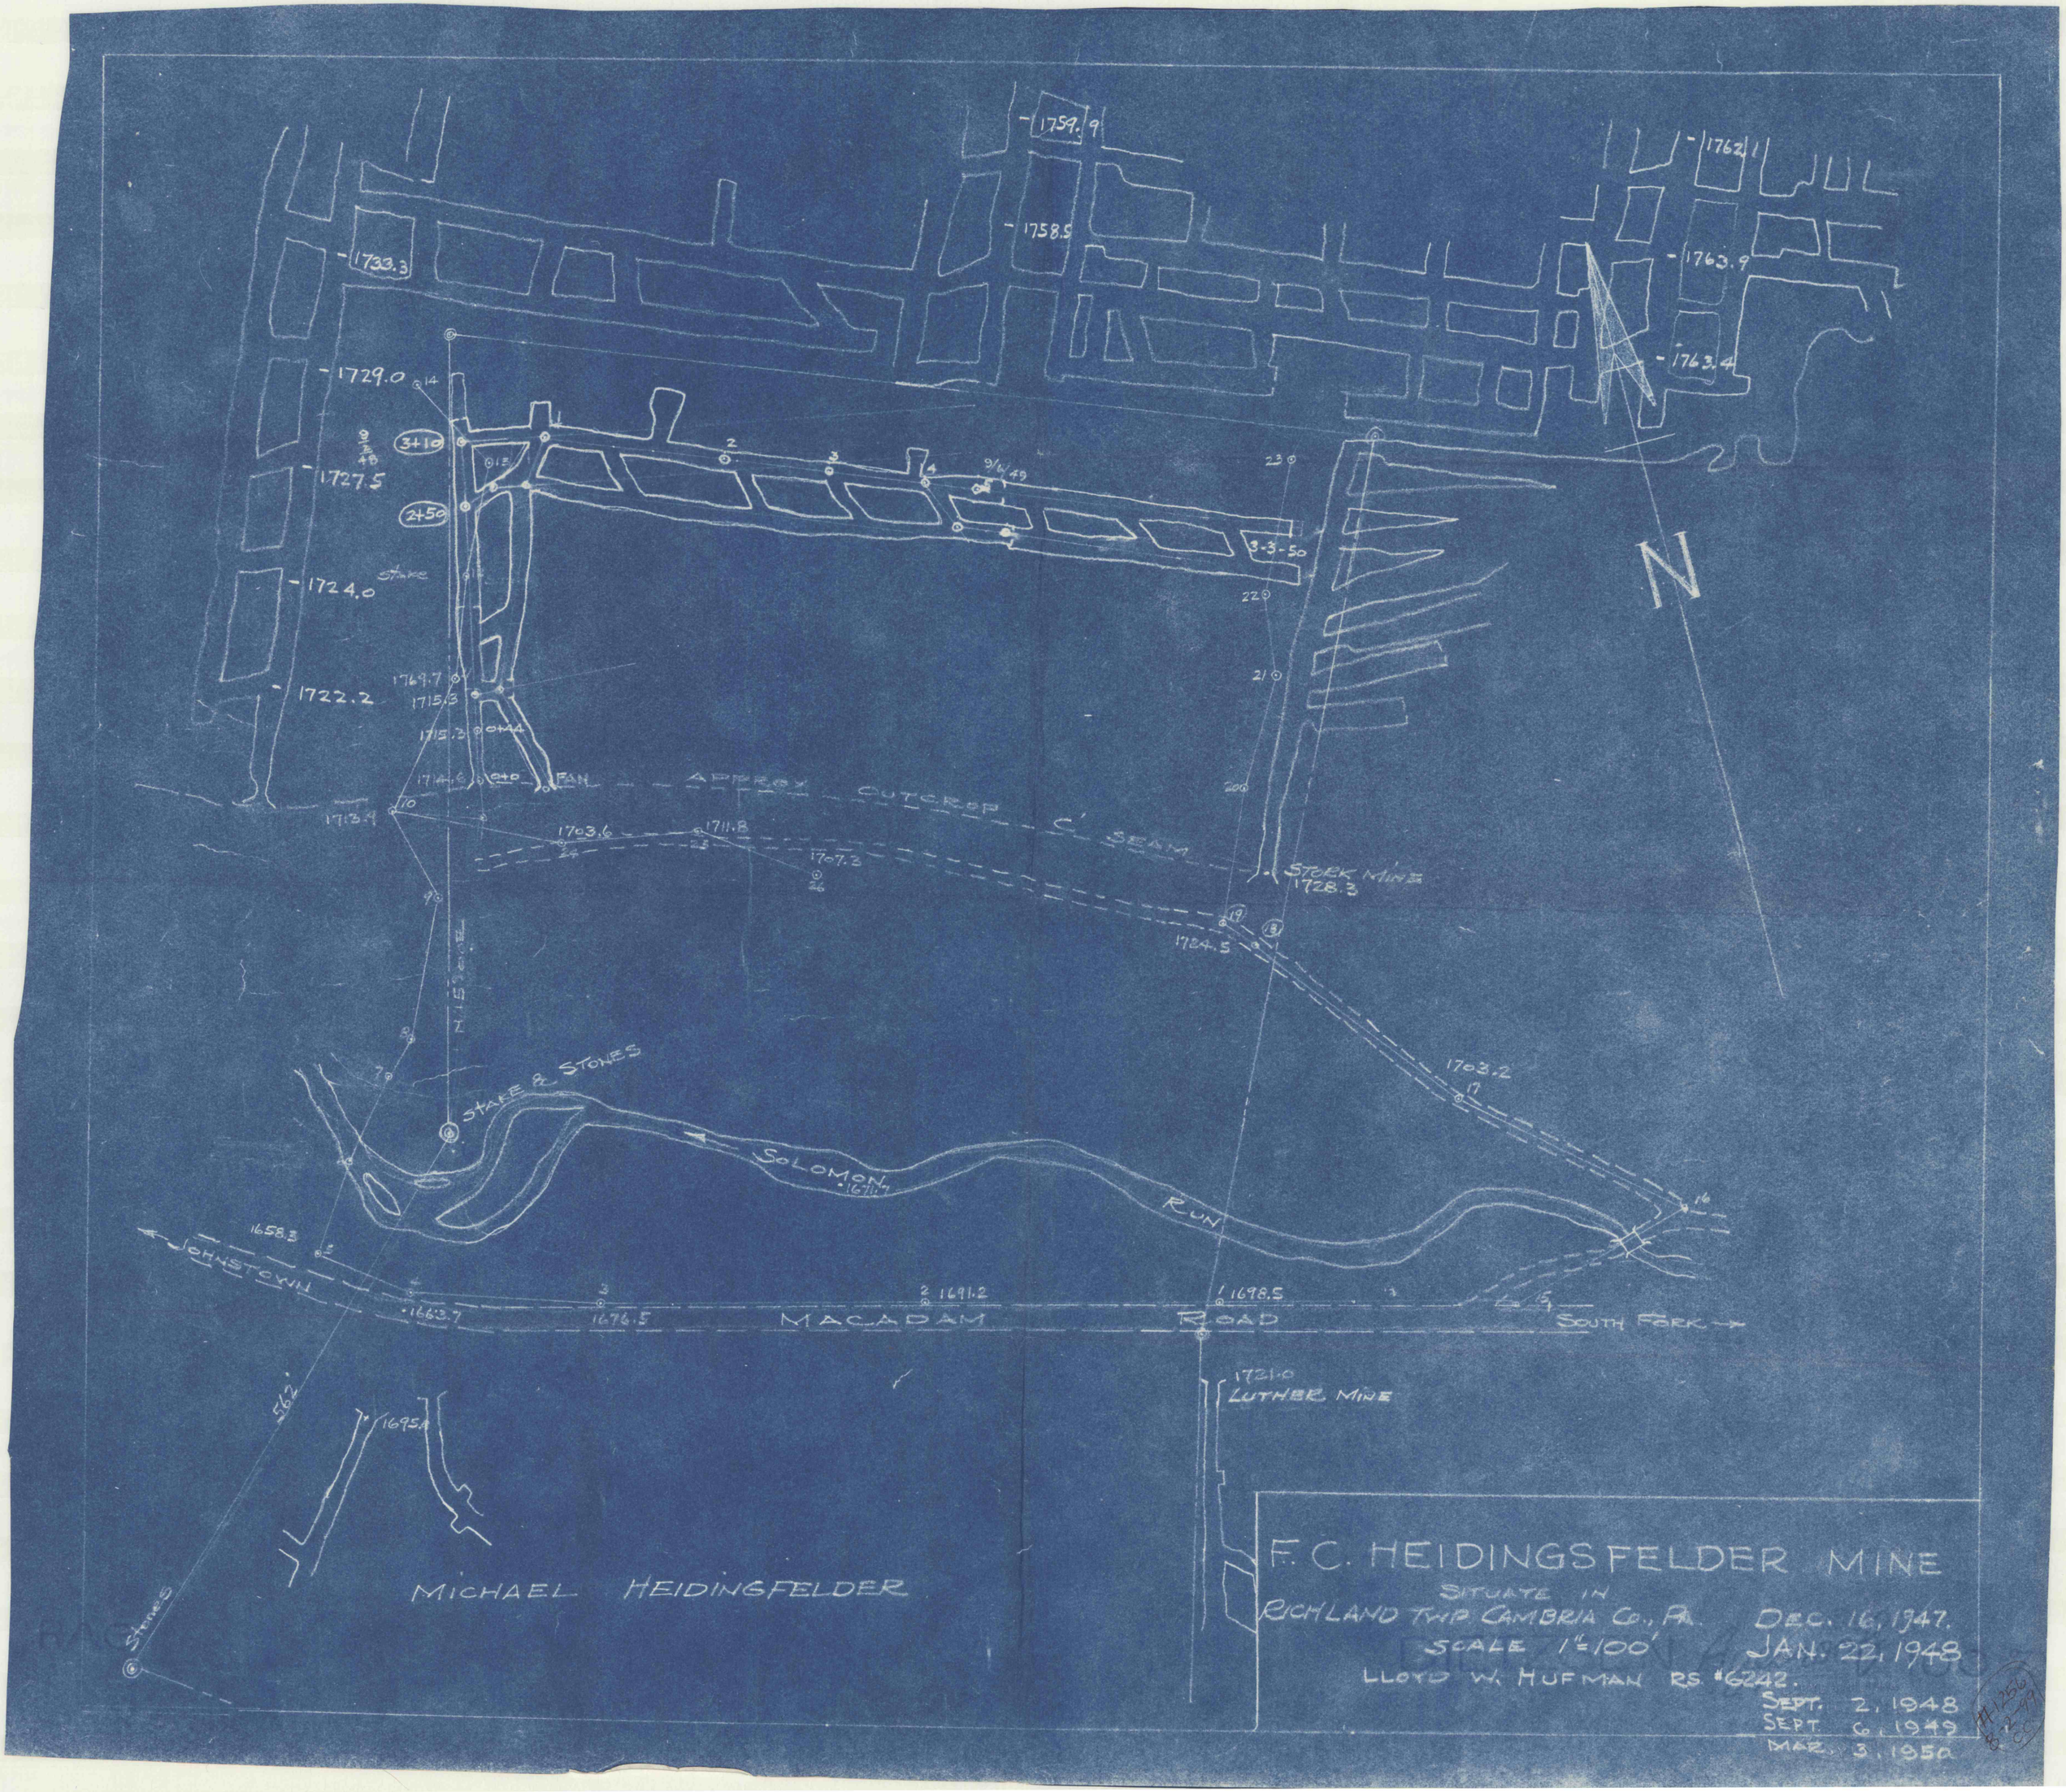

1759.9
1762.1
1758.5
1733.3
1763.9
1763.4
1729.0
3+10
1727.5
2+50
1724.0
1722.2
3-3-50
N
1769.7
1715.3
1715.3
0+44
1714.6
0+0
FAN
APPROX OUTCROP C' SEAM
1713.9
1703.6
1711.8
1707.3
STORK MINE
1728.3
1724.5
1703.2
STAKE & STONES
SOLOMON RUN
1671.7
1658.3
JOHNSTOWN
1663.7
1676.5
1691.2
1698.5
MACADAM ROAD
SOUTH FORK
1721.0
LUTHER MINE
562
1695.8
MICHAEL HEIDINGFELDER
Stones
F. C. HEIDINGSFELDER MINE
SITUATE IN
RICHLAND TWP. CAMBRIA CO., PA.
SCALE 1"=100'
LLOYD W. HUFMAN RS. #6242.
DEC. 16, 1947.
JAN. 22, 1948
SEPT. 2, 1948
SEPT. 6, 1949
MAR. 3, 1950