


HEISLEY COAL CO.
MINE No 2
BAKERTON, PA.

SCALE 1 INCH = 100 FEET DATE OF SURVEY
ENGINEERING OFFICE, TRUST BLDG EGBENSBURG, PA.

*Abandoned
Sept. 1926*

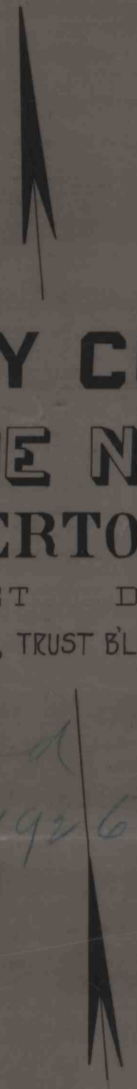

STERLING COAL CO.

PETER ELIE

A FINKENSELLER

HEISLEY COAL CO.

FARABAUGH
100.8 As

M'COMBIE
47.5 As

HAUK EST
131.79 As

RECHIE

B. WIRTHNER

ROBT. M'COMBIE

M. J. M'COMBIE

CHAS. KANE

