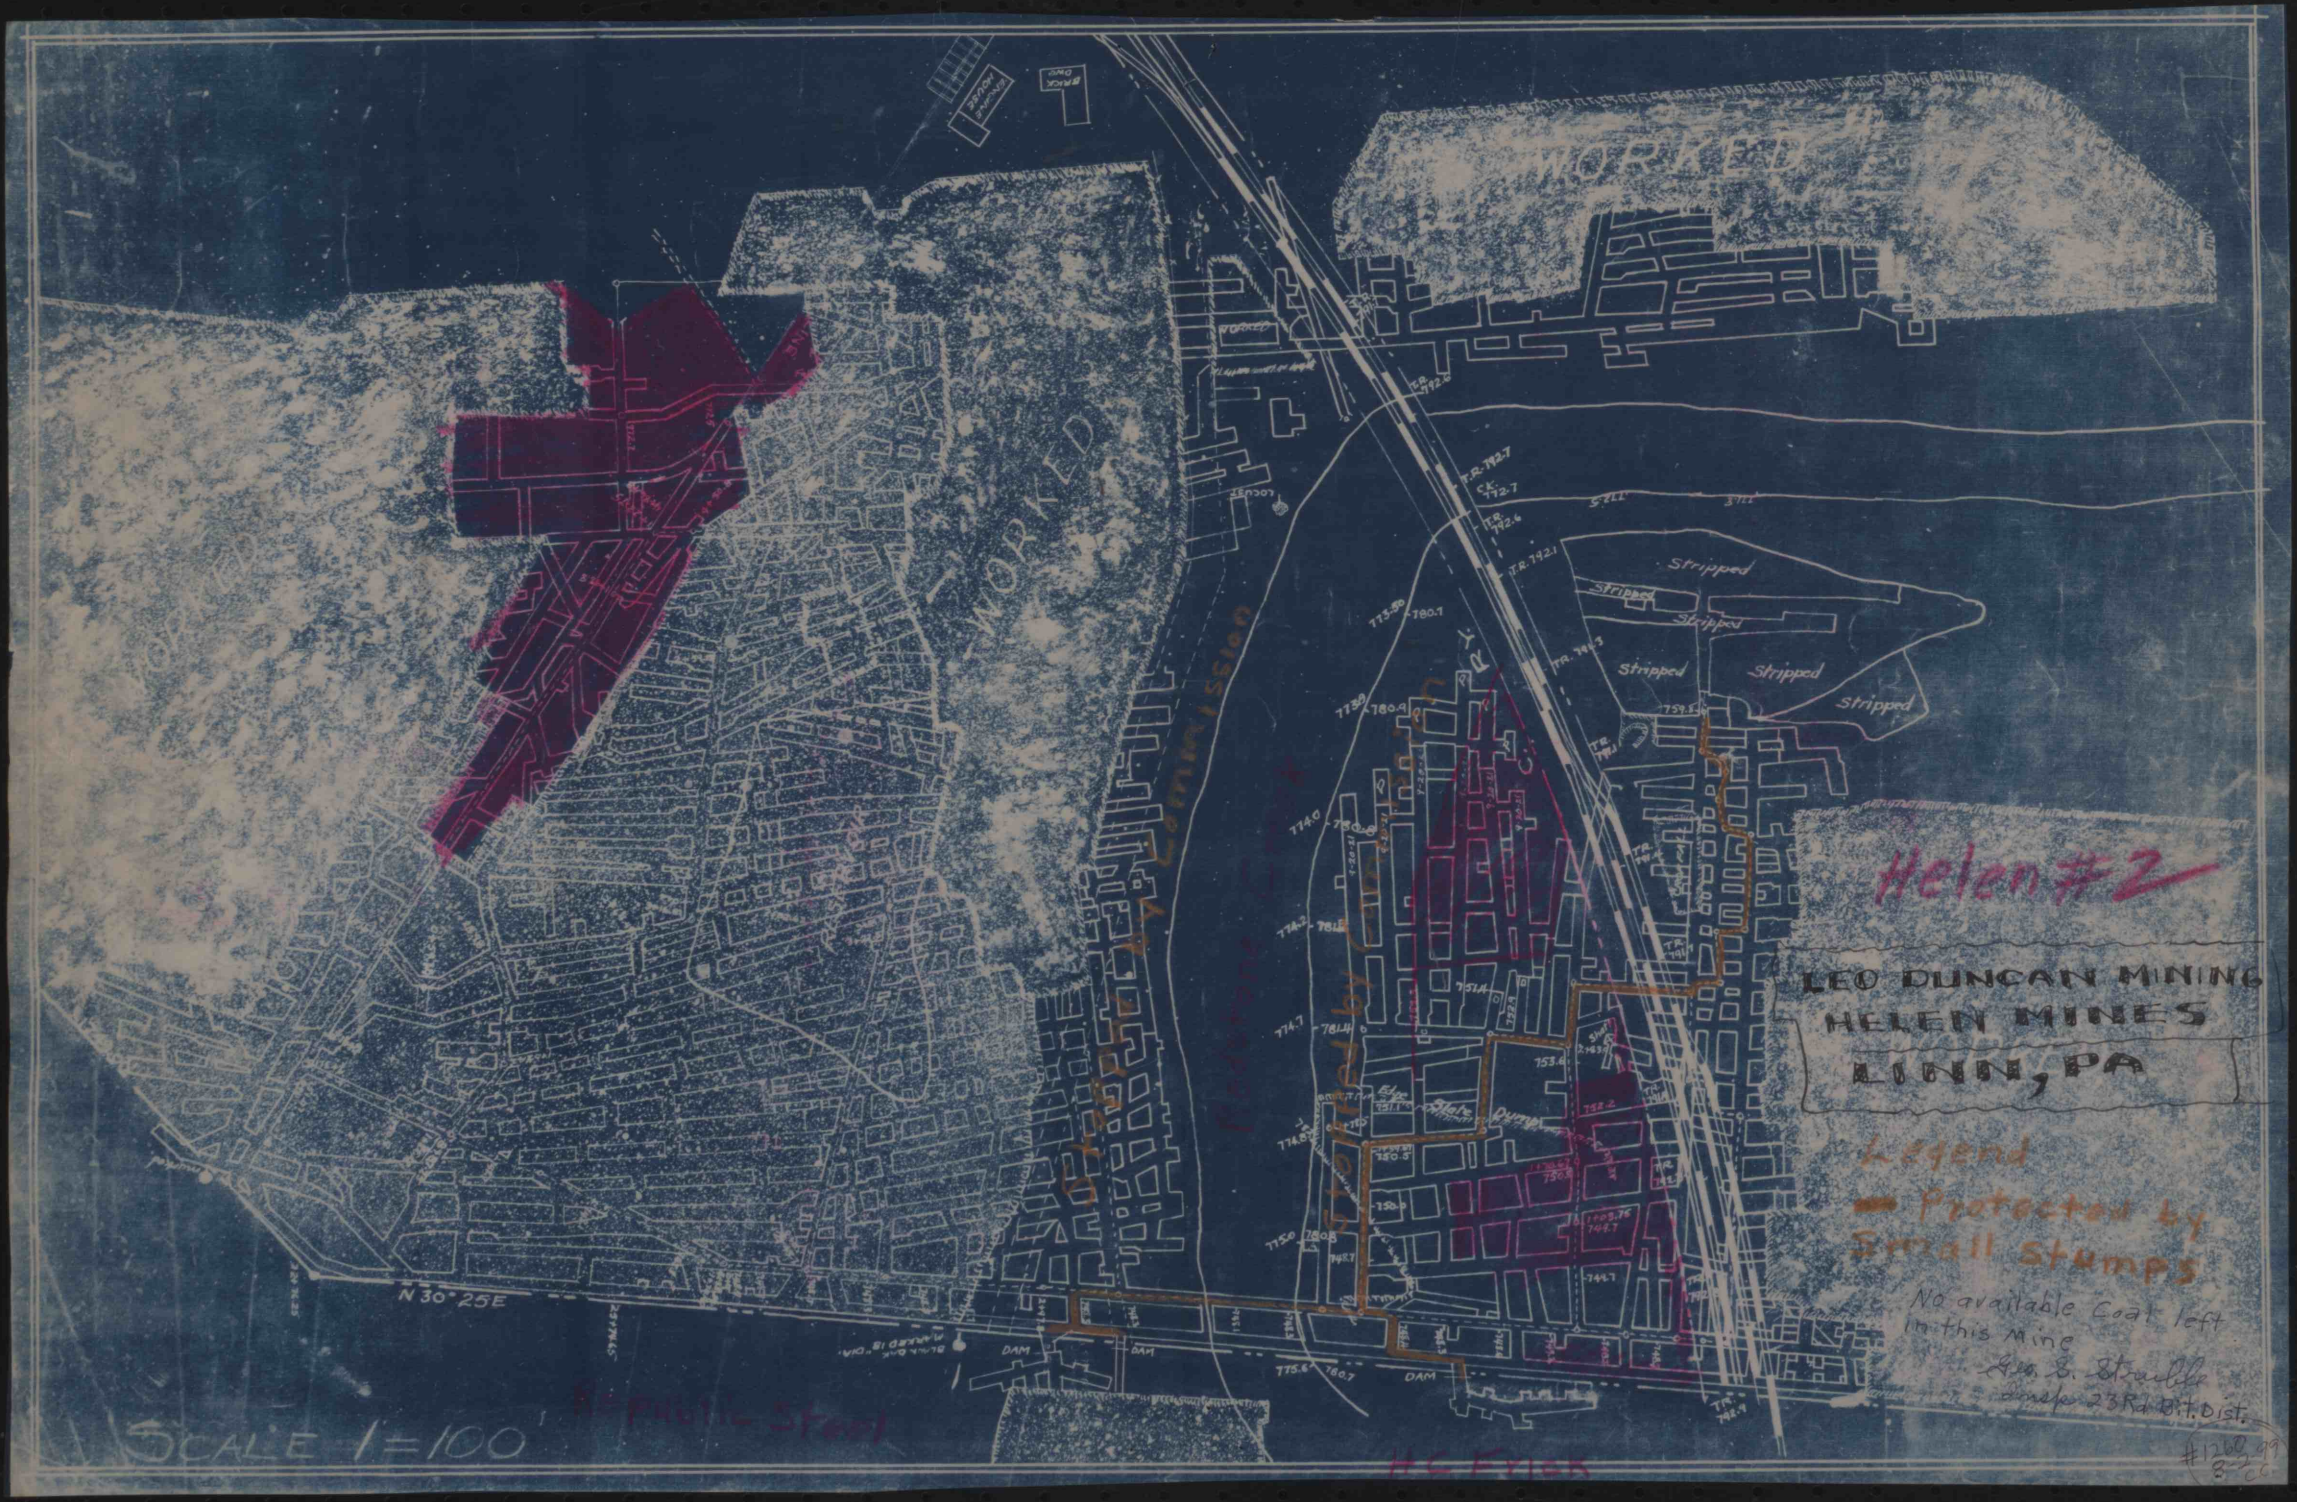

WORKED
WORKED
Stripped
Stripped
Stripped
Stripped
Stripped
Stripped
Stripped
Helen #2
LEO DUNCAN MINING
HELEN MINES
LINN, PA
Legend
Protected by Small Stumps
No available Coal left in this Mine
Geo. S. Struble
Insp. 23Rd Bit. Dist.
#1260 8-2-99 CC
N 30° 25E
DAM
DAM
DAM
SCALE 1=100'
Public Steel
H.C. Frick