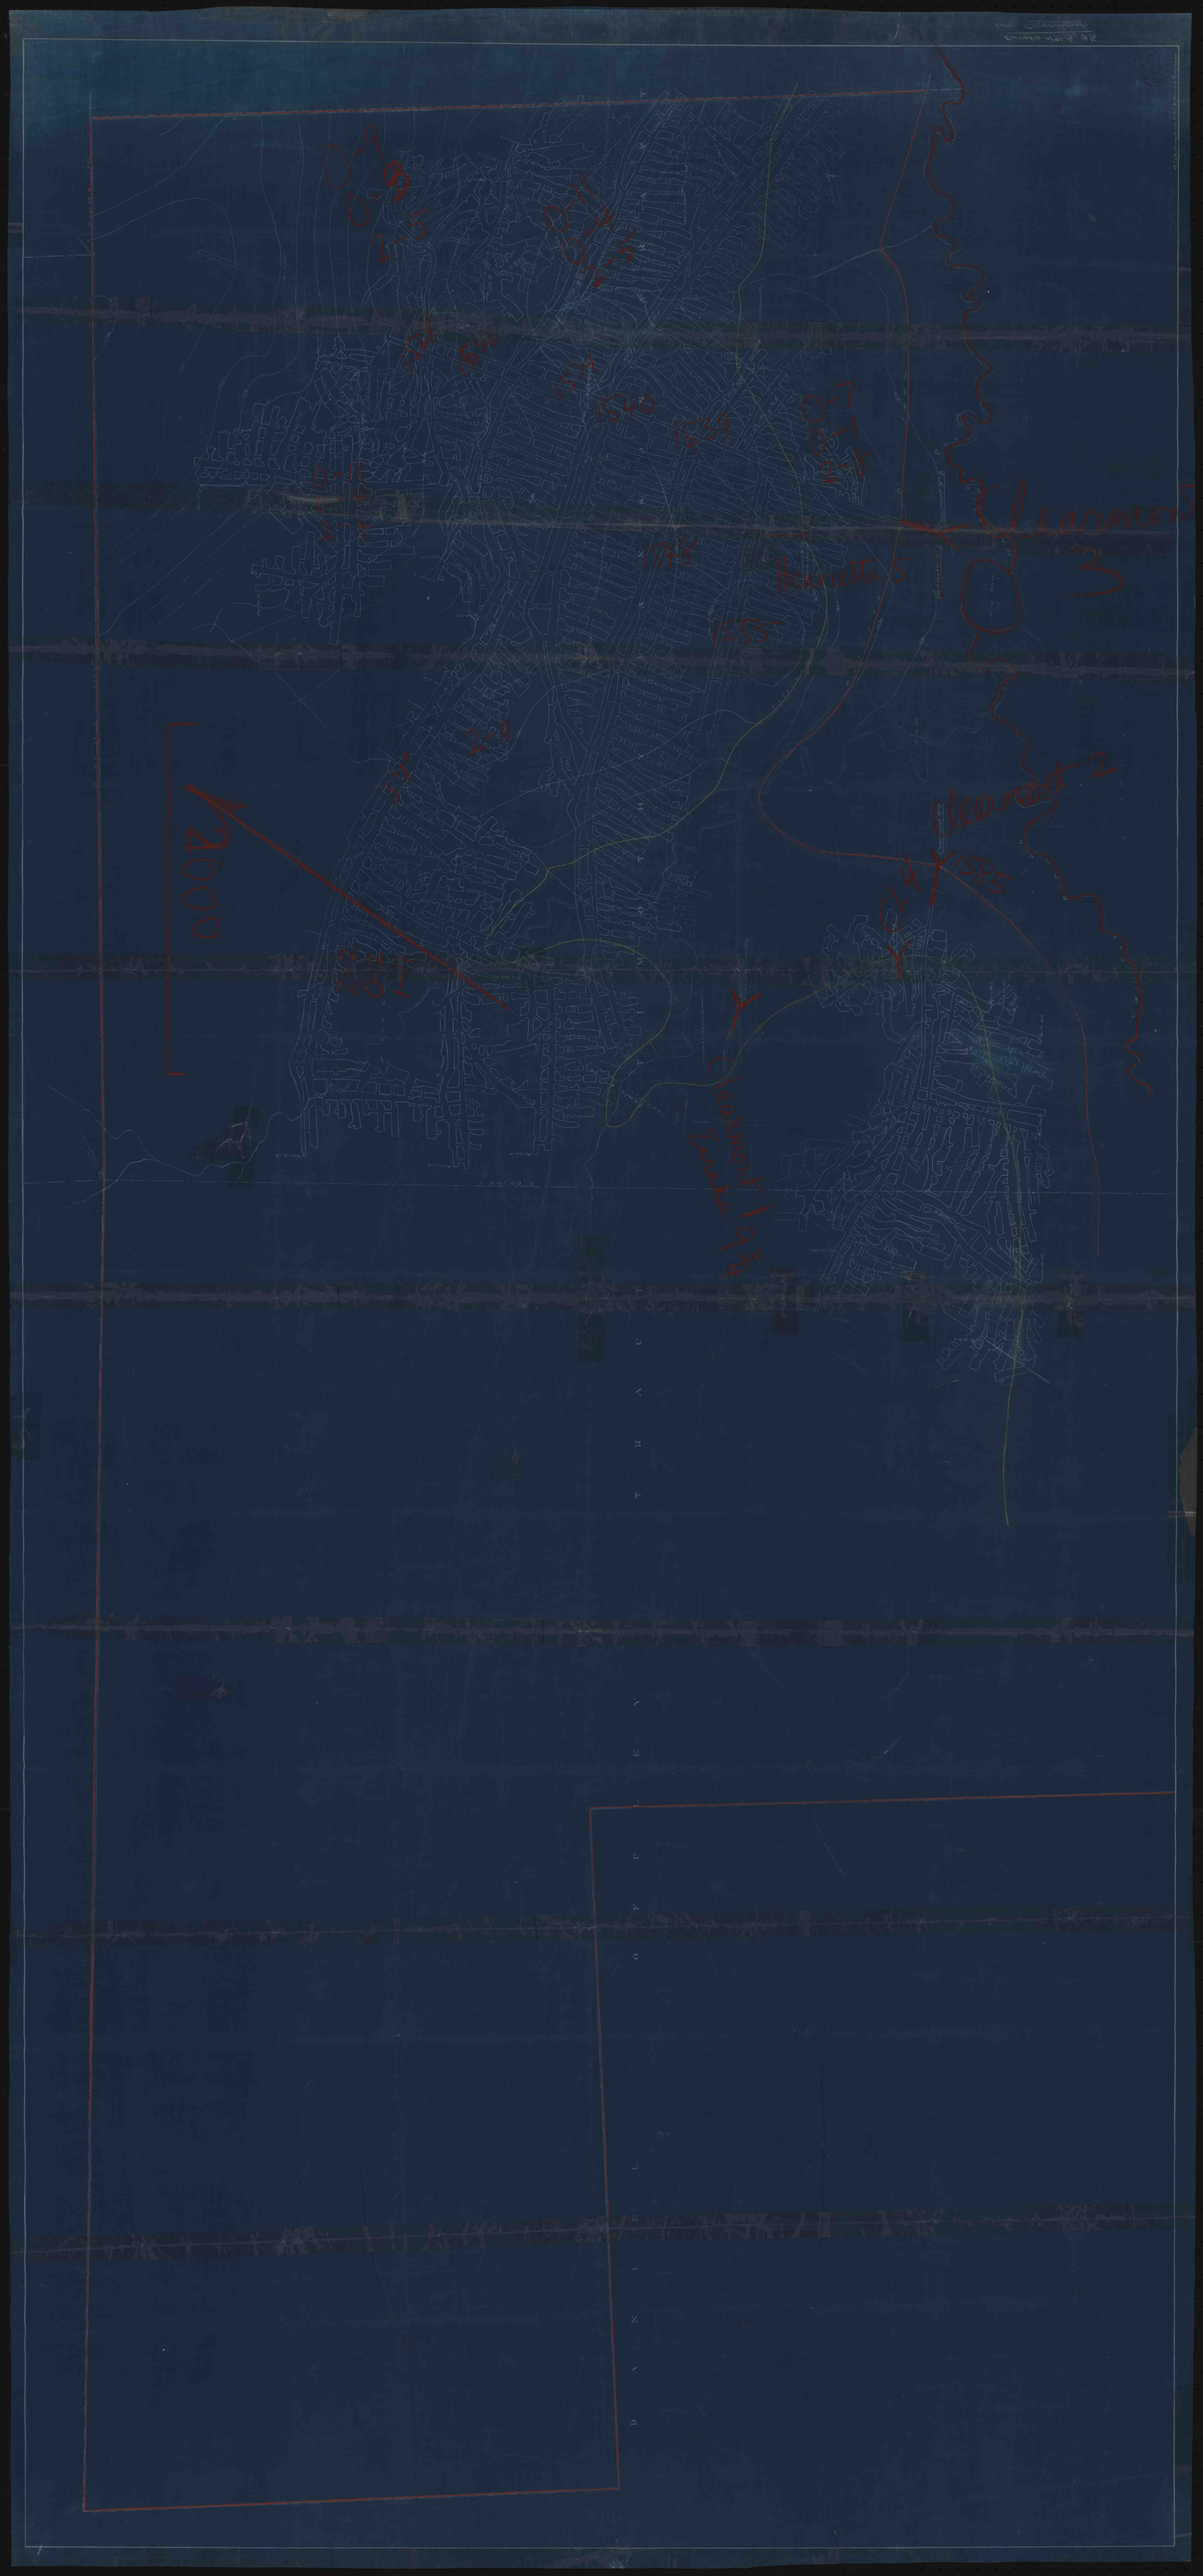
Clearwater 3
Clearwater 2
Clearwater 1
2000