
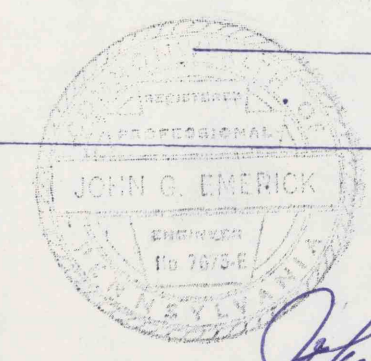
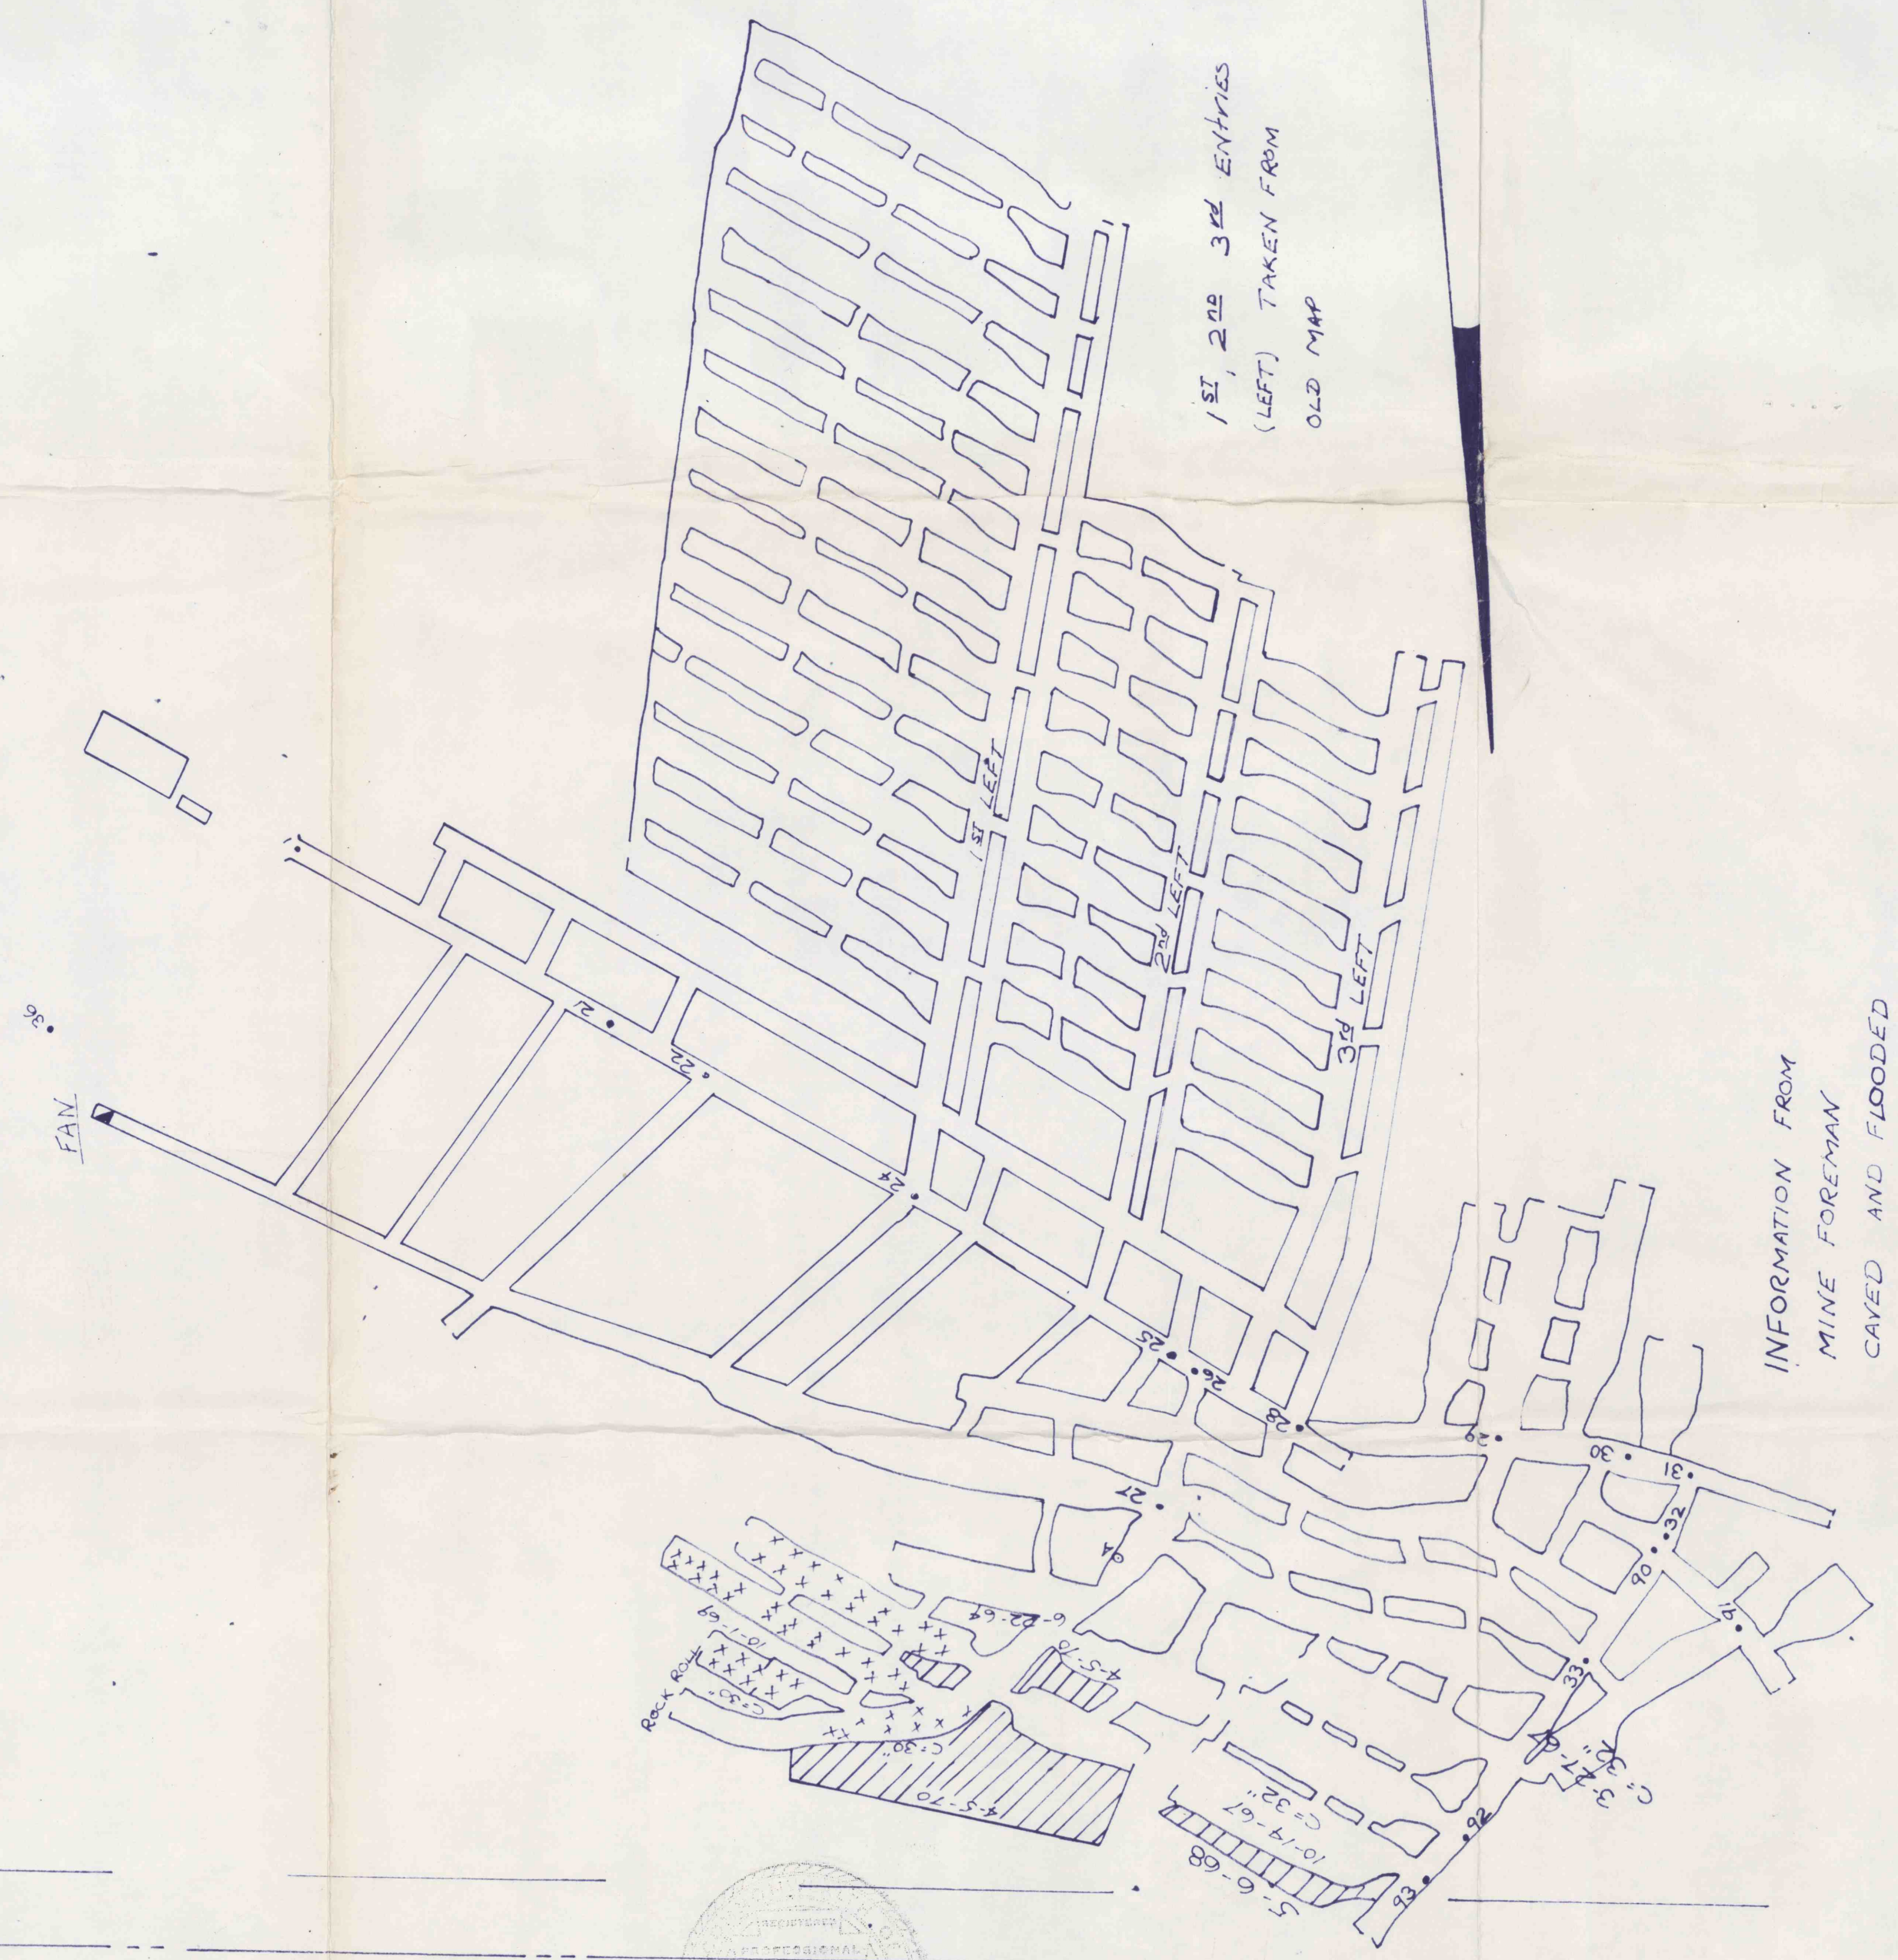


MAP
SHOWING
8" SEAM WORKINGS OF
HERTZOG COAL CO. NO. 1 MINE
CLEARFIELD TWP., CAMBRIA CO., PA.
SCALE - 1" = 100' 9-9-64
J. L. BANFIELD REG. ENG.

J. C. MCGOUGH SURF.
REGIS. HERTZOG COAL
189.0 AS.

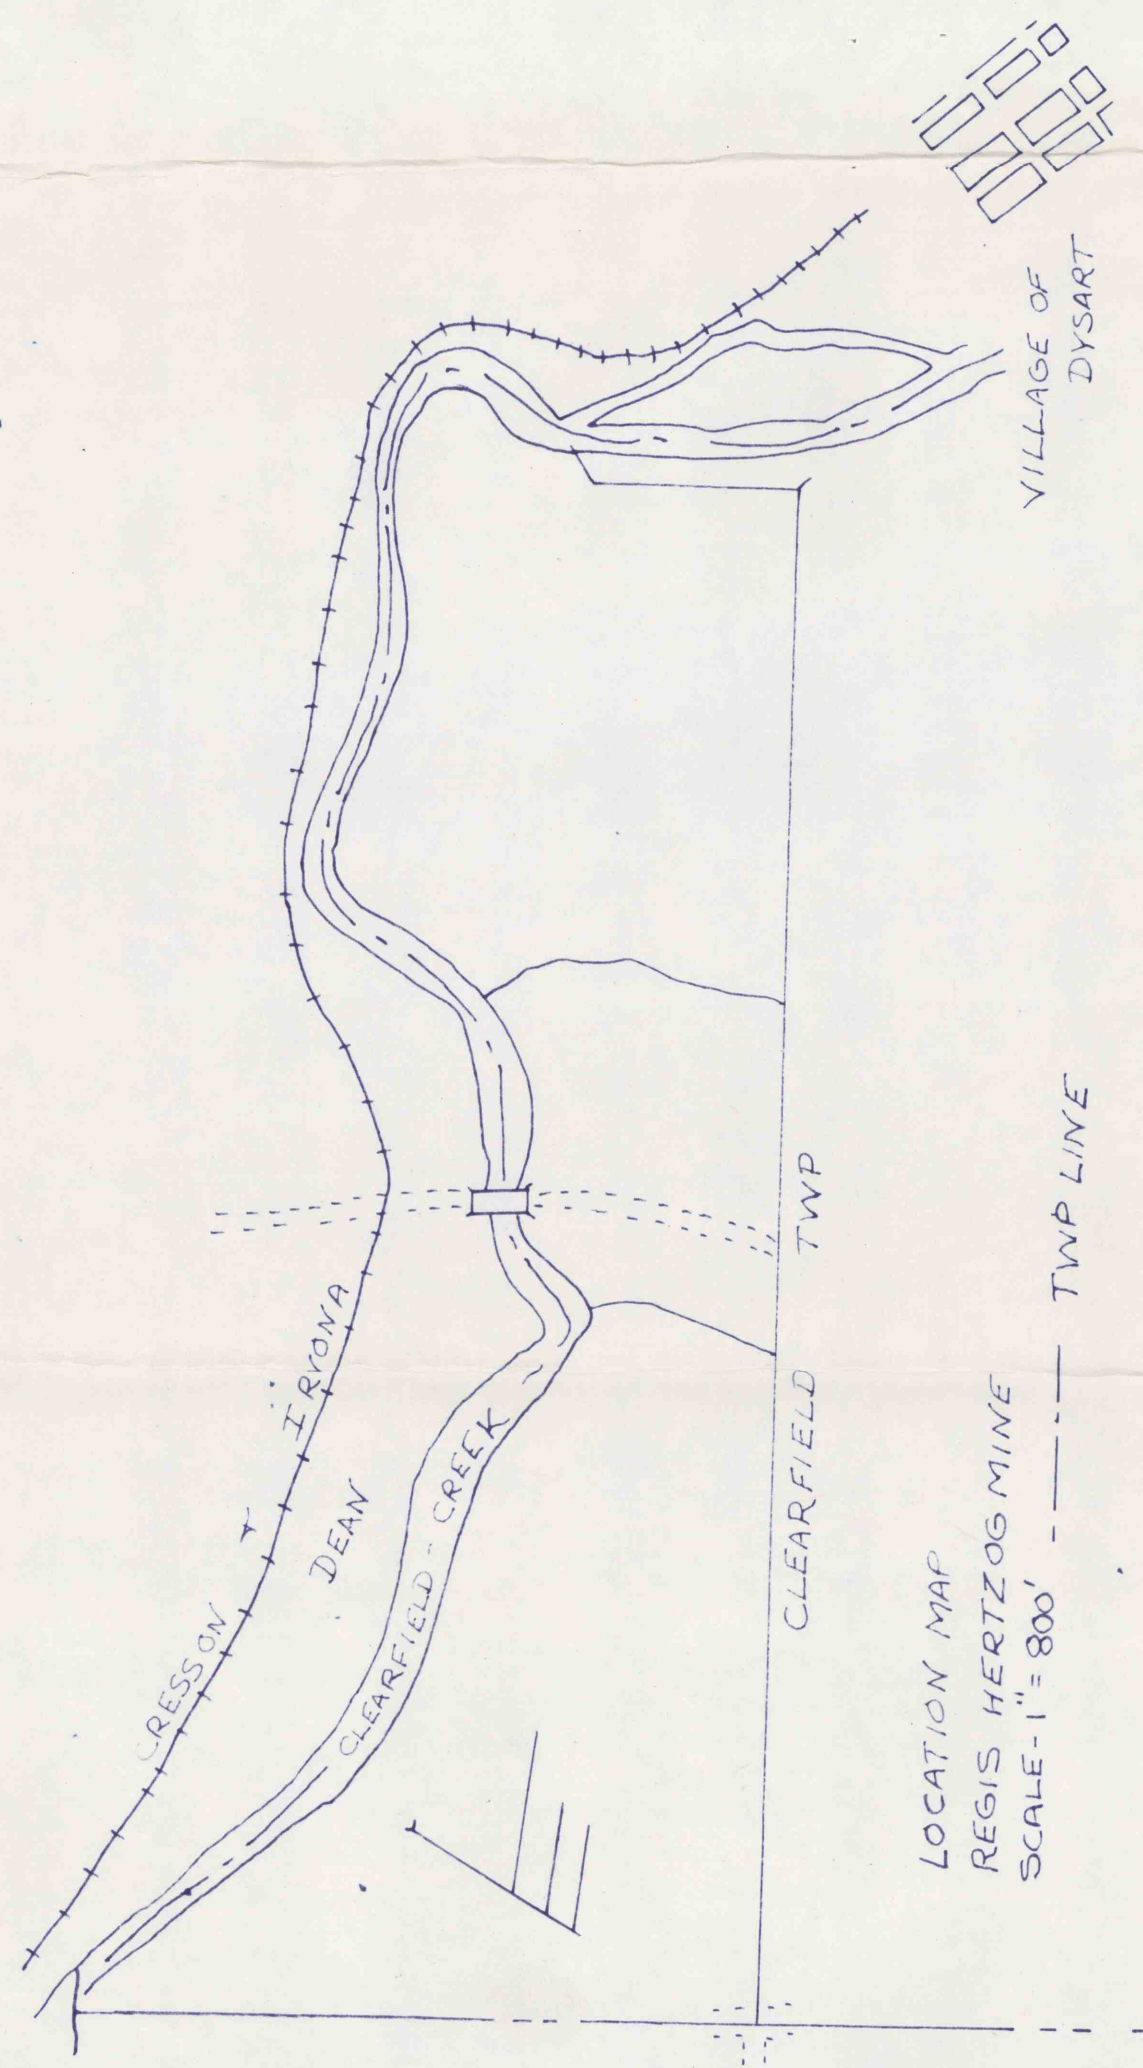

John G. Emerick

REV.	DESCRIPTION	CHECKED BY	DATE

REV.	DESCRIPTION	CHECKED BY	DATE

DRAWN BY	CHECKED BY	APPROVED

EASTERN GAS AND FUEL ASSOCIATES
COAL DIVISION
PITTSBURGH, PA.

SCALE	B. M. NO.