

PORTER KINPORT

BARNES & TUCKER SURF.

JOHN CROSSMAN


MRS PEARL LANTZY - COAL

WEAKLAND BROS SURF.

MRS ALBAN LANTZY (Fee)

INDIANA DEPOSIT BANK

MRS PEARL LANTZY - COAL

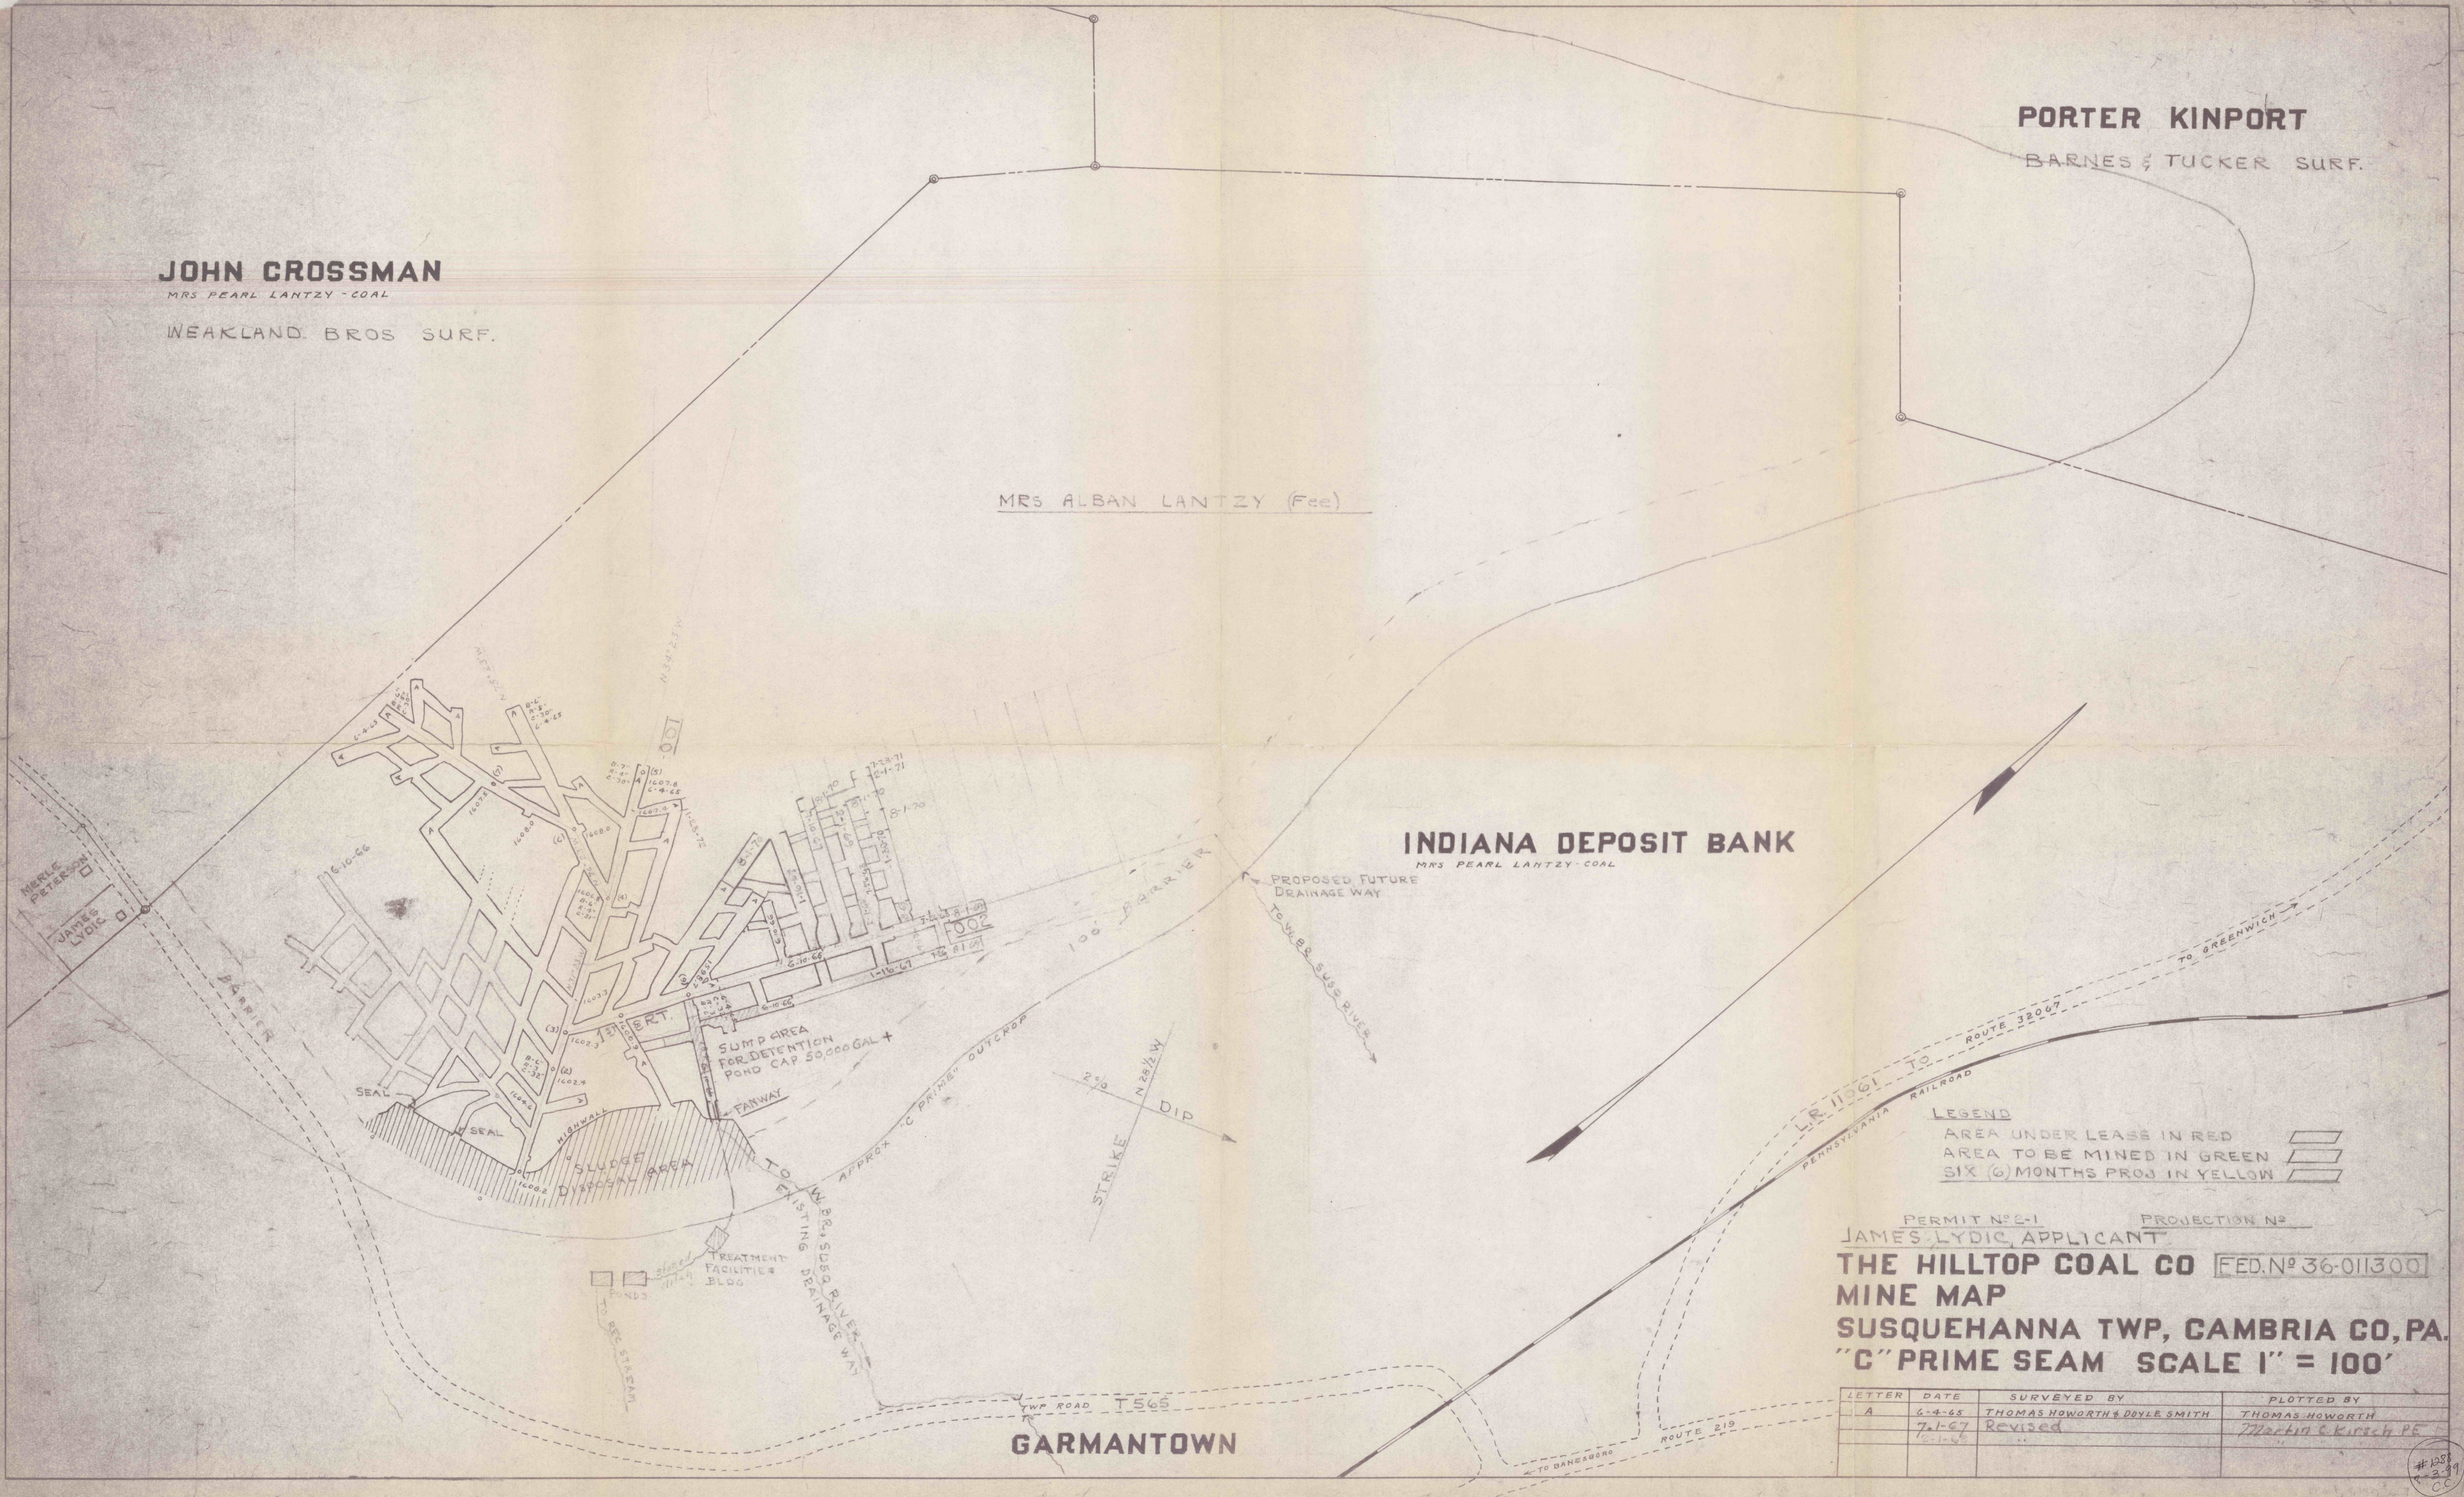

LEGEND

- AREA UNDER LEASE IN RED
- AREA TO BE MINED IN GREEN
- SIX (6) MONTHS PROJ IN YELLOW

PERMIT N° 2-1 PROJECTION N°
JAMES LYDIC, APPLICANT

THE HILLTOP COAL CO [FED. N° 36-011300]

MINE MAP

SUSQUEHANNA TWP, CAMBRIA CO, PA.

"C" PRIME SEAM SCALE 1" = 100'

LETTER	DATE	SURVEYED BY	PLOTTED BY
A	6-4-65	THOMAS HOWORTH & DOYLE SMITH	THOMAS HOWORTH
	7-1-67	Revised	Martin C. Kirsch, PE.
	7-1-68		

GARMANTOWN

#1288
2-29
CC