


Magnetic Meridian
June 7, 1920

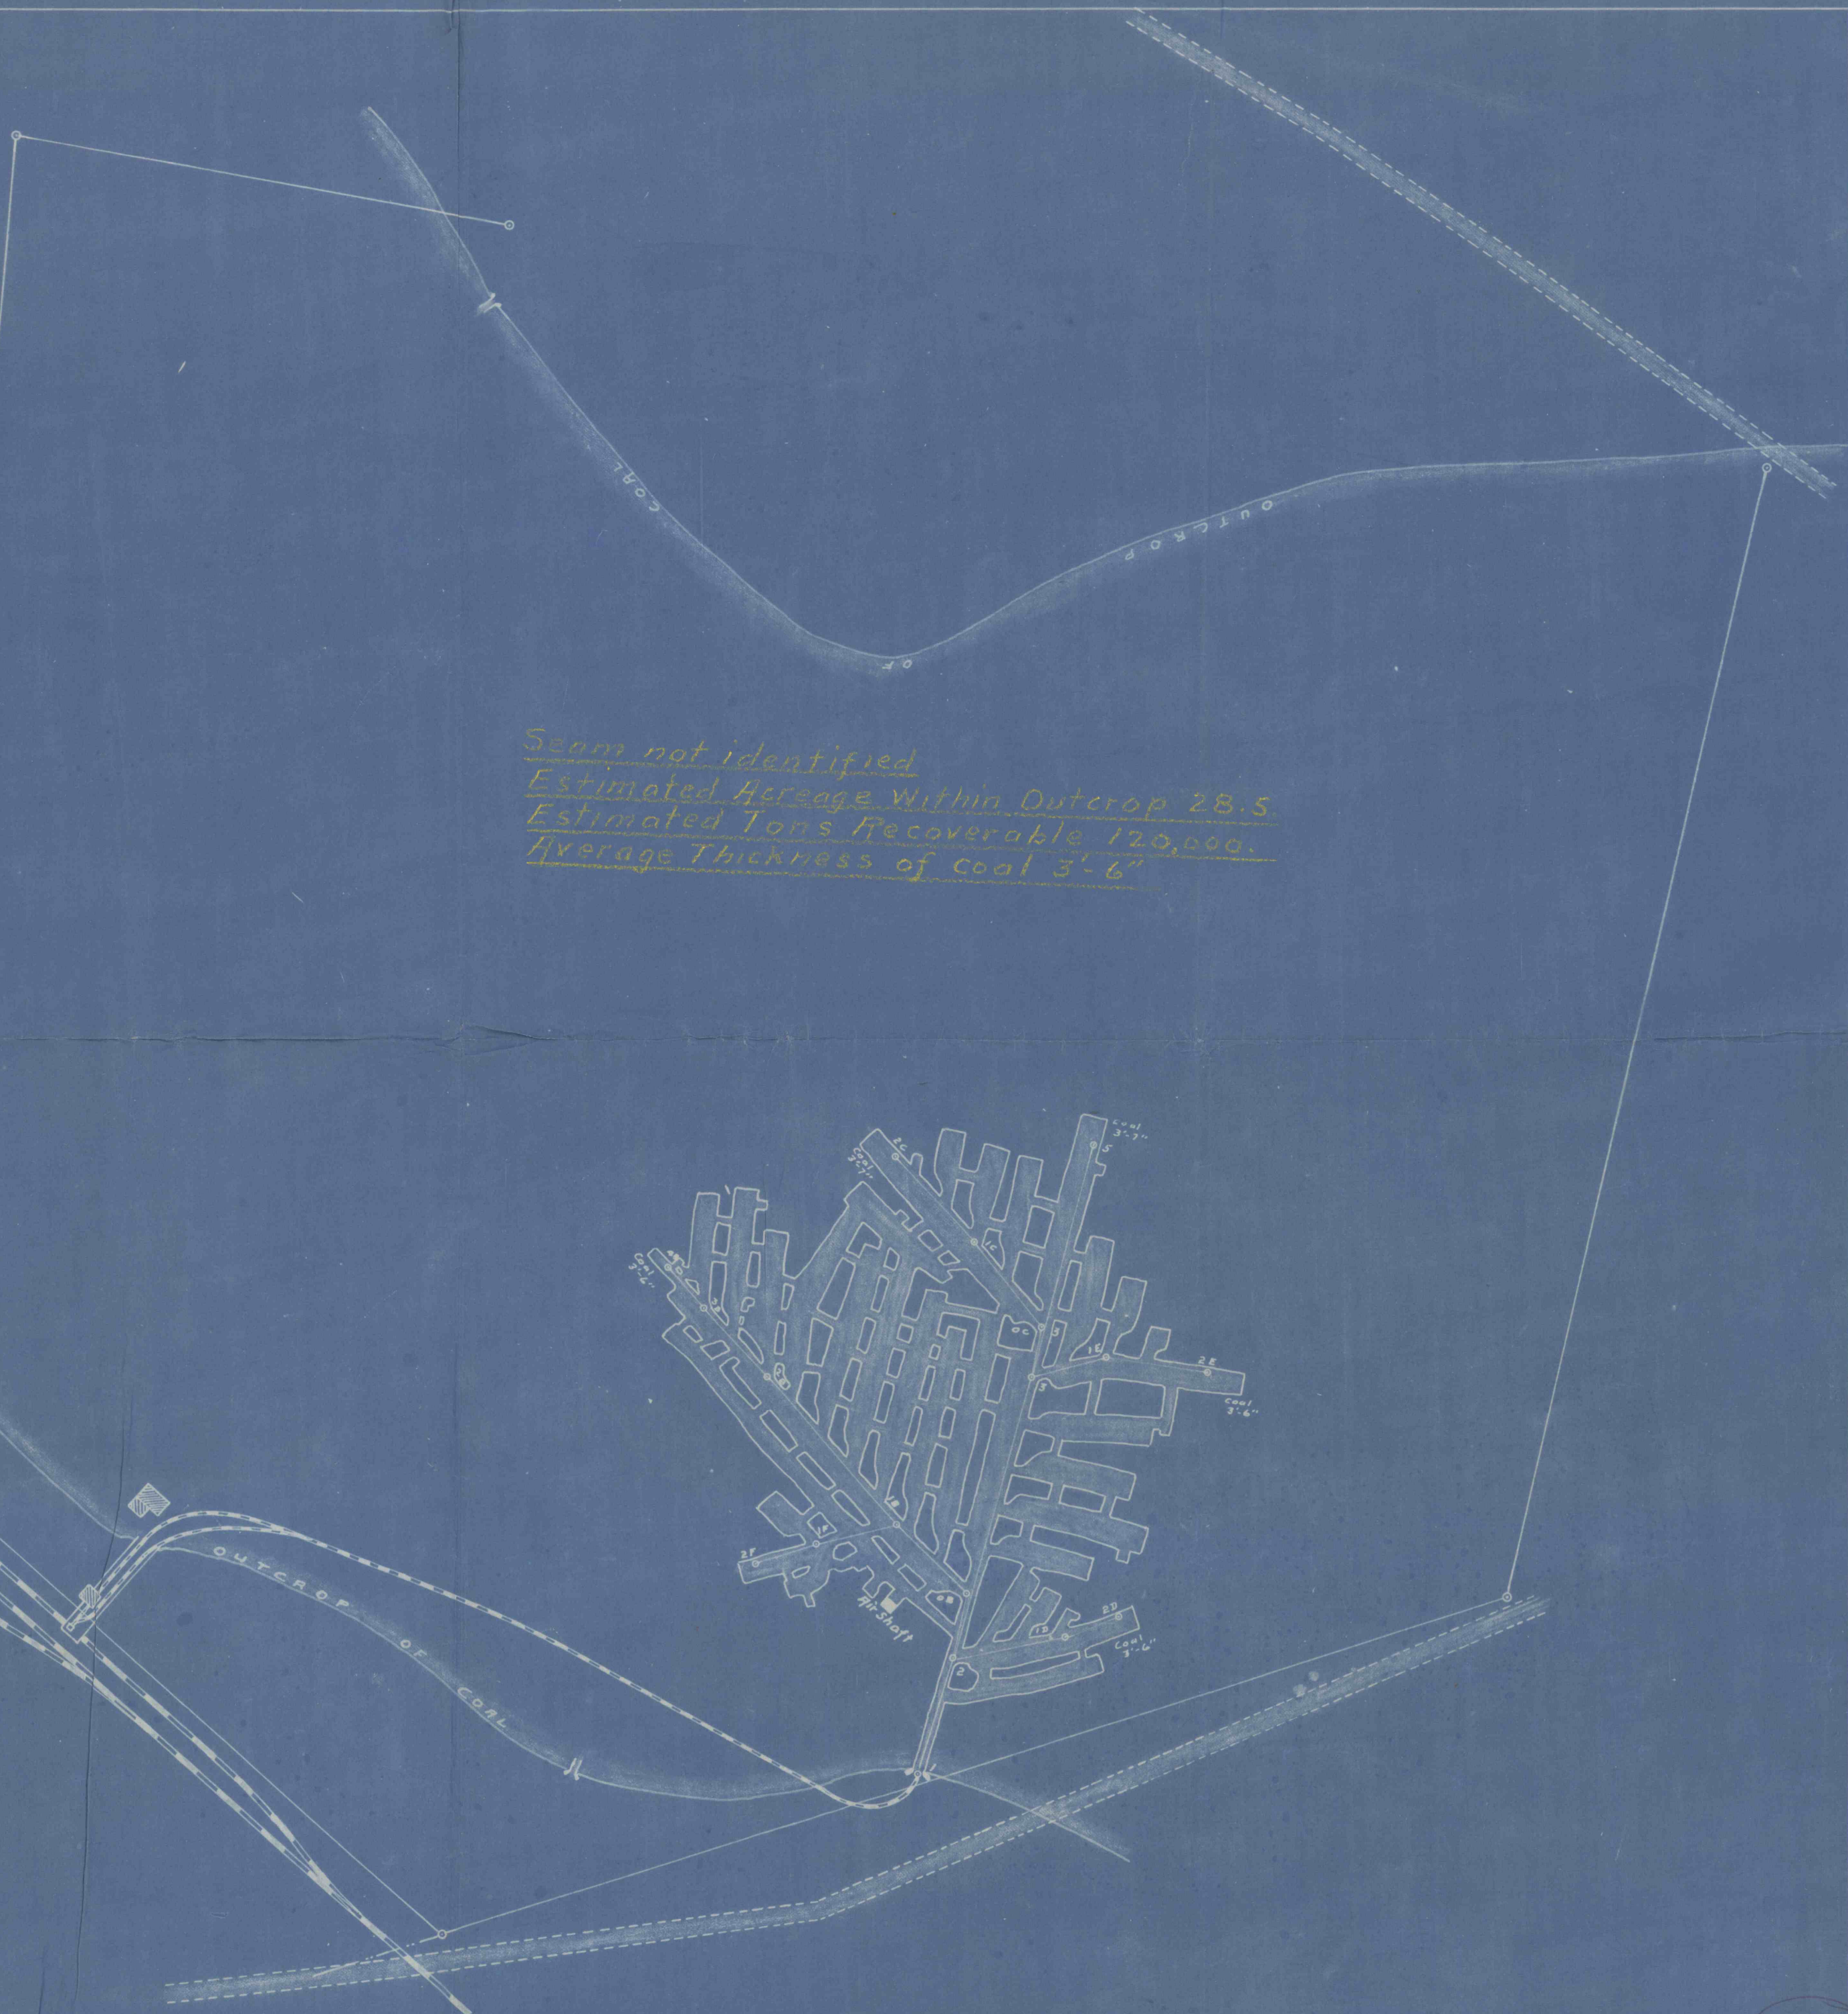

Seams not identified
Estimated Acreage Within Outcrop 28.5
Estimated Tons Recoverable 120,000.
Average Thickness of coal 3'-6"

Map of
HINDLE COAL CO.
MINE,
situated in
Decatur Township, Clearfield Co,
Pennsylvania.
Scale 1 in. = 100 ft.

#1292
8-3-99
CC