


1905
8-20

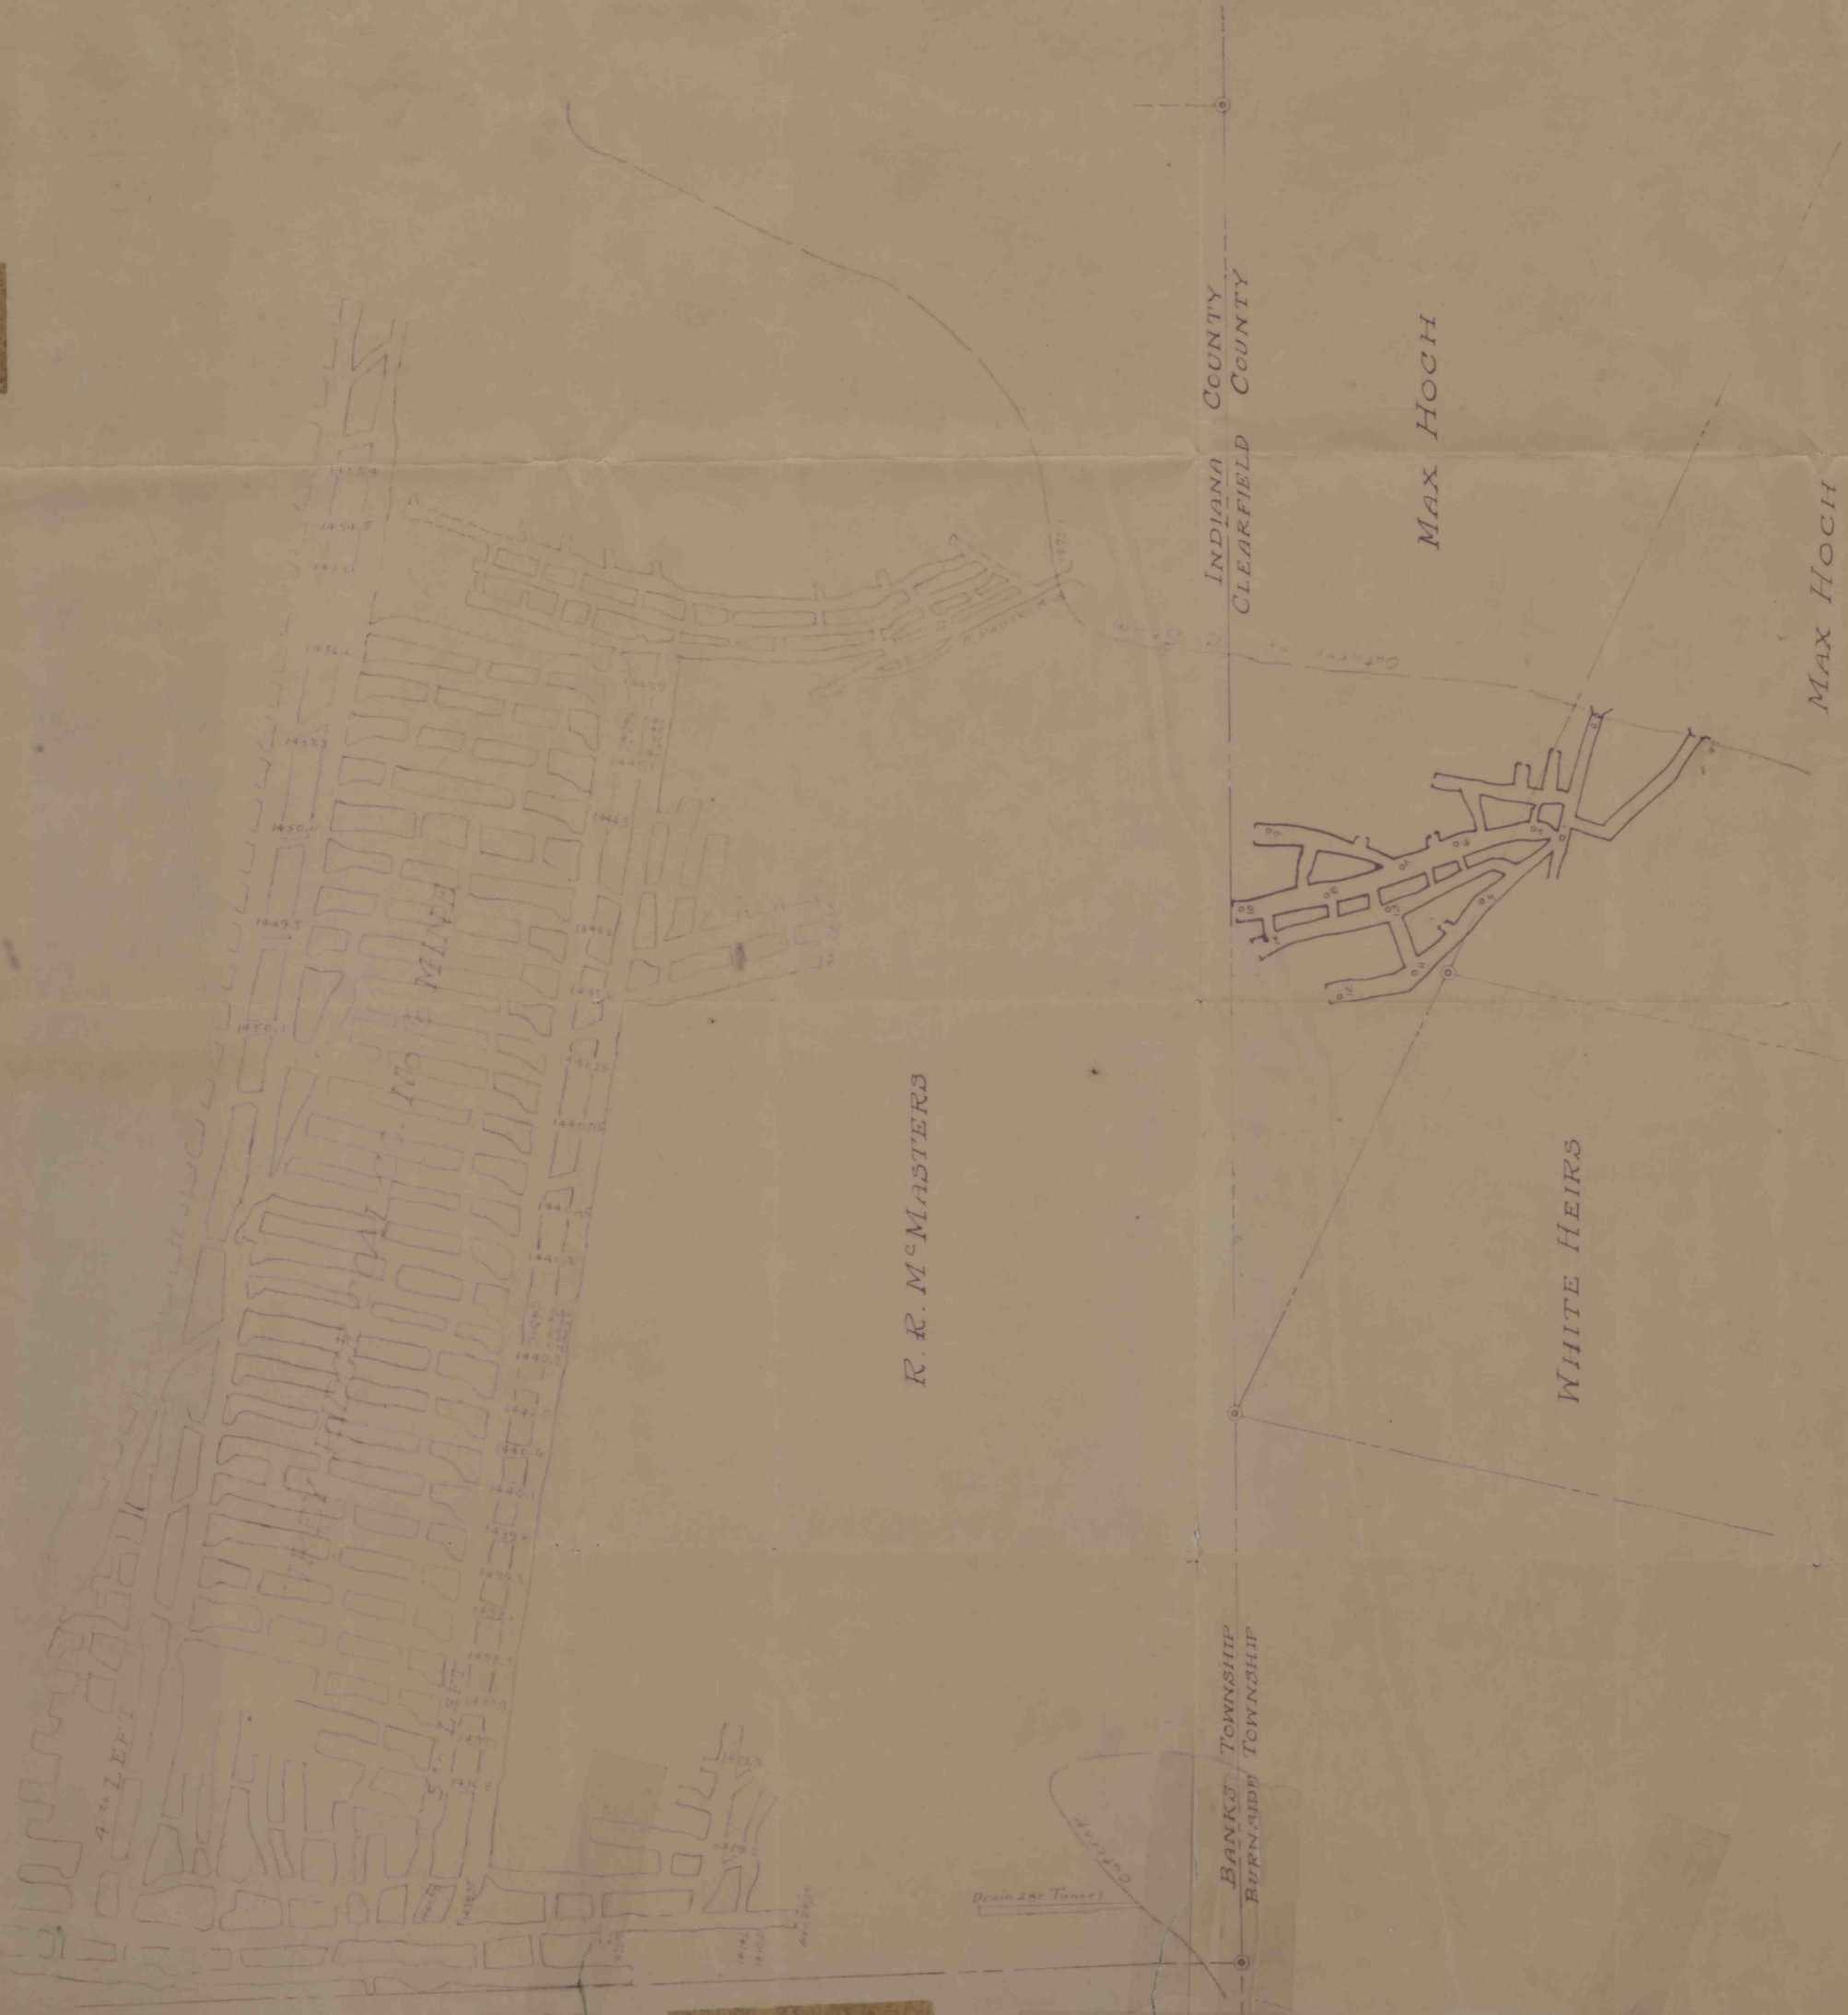

MAP OF
HOCH & BAILEY MINE
 BURNSIDE TOWNSHIP, CLEARFIELD COUNTY, Pa.
 SCALE 1" = 100'
 Walter J. Zimmerman Engineer, Pottsville, Pa.
 DECEMBER, 1918