


BLANCHE ROWLES

ROBERT RISHEL

CARL SNYDER

MAYNARD L. GOSS

WILLIAM SNYDER

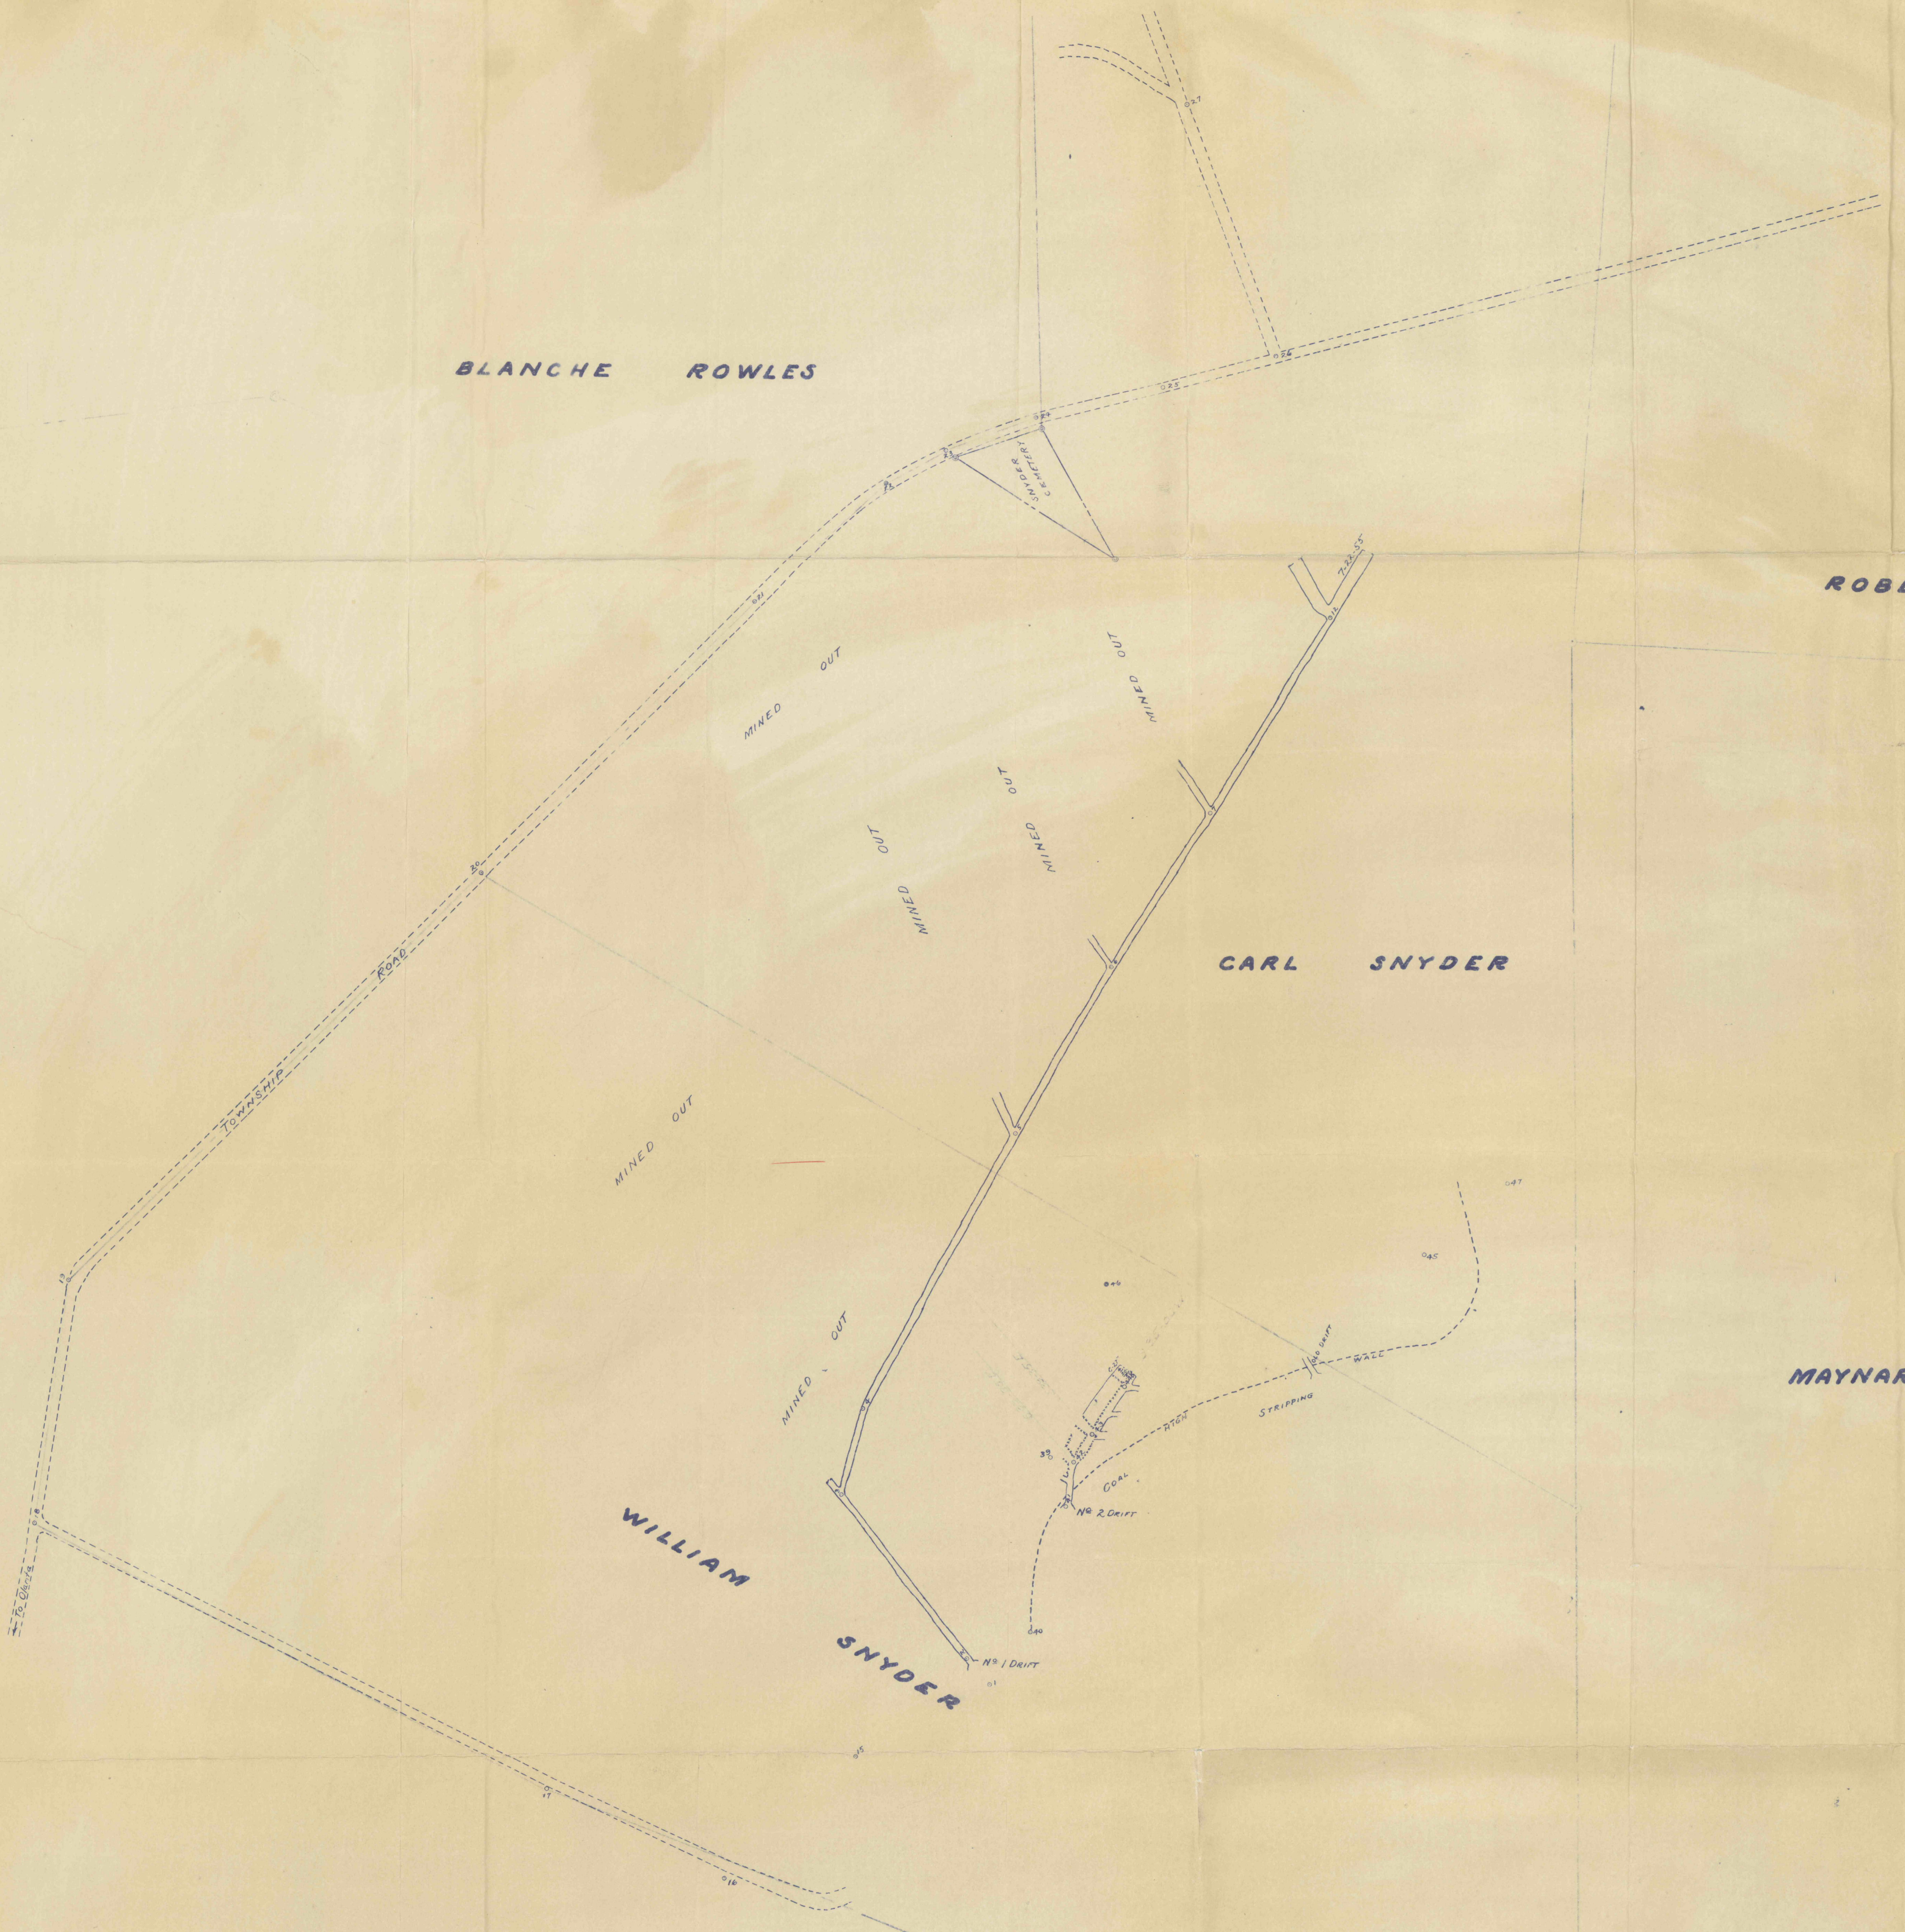

Hoover & Son Coal Co
 Hoover No 4
 #358376

MAP OF ISAAC HOOVER COAL MINE
 PIKE TOWNSHIP, CLEARFIELD CO, PENNA.
 SCALE: 1" = 100'
 SURVEYED: APRIL 14 & 20, 1956
 DRAWN: JDR:K
 TRACED: J.R.H.Jr.
 MAY 7, 1956
 CURWENSVILLE ENGINEERS
 CHECKED: JDR:K