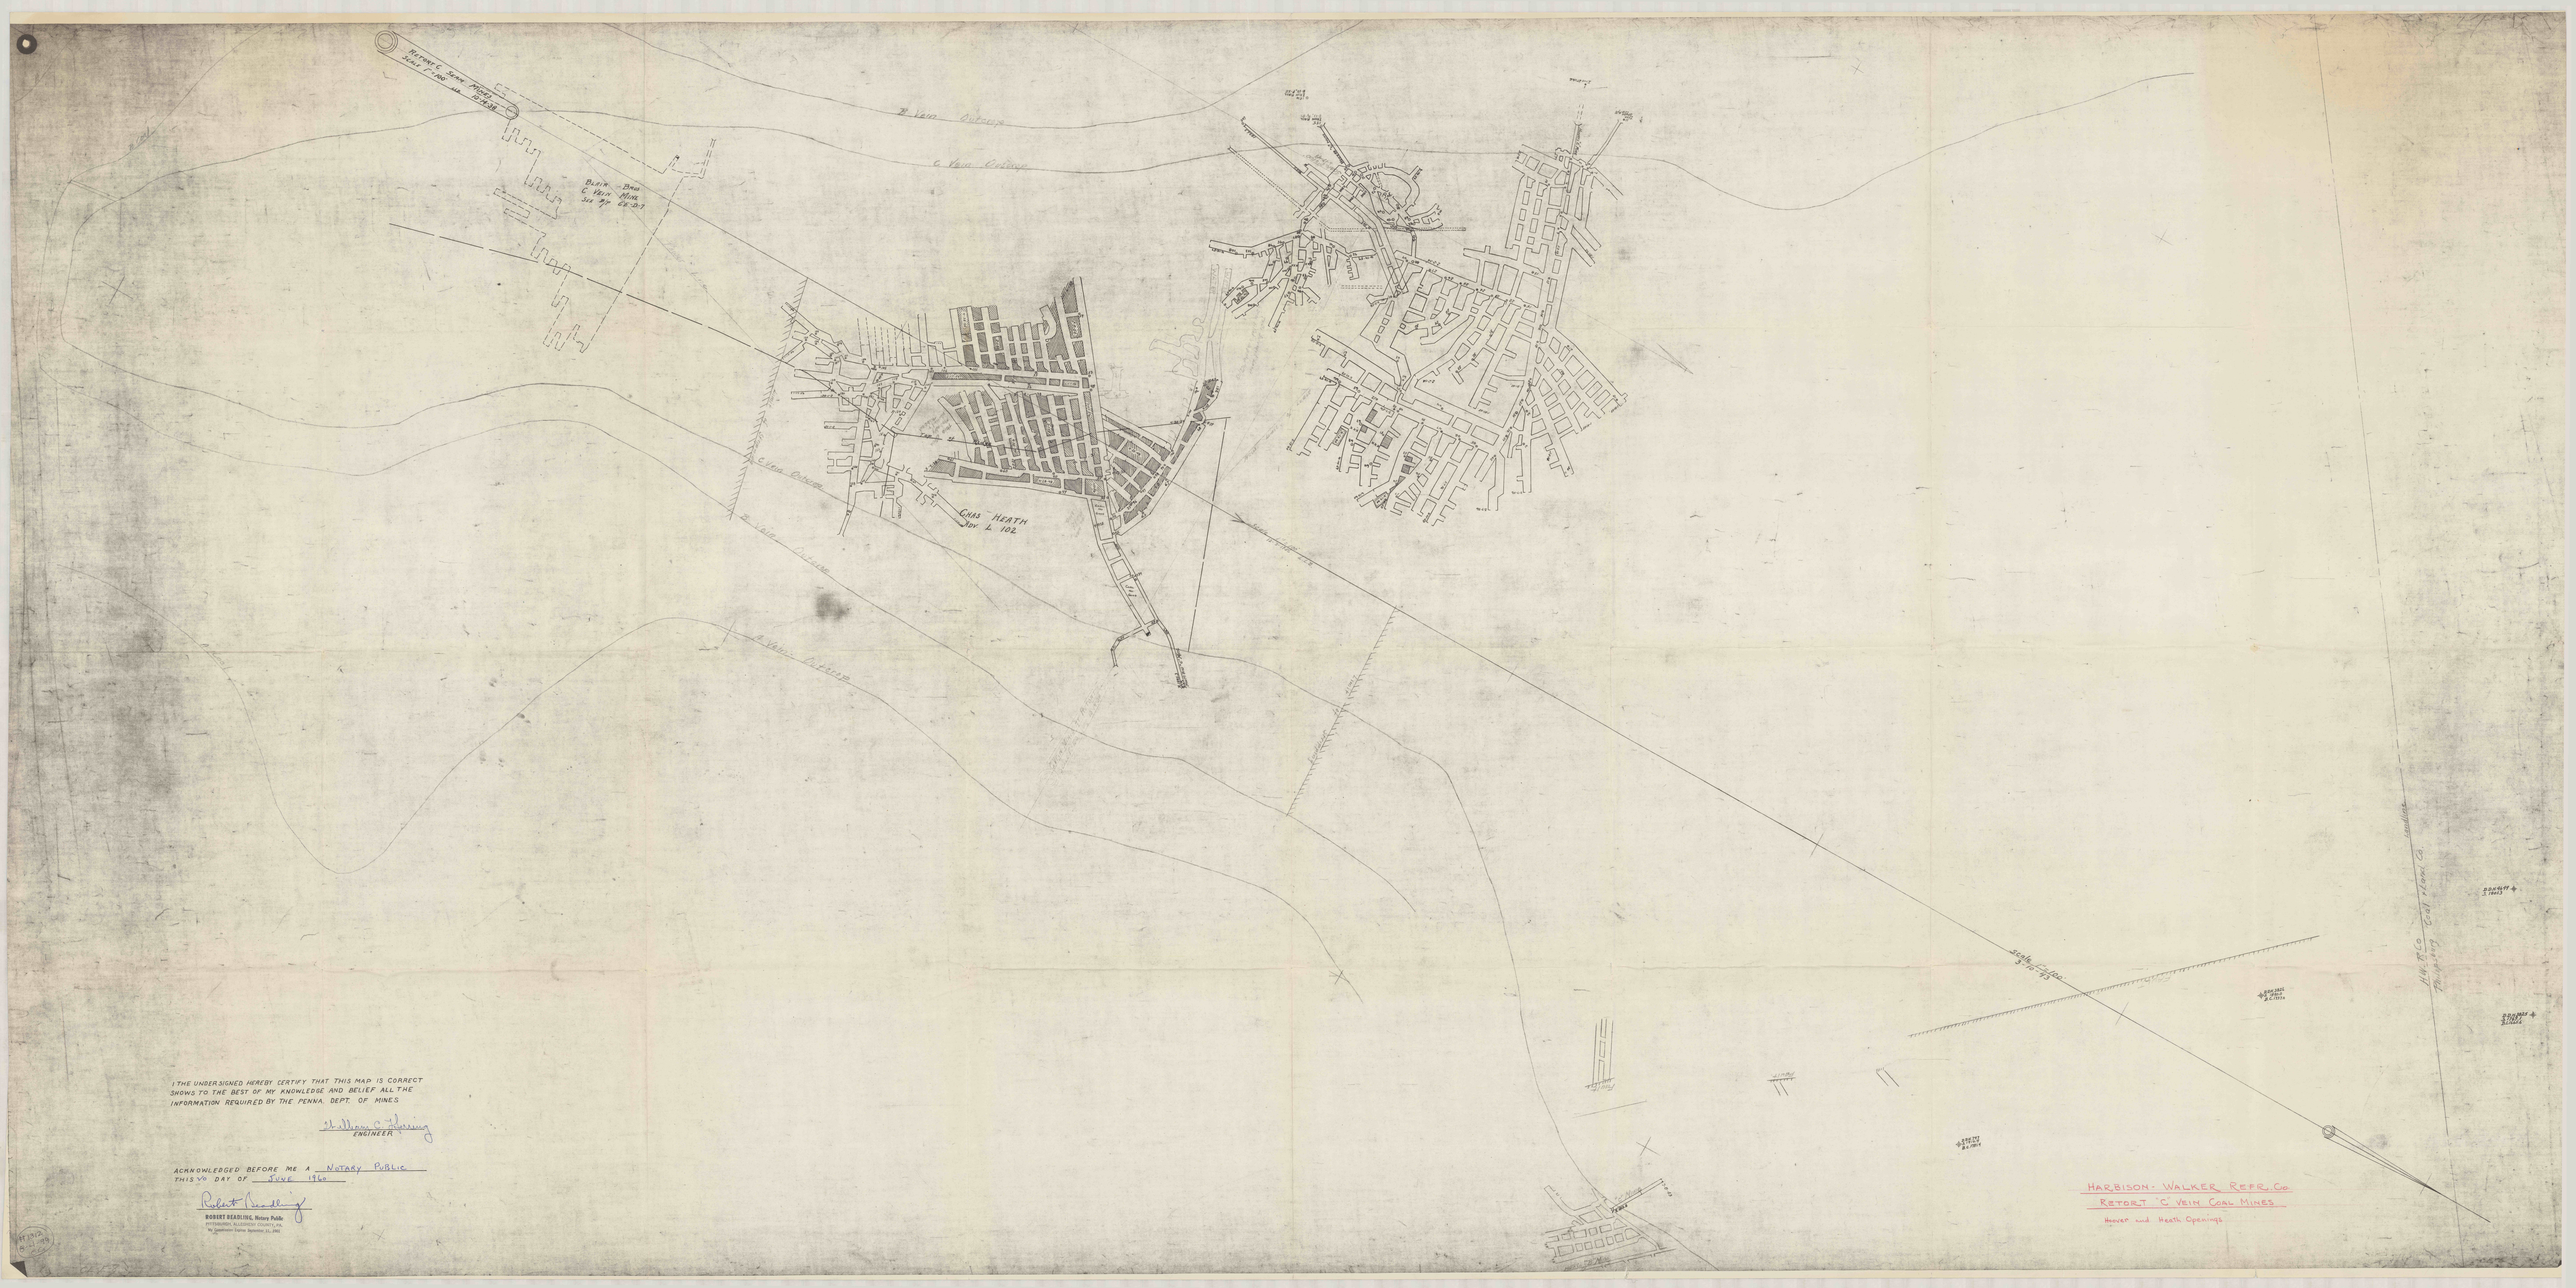

I THE UNDERSIGNED HEREBY CERTIFY THAT THIS MAP IS CORRECT SHOWS TO THE BEST OF MY KNOWLEDGE AND BELIEF ALL THE INFORMATION REQUIRED BY THE PENNA. DEPT. OF MINES

William G. Fleming
ENGINEER

ACKNOWLEDGED BEFORE ME A NOTARY PUBLIC
THIS 10 DAY OF June 1960

Robert Bradley

ROBERT BRADLEY, Notary Public
PITTSBURGH, ALLEGHENY COUNTY, PA.
My Commission Expires September 21, 1963

HARBISON-WALKER REFR. CO
RETORT 'C' VEIN COAL MINES
Hoover and Heath Openings