


J.C. Stinemar, Est.
"B" Seam.

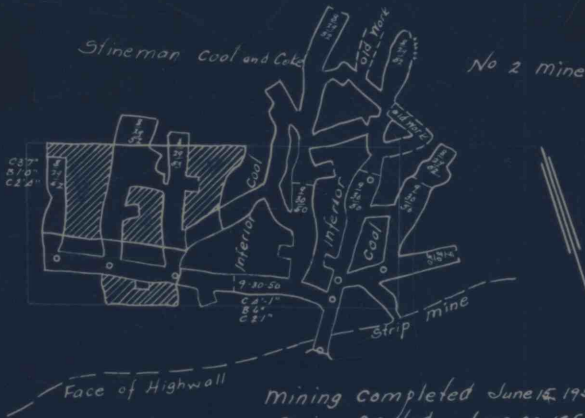

Mining Completed June 14, 1953
Mine Sealed June 20, 1953

I, Hereby certify that
this blue print is a true
and correct copy of the original
map of the H. C. Horner Mine
and that the original map
is a true complete and correct
map and survey of all the
excavations made in said mine.

D. Lewis Lee Hoffmann
R.P.E. 12667

Map Showing Mine Workings
of
H. C. Horner
Mine, "B" Seam.
Conemaugh Twp. Cambria Co., Pa.
Scale 1" = 100' Sept 30, 1950