


J.C. Stinemon. Est
"B" Seam.

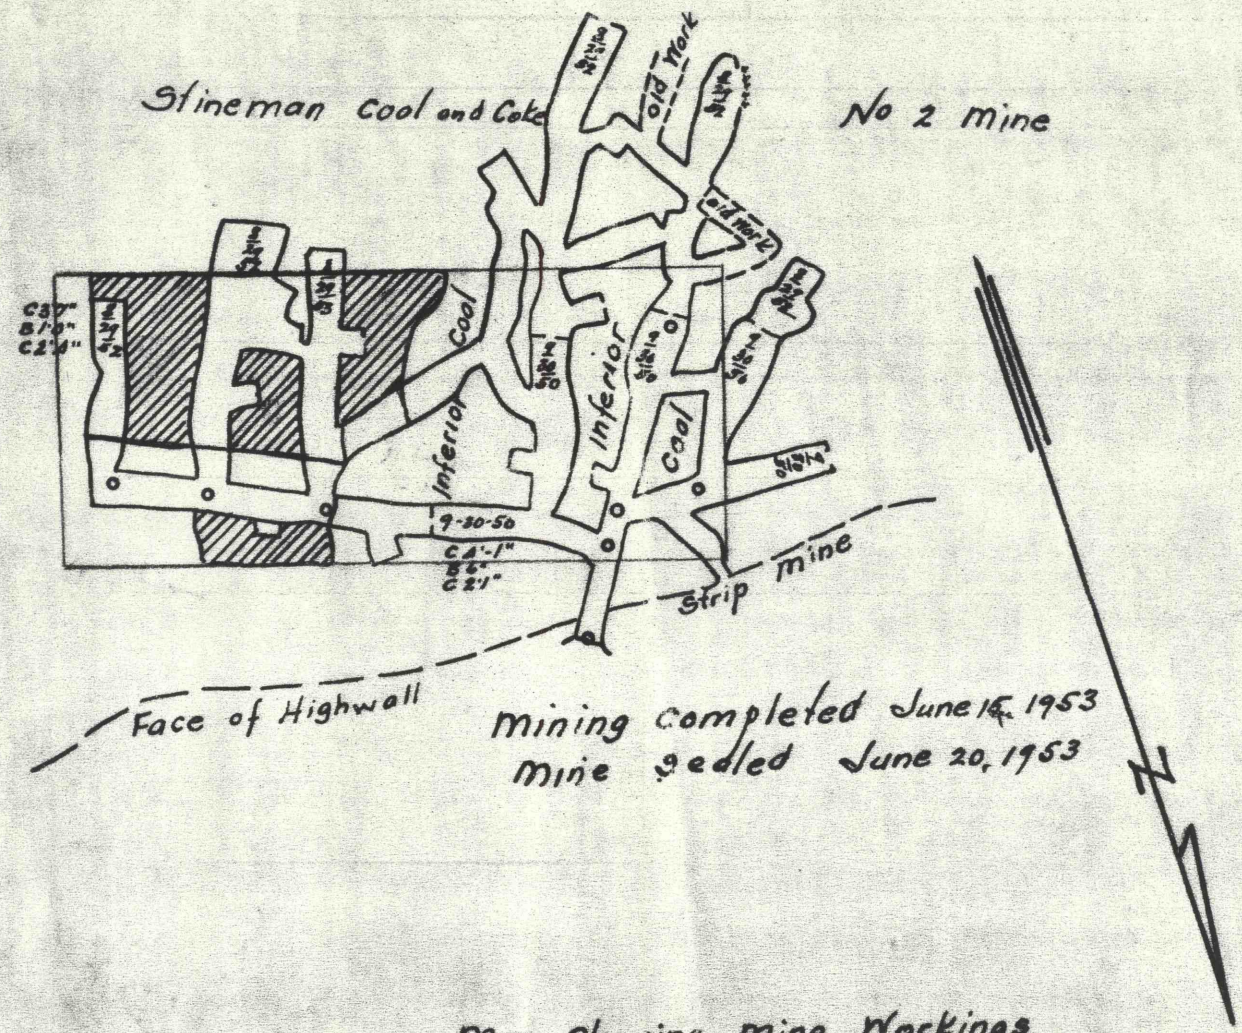

mining completed June 15, 1953
mine sealed June 20, 1953

Map showing mine workings
of
H. C. Horner
Mine, "B" Seam.
Conemaugh Twp. Cambria Co; Pa
Scale 1" = 100' Sept 30, 1950

I, Hereby certify that
this blue print is a true
and correct of the original
map of the H. C. Horner mine
and that the original map
is a true complete and correct
map and survey of all the
excavations made in said mine.

Oliver Lee Hoffmann
R.P.E. 12667

DEC 08 1982

#1316
8-4-99
C.C.