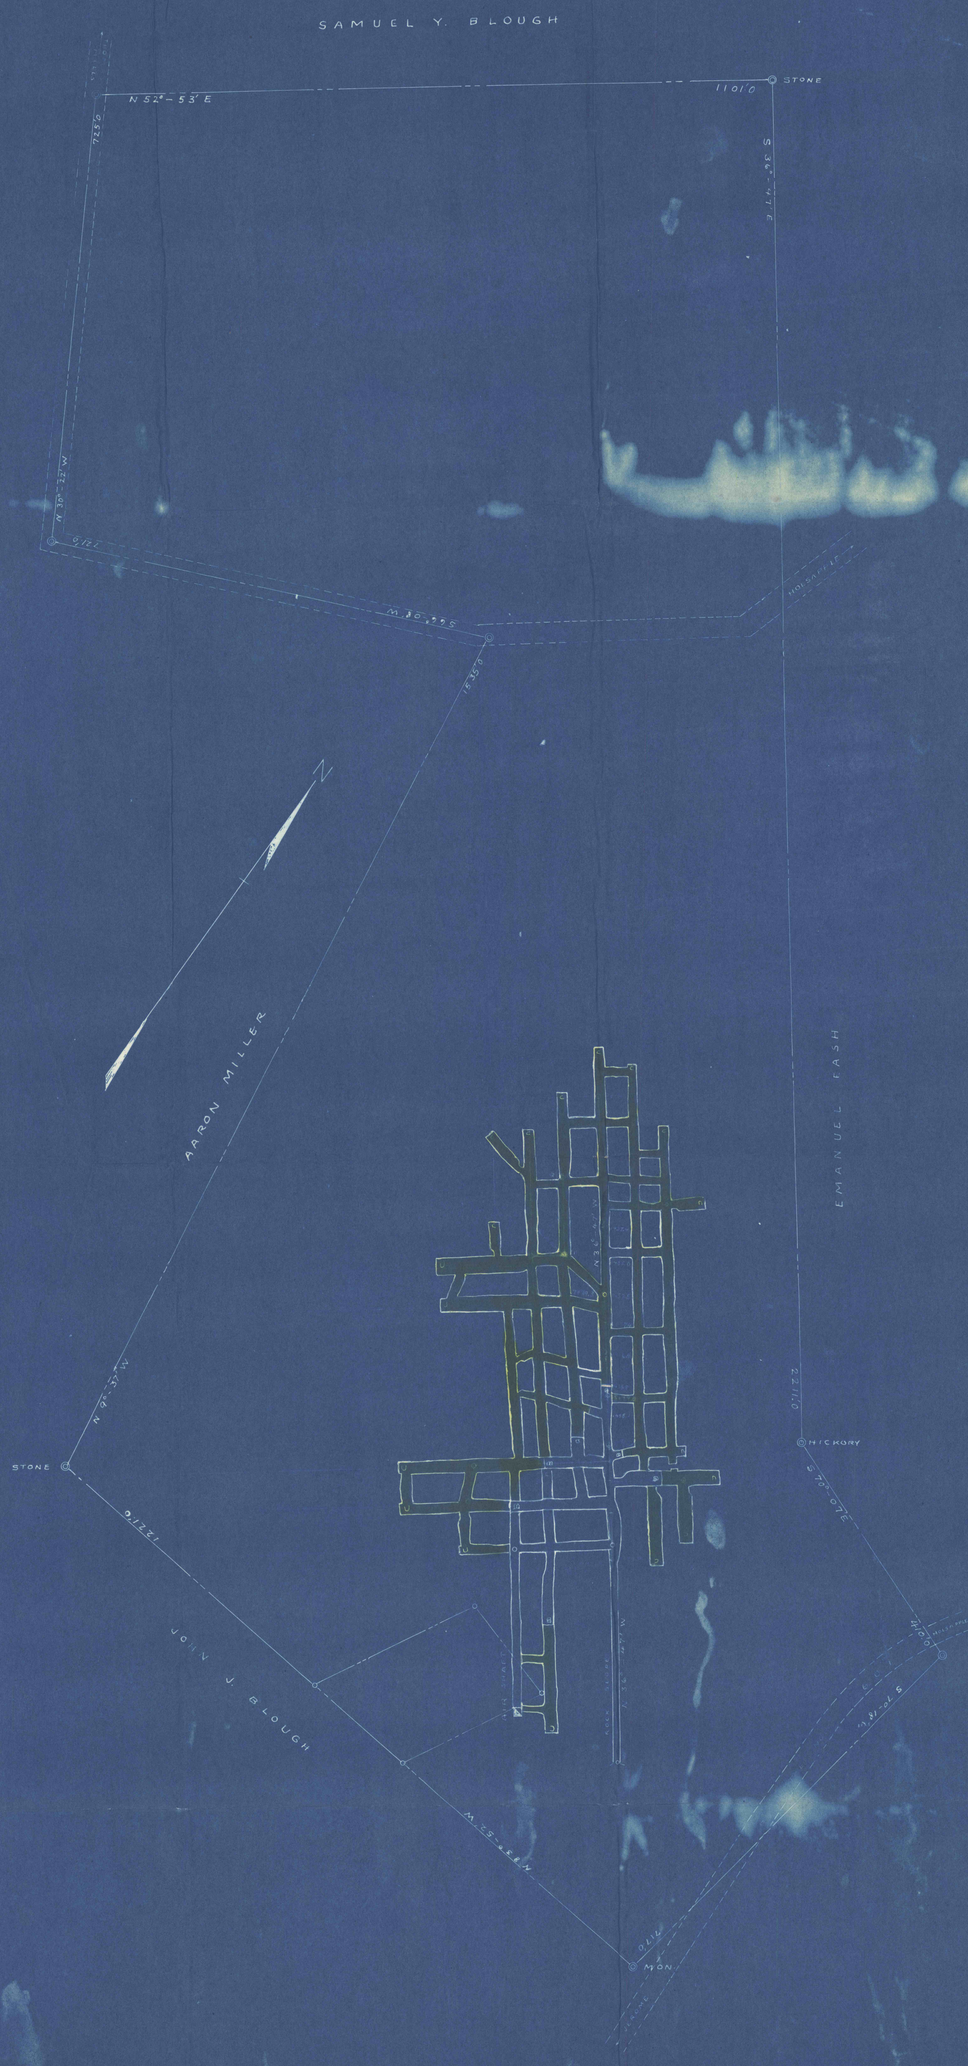

HORRELL COAL CO.

MINING OPERATIONS "B" SEAM

CONEMAUGH TWP. SOMERSET CO. PA.

SCALE 1" = 100' DECEMBER 28 1953

VICTOR B. HOLTZAPPLE, REG. PROF. ENGR. SURVEYING

JOHNSTOWN PENNA.

SURVEY INDEX

LETTER	DATE	SURVEYED	PLOTTED
B	WORKING	REVISED TO	HORRELL
C	JAN. 9 1954	HOLTZAPPLE	HOLTZAPPLE