


BEATTY MINE  
MT PLEASANT COKE CO.  
*Elevations in parenthesis are from HC Frick Coke Co. data.*

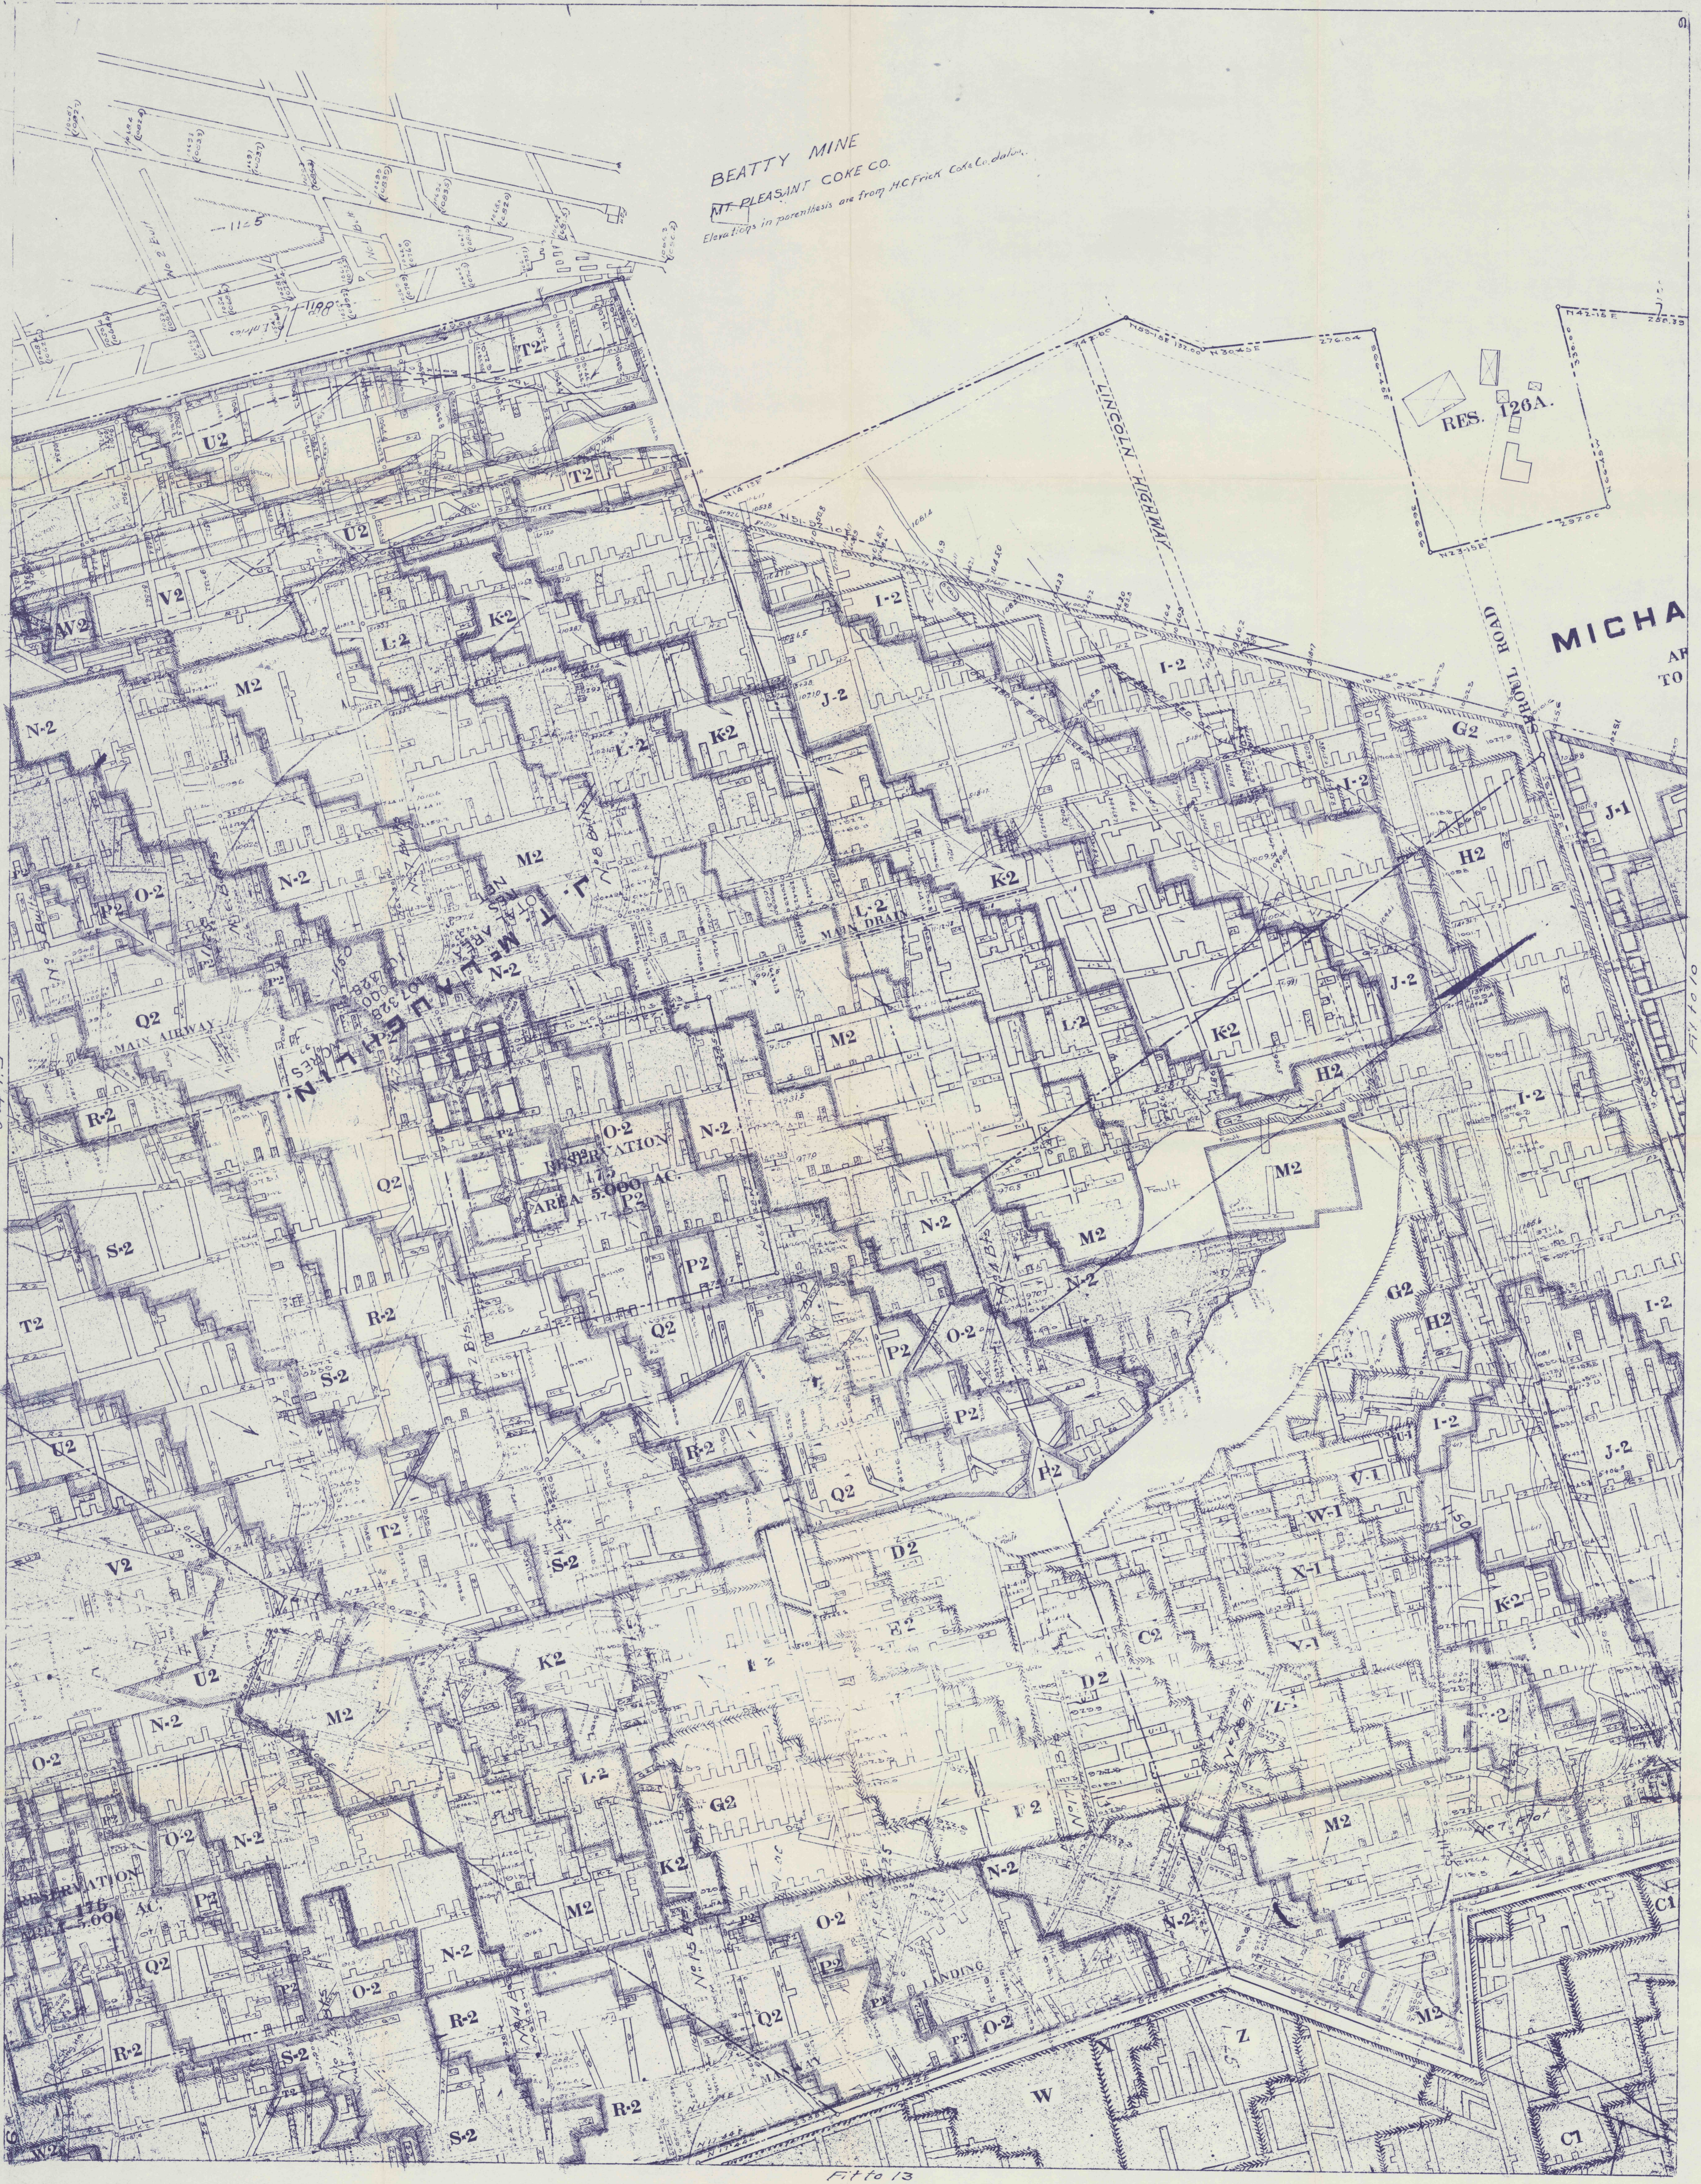

M-9  

MICHA  
AF  
TO

8 of 13


M-9


