


W-4
Whitney

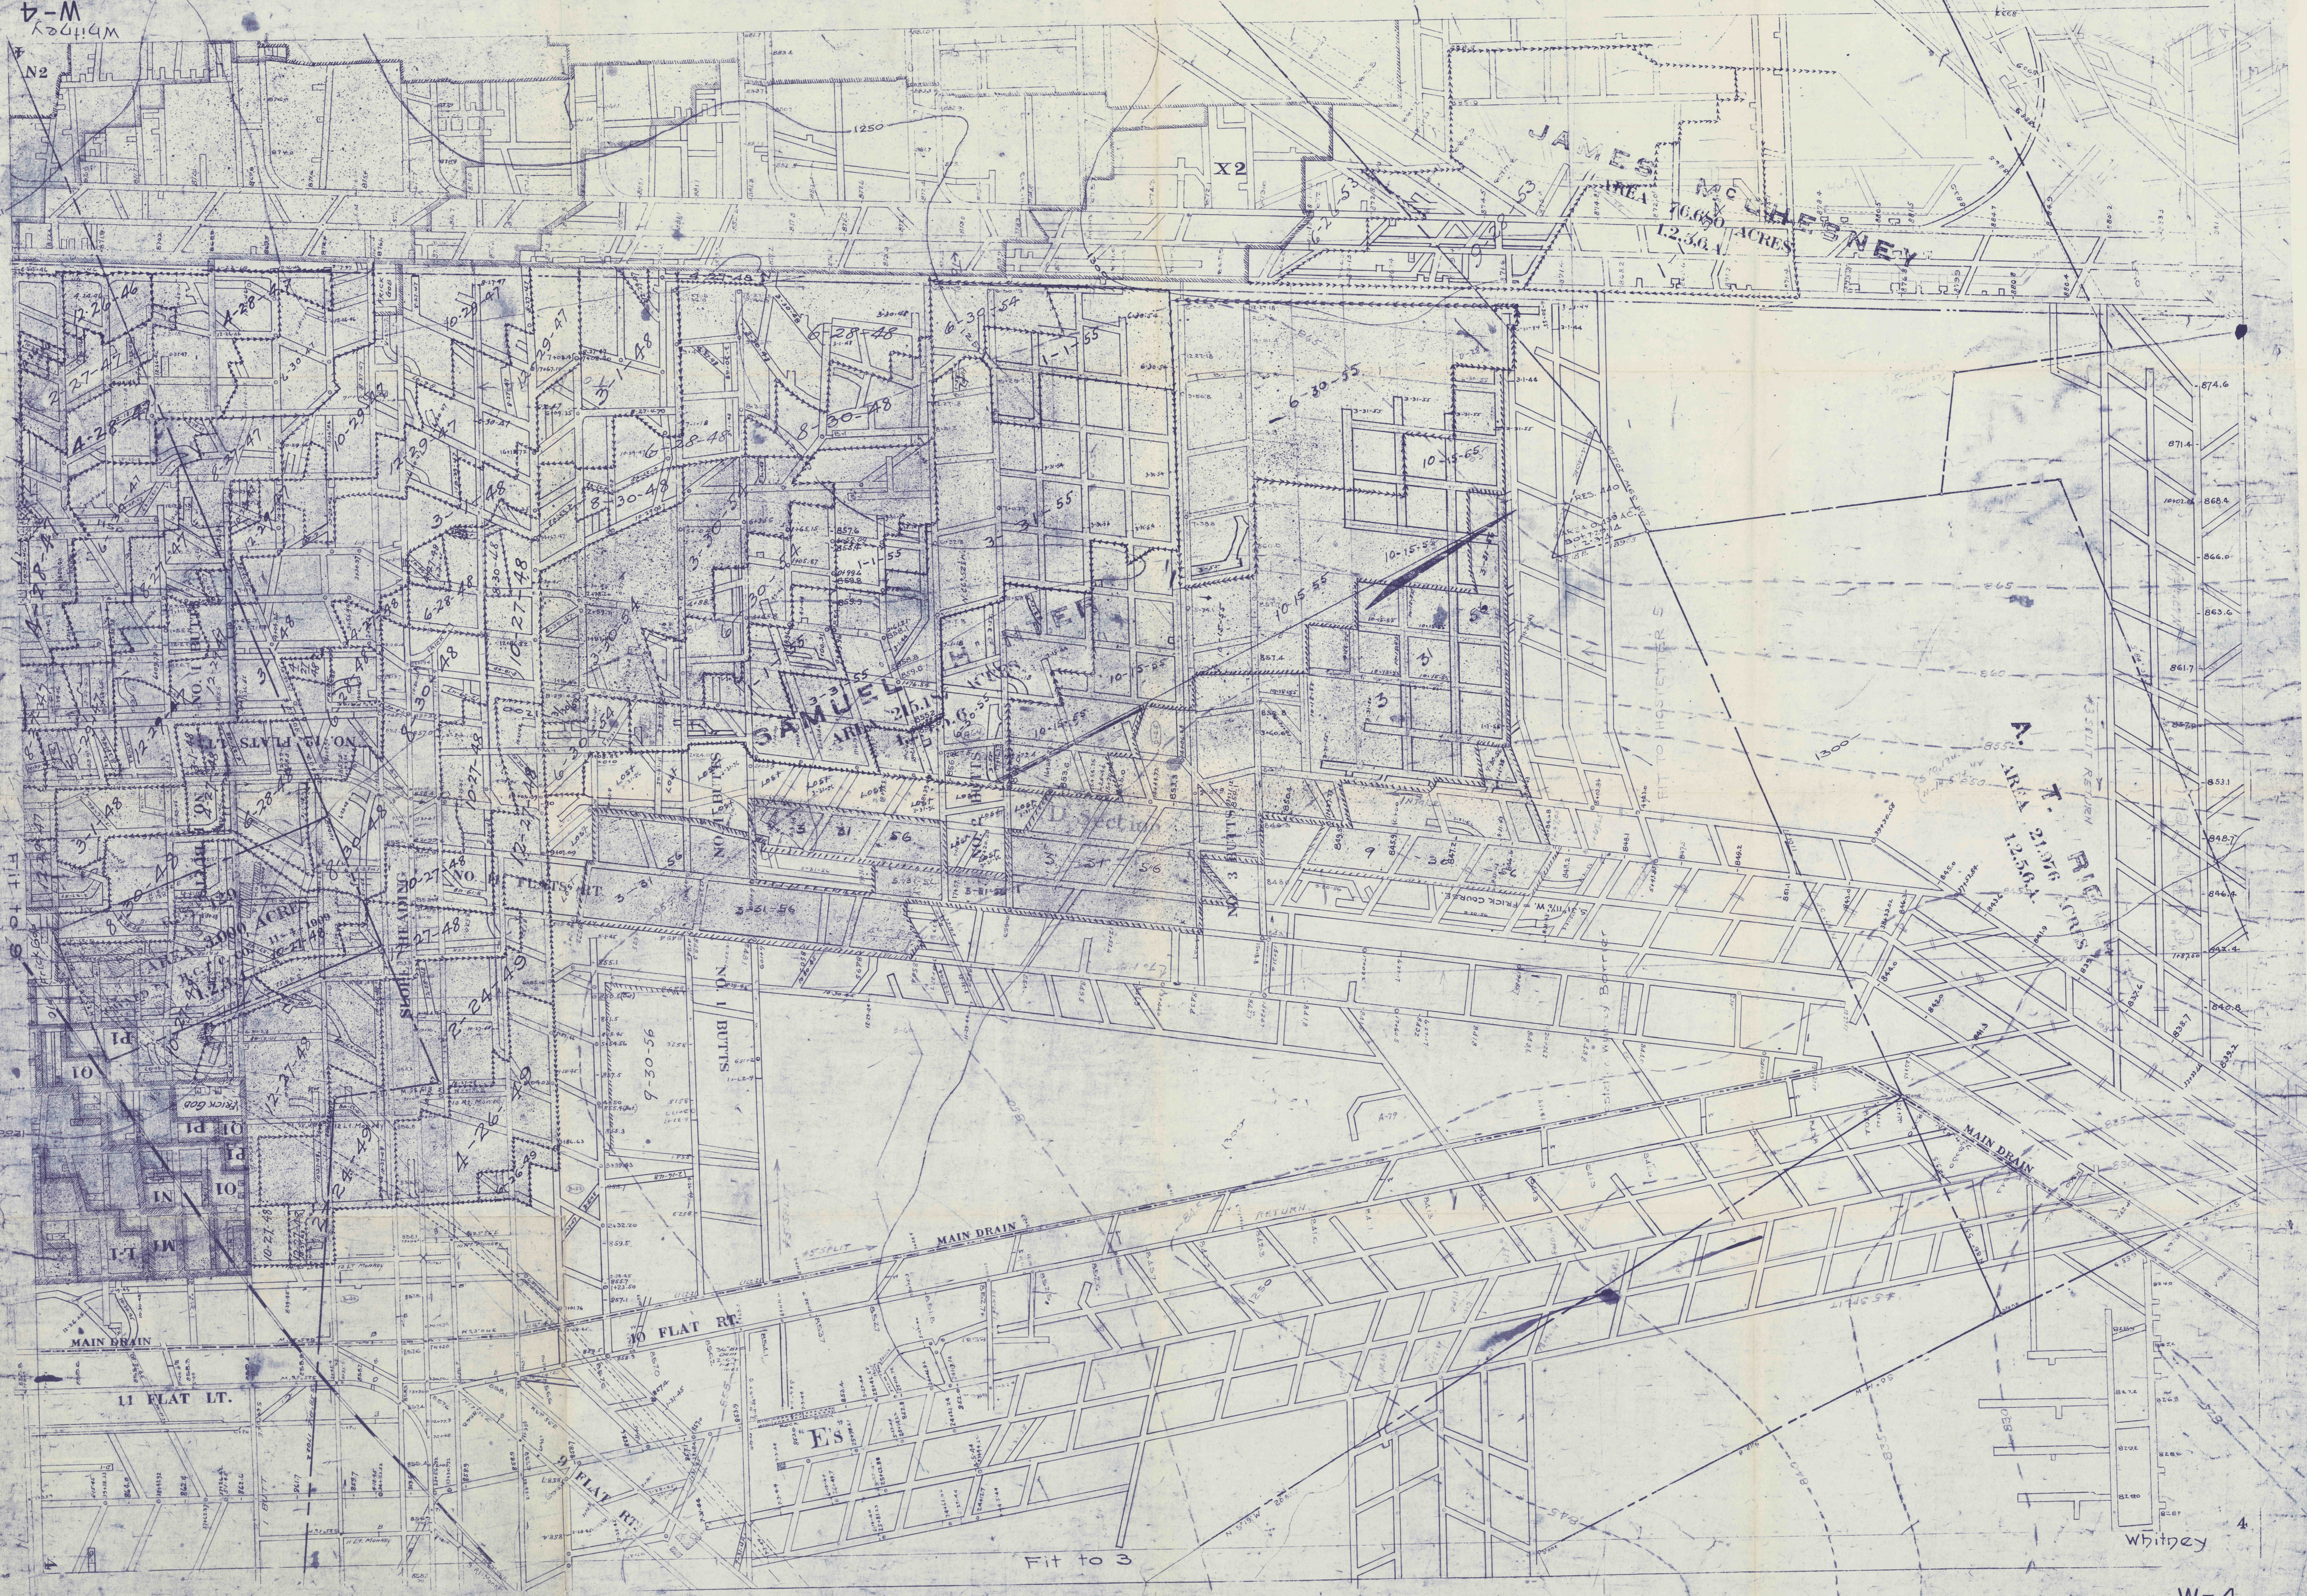

JAMES AREA

215.1

A. T. RIGGINS
12.56 ACRES

11 FLAT LT.

10 FLAT RT.

ES

Fit to 3

Whitney

W-4