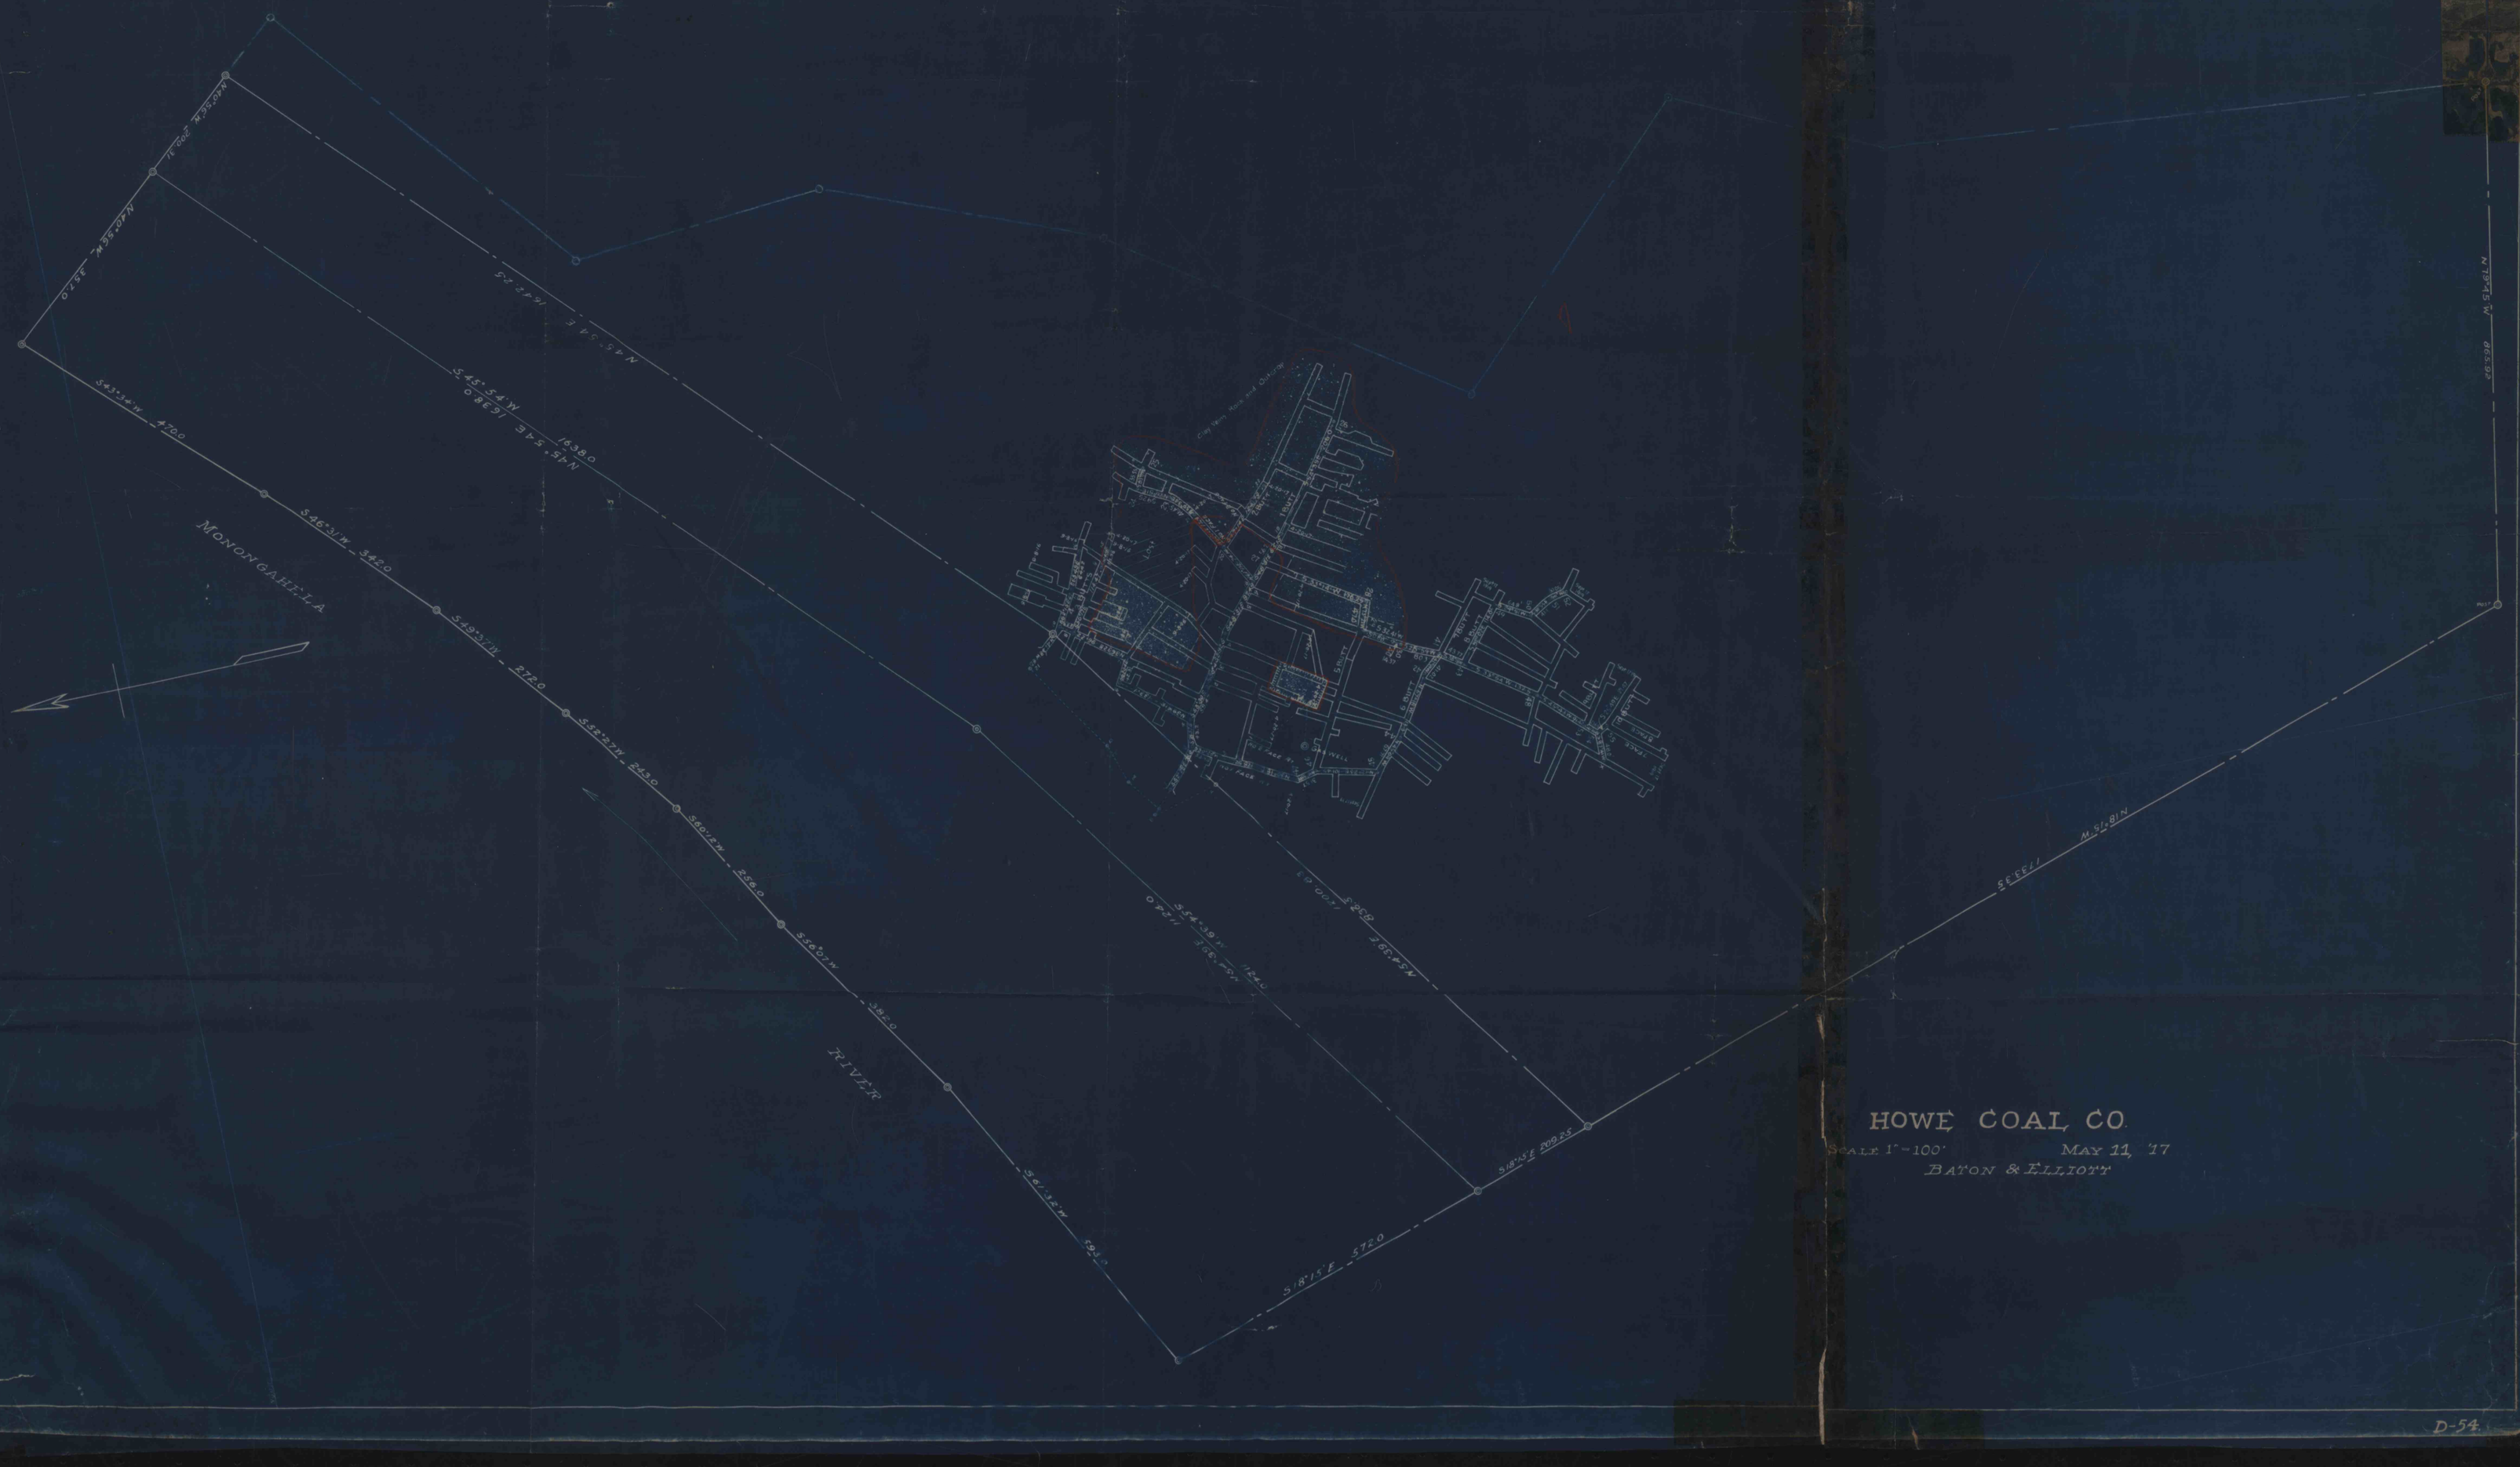

HOWE COAL CO.

SCALE 1" = 100' MAY 11, '17

BATON & ELLIOTT

D-54.