


3086-1-33

3086-1-33

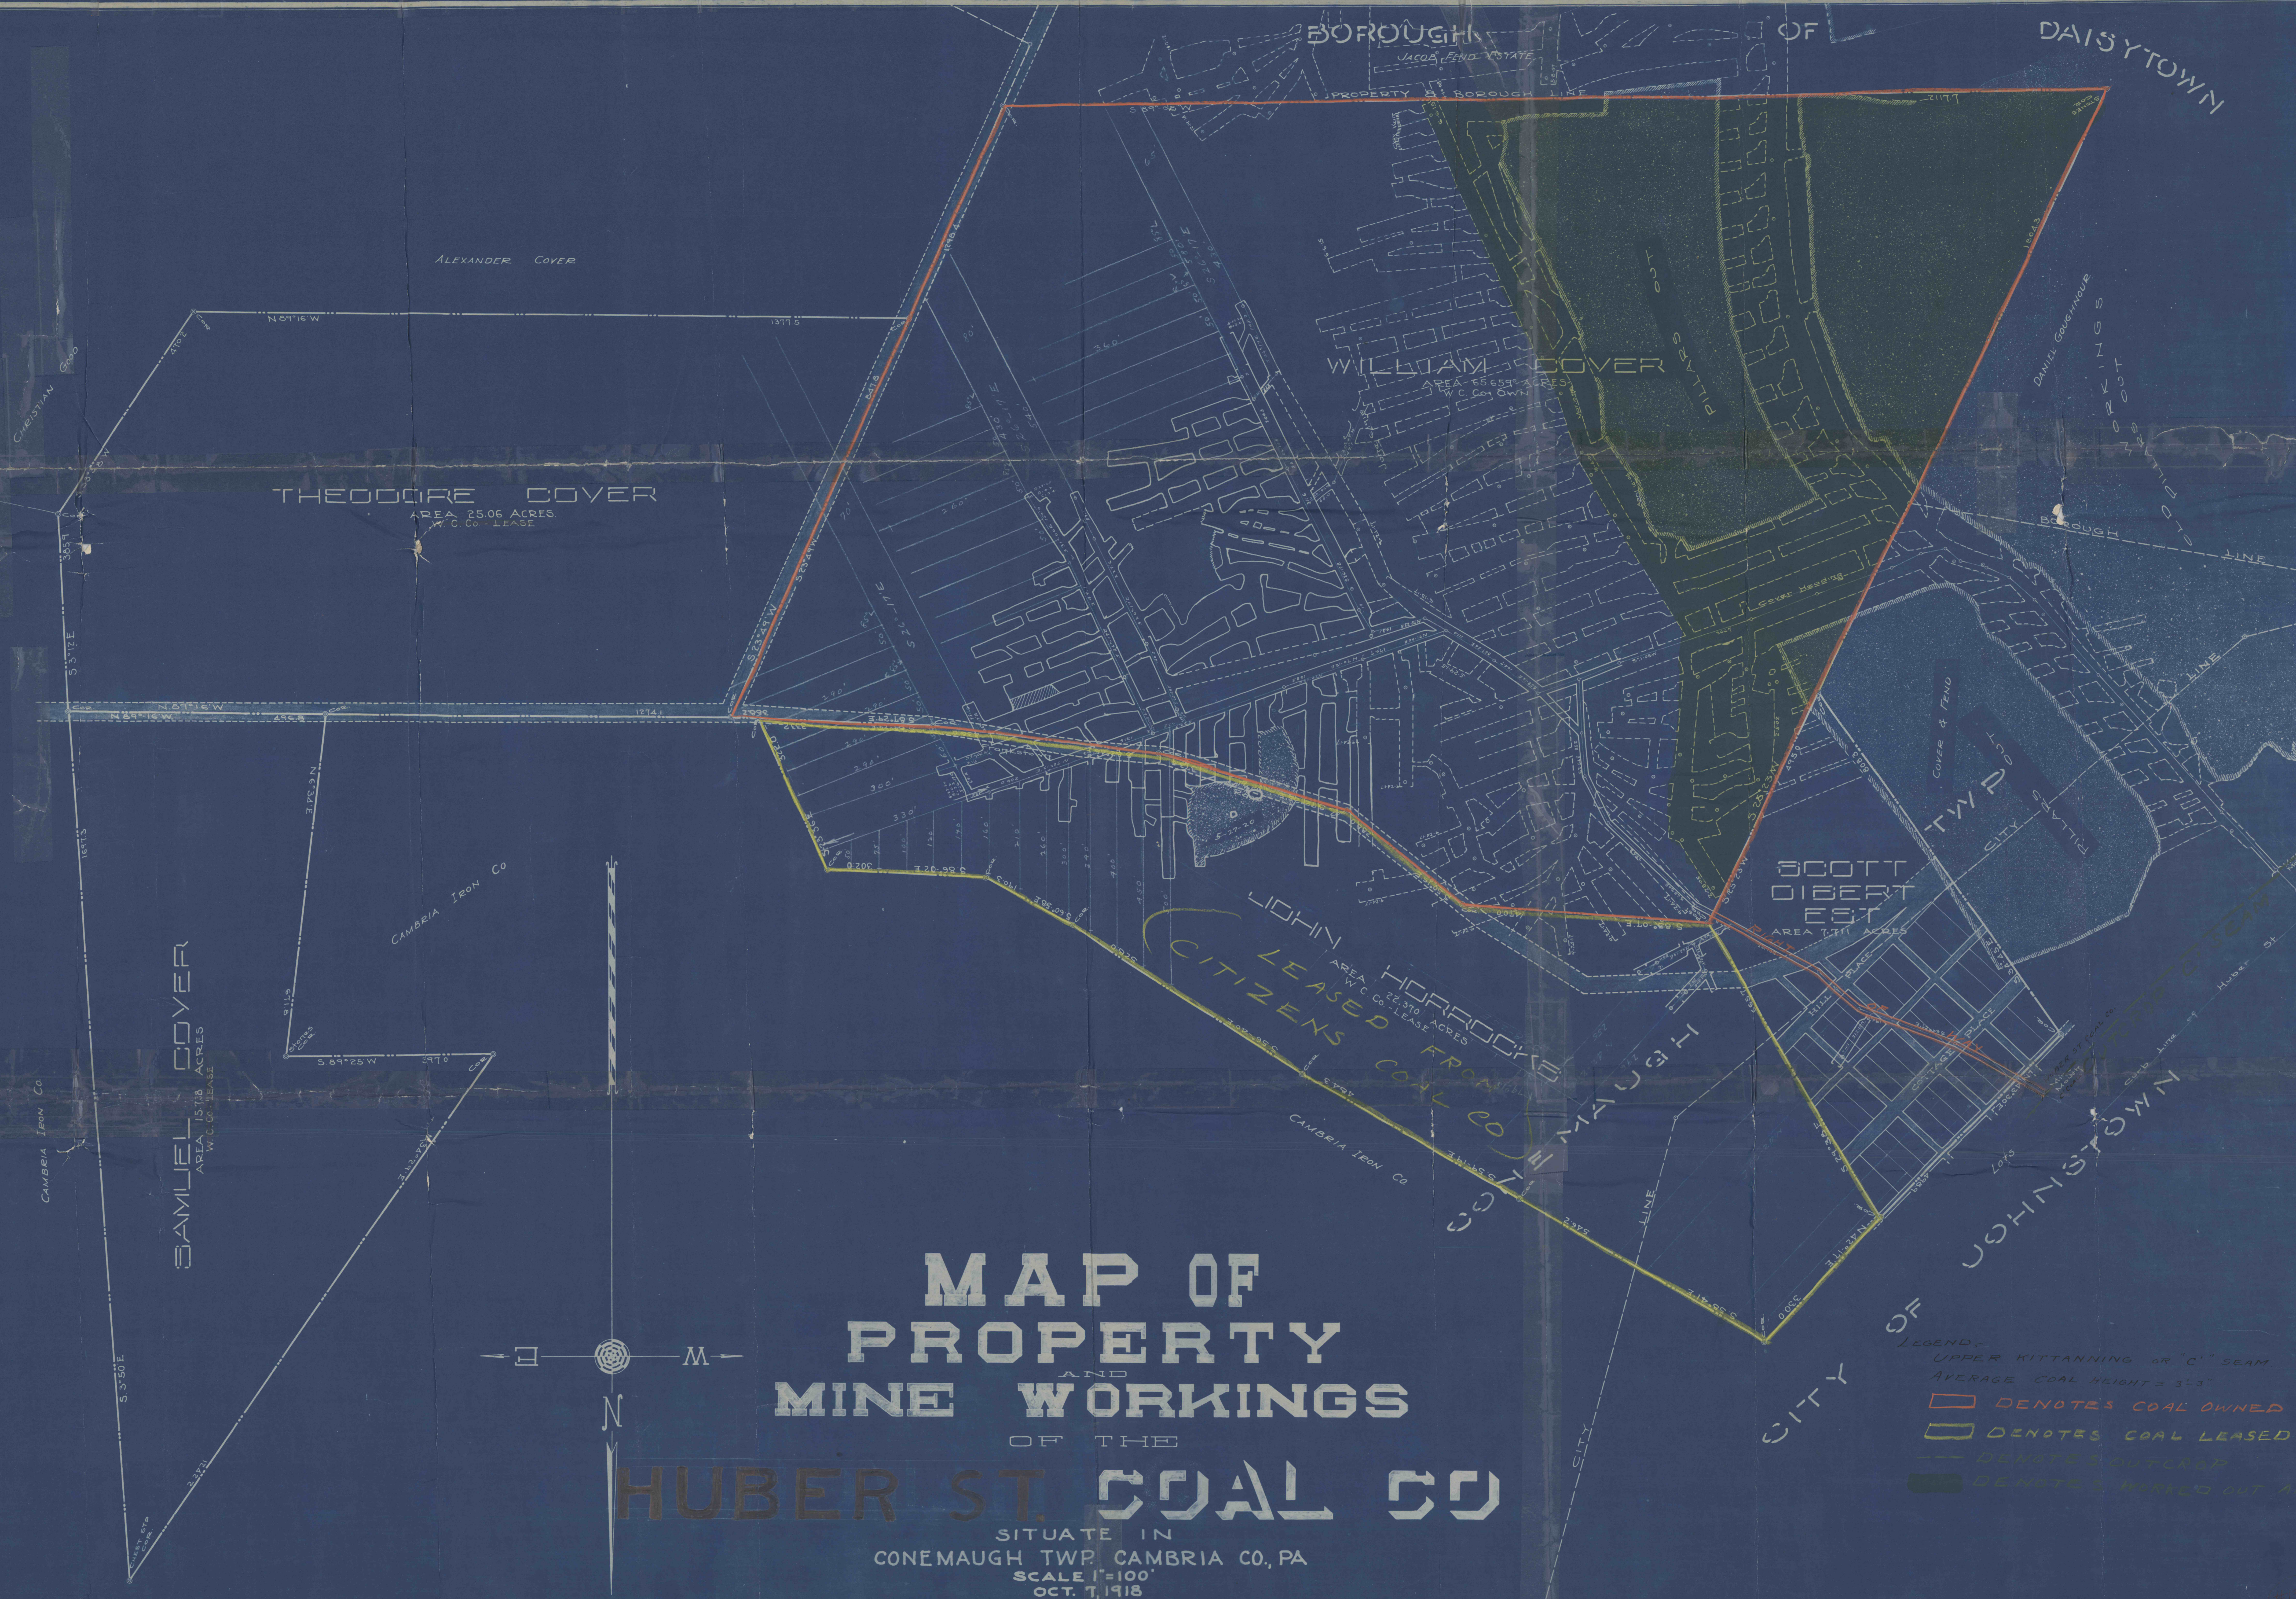

**MAP OF  
PROPERTY  
AND  
MINE WORKINGS  
OF THE  
HUBER ST. COAL CO**

SITUATE IN  
CONEMAUGH TWP. CAMBRIA CO., PA  
SCALE 1"=100'  
OCT. 1, 1918  
FETTERMAN ENGR. CO.

- LEGEND-
- UPPER KITTANNING OR "C" SEAM  
AVERAGE COAL HEIGHT = 3'-3"
  - DENOTES COAL OWNED
  - DENOTES COAL LEASED
  - DENOTES OUTCROP
  - DENOTES MINE'S OUT AREA

3086-1-33