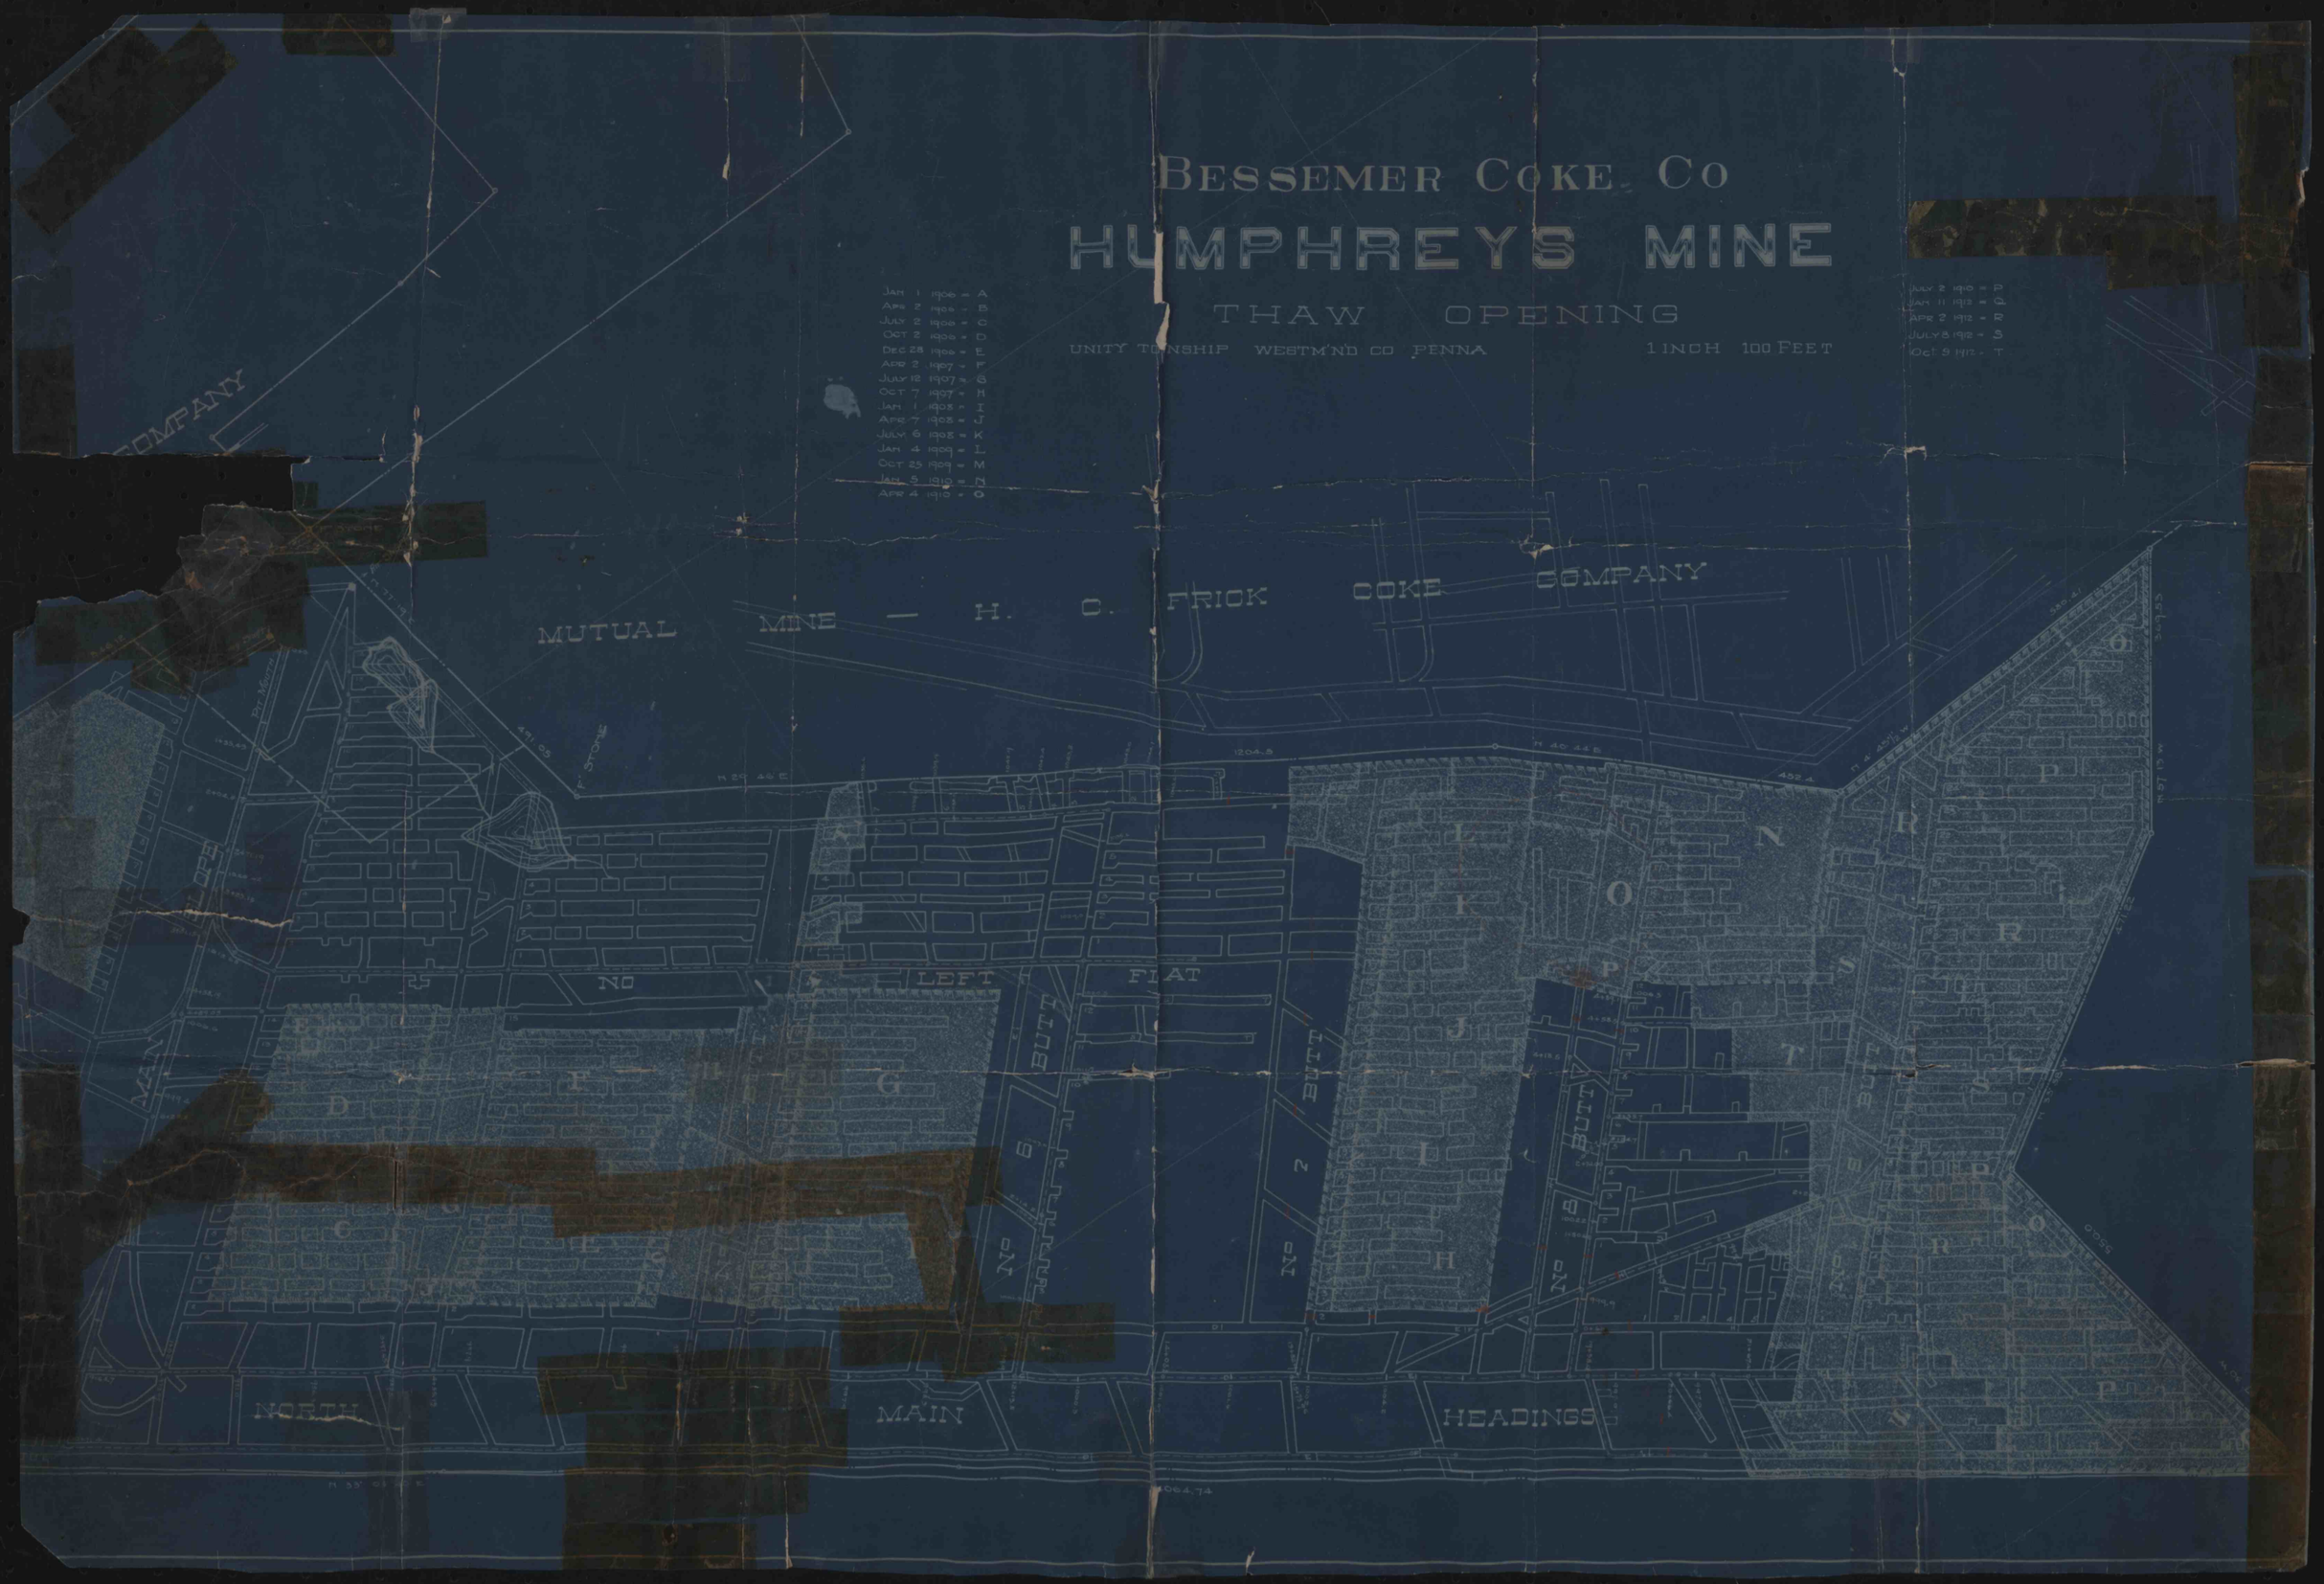
BESSEMER COKE CO
HUMPHREYS MINE
THAW OPENING
UNITY TOWNSHIP WESTM'ND CO PENNA
1 INCH 100 FEET
JAN 1 1906 = A
APR 2 1906 = B
JULY 2 1906 = C
OCT 2 1906 = D
DEC 28 1906 = E
APR 2 1907 = F
JULY 12 1907 = G
OCT 7 1907 = H
JAN 1 1908 = I
APR 7 1908 = J
JULY 6 1908 = K
JAN 4 1909 = L
OCT 25 1909 = M
JAN 5 1910 = N
APR 4 1910 = O
JULY 2 1910 = P
JAN 11 1912 = Q
APR 2 1912 = R
JULY 8 1912 = S
OCT 9 1912 = T
COMPANY
MUTUAL MINE — H. C. FRICK COKE COMPANY
NO LEFT FLAT
BUTT
NO 6
NO 2
NO 8
NORTH MAIN HEADINGS