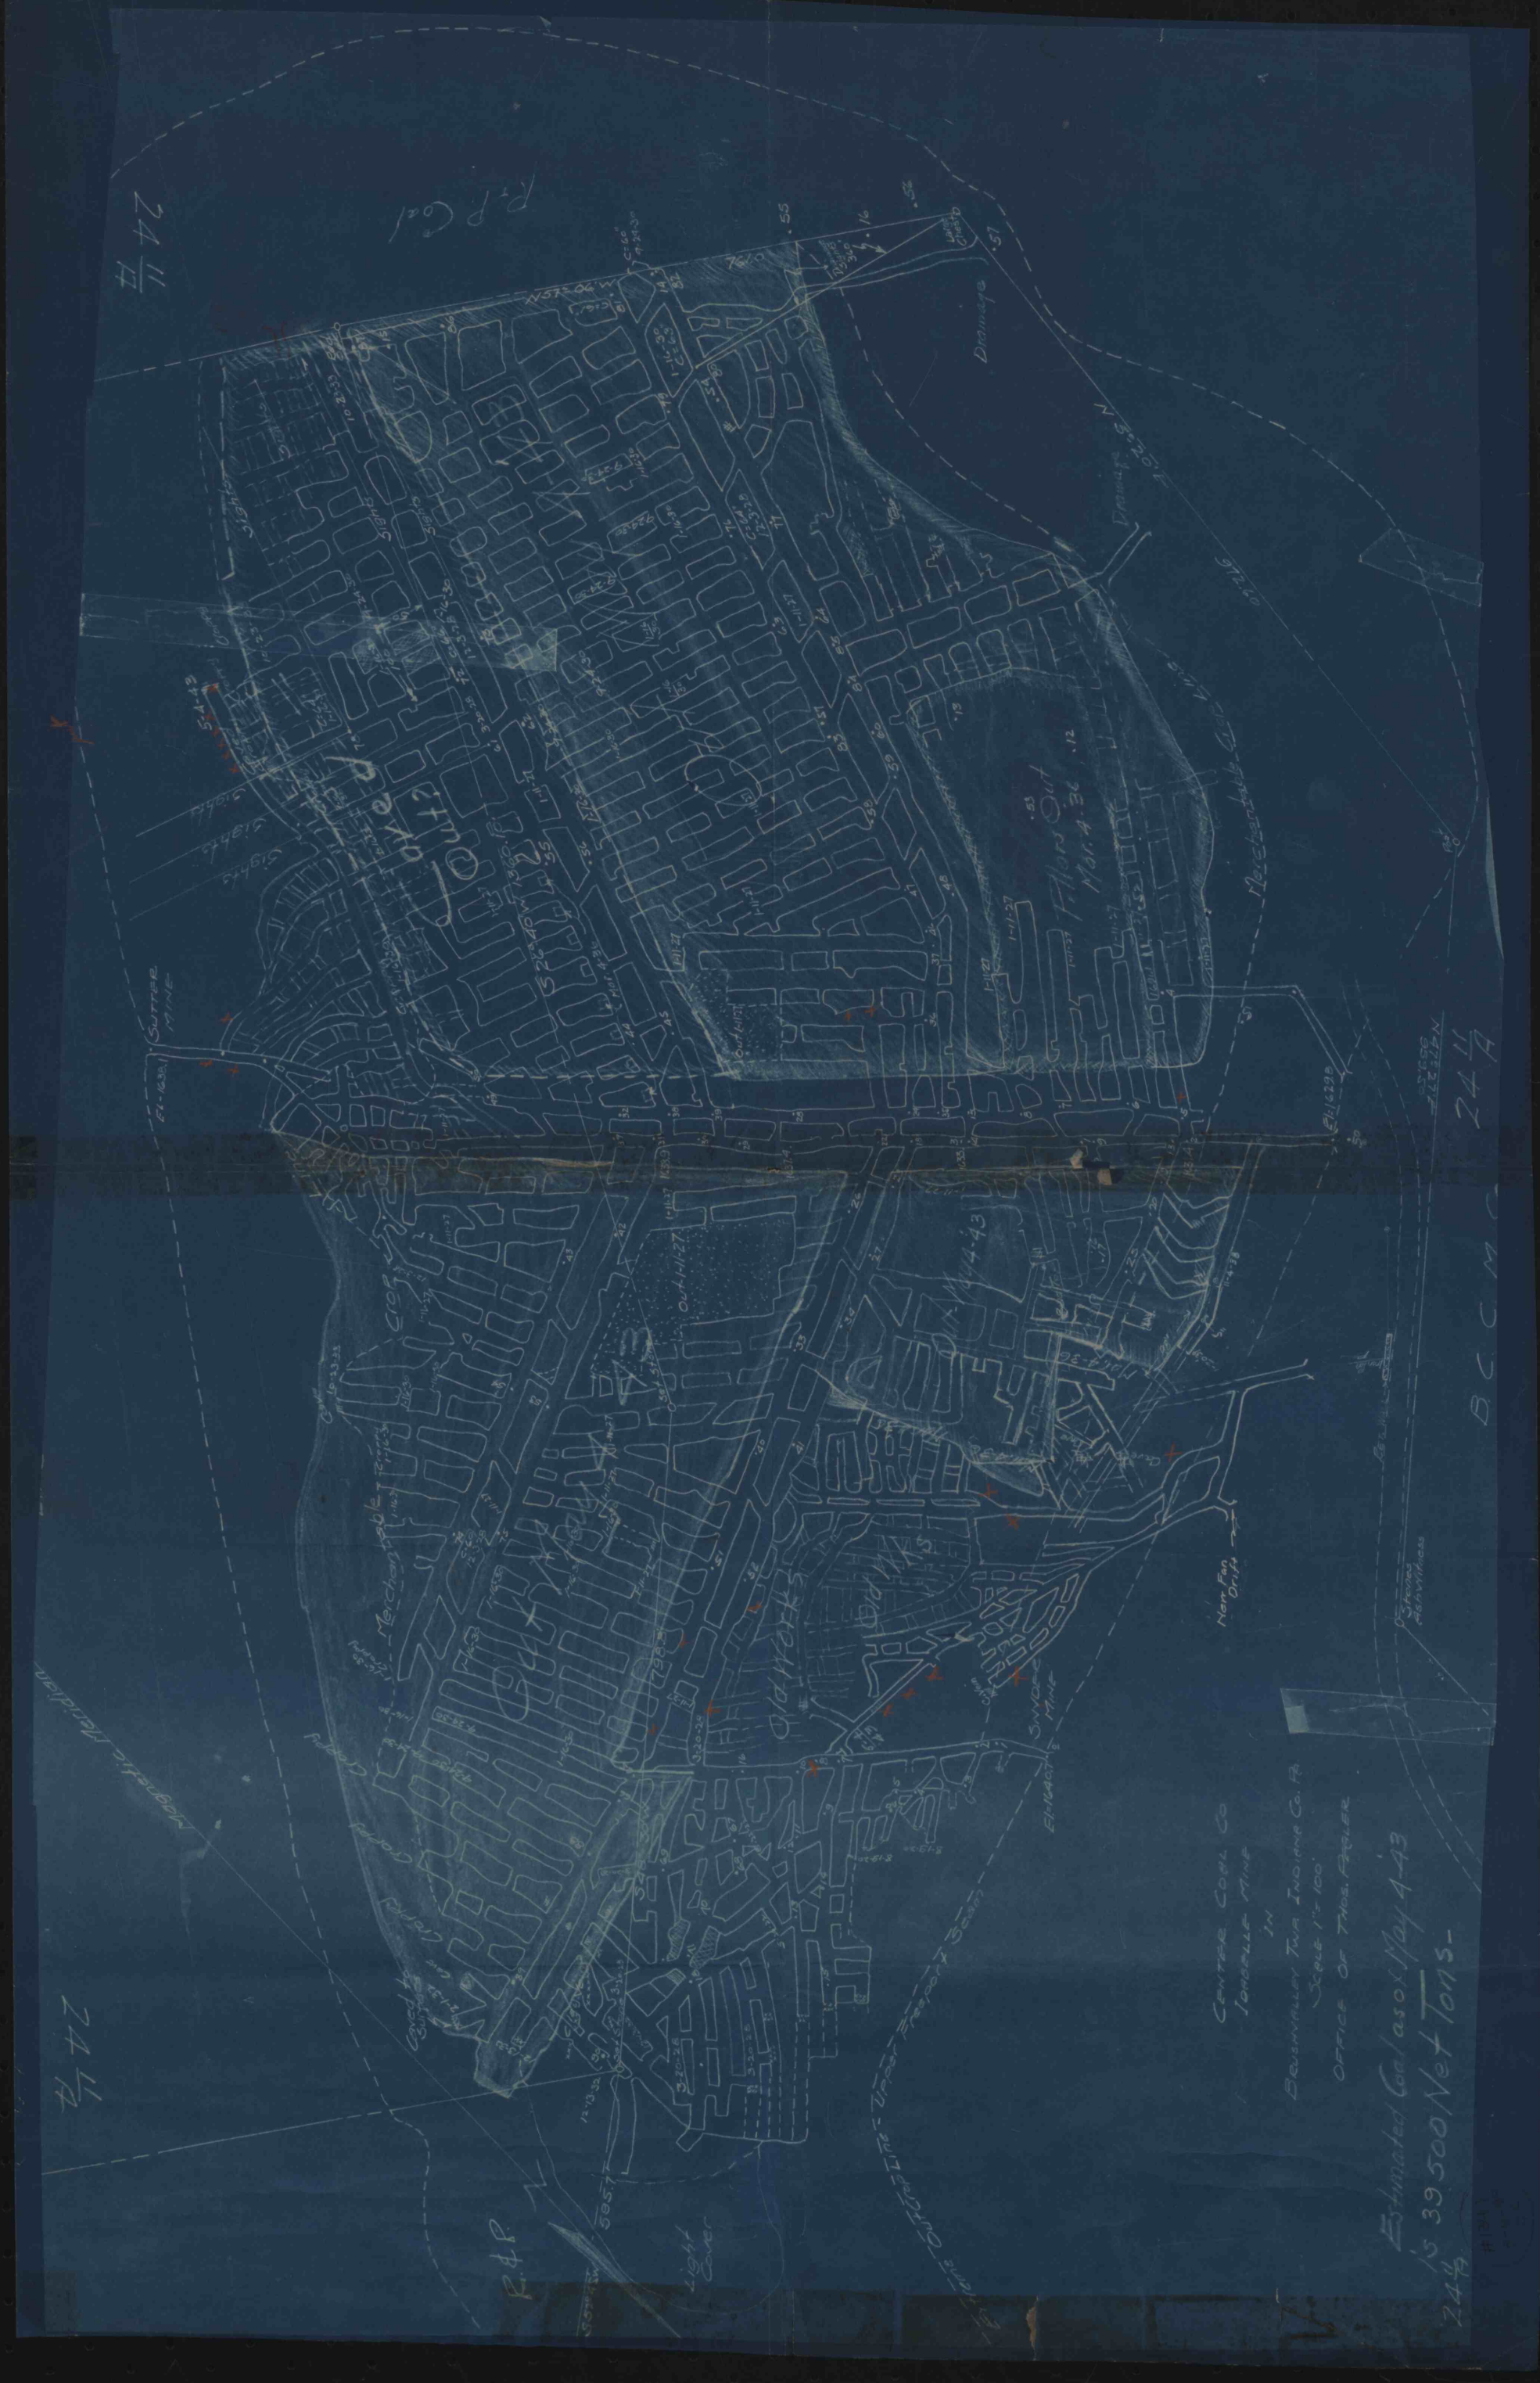
Center Coal Co
Isabelle Mine
In
Scale 1" = 100'
Office of Thos. Parker
Estimated Coal as of May 4-43
Drainage
Upper Freeport Seam
Main Entry
Old Works
Old Workings
Sutter Mine
Mercer Table
Mercer Table Crop
Light Cover
Magnetic Meridian
Fan Drift
Surface Ashwillage
Mar. 4-36
Dec. 1-11-27
Jan. 1-11-27
Mar. 4-36
Mar. 4-36
Mar. 4-36