


450-2

Warnick Engineering Co.
 REGISTERED PROFESSIONAL ENGINEERS
 106 E. WALNUT ST.
 BUTLER, PENNA.

WARNICK & TREFRY
 REGISTERED PROFESSIONAL ENGINEERS
 BUTLER, PENNA.

MINE MAP
M. D. COAL COMPANY
IMBRIE MINE
 MADE BY R.S.M.
 DATE 12-11-51
 CHK'D.
 APP'VD.
 DATE
 SCALE 1" = 100'
 Summit Township, Butler County,
 Pennsylvania
 DRAWING 450-2

REVISIONS			
NO.	BY	REVISION	DATE
1		Mine Advances R.S.M. Property Lines	12-21-51

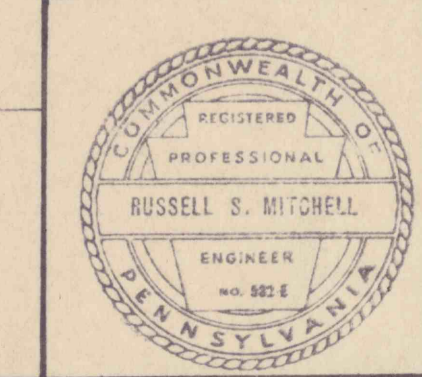

Note - Locations of mine workings shown by dotted lines were obtained from sources other than actual measurement. Property lines were not surveyed.