




Note - Locations of mine workings shown by dotted lines were obtained from sources other than actual measurement. Property lines were not surveyed.

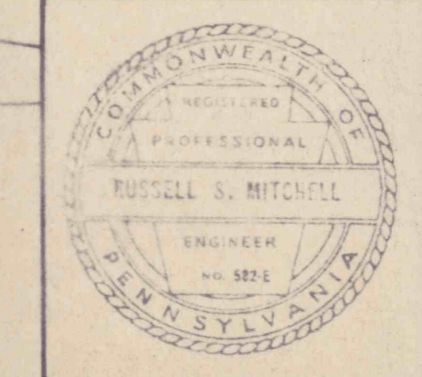

REVISIONS			
NO.	BY	REVISION	DATE
1	R.S.M.	Mine Advances Property Lines	12-21-51

Warnick Engineering Co.
REGISTERED PROFESSIONAL ENGINEERS
106 E WALNUT ST.
BUTLER, PA.

WARNICK & TREFRY
BUTLER, PENNA.

MINE MAP
M.D. COAL COMPANY
IMBRIE MINE

MADE R.S.M.
DATE 12-11-51
Summit Township, Butler County,
Pennsylvania

SCALE 1" = 100'
DRAWING 450-1