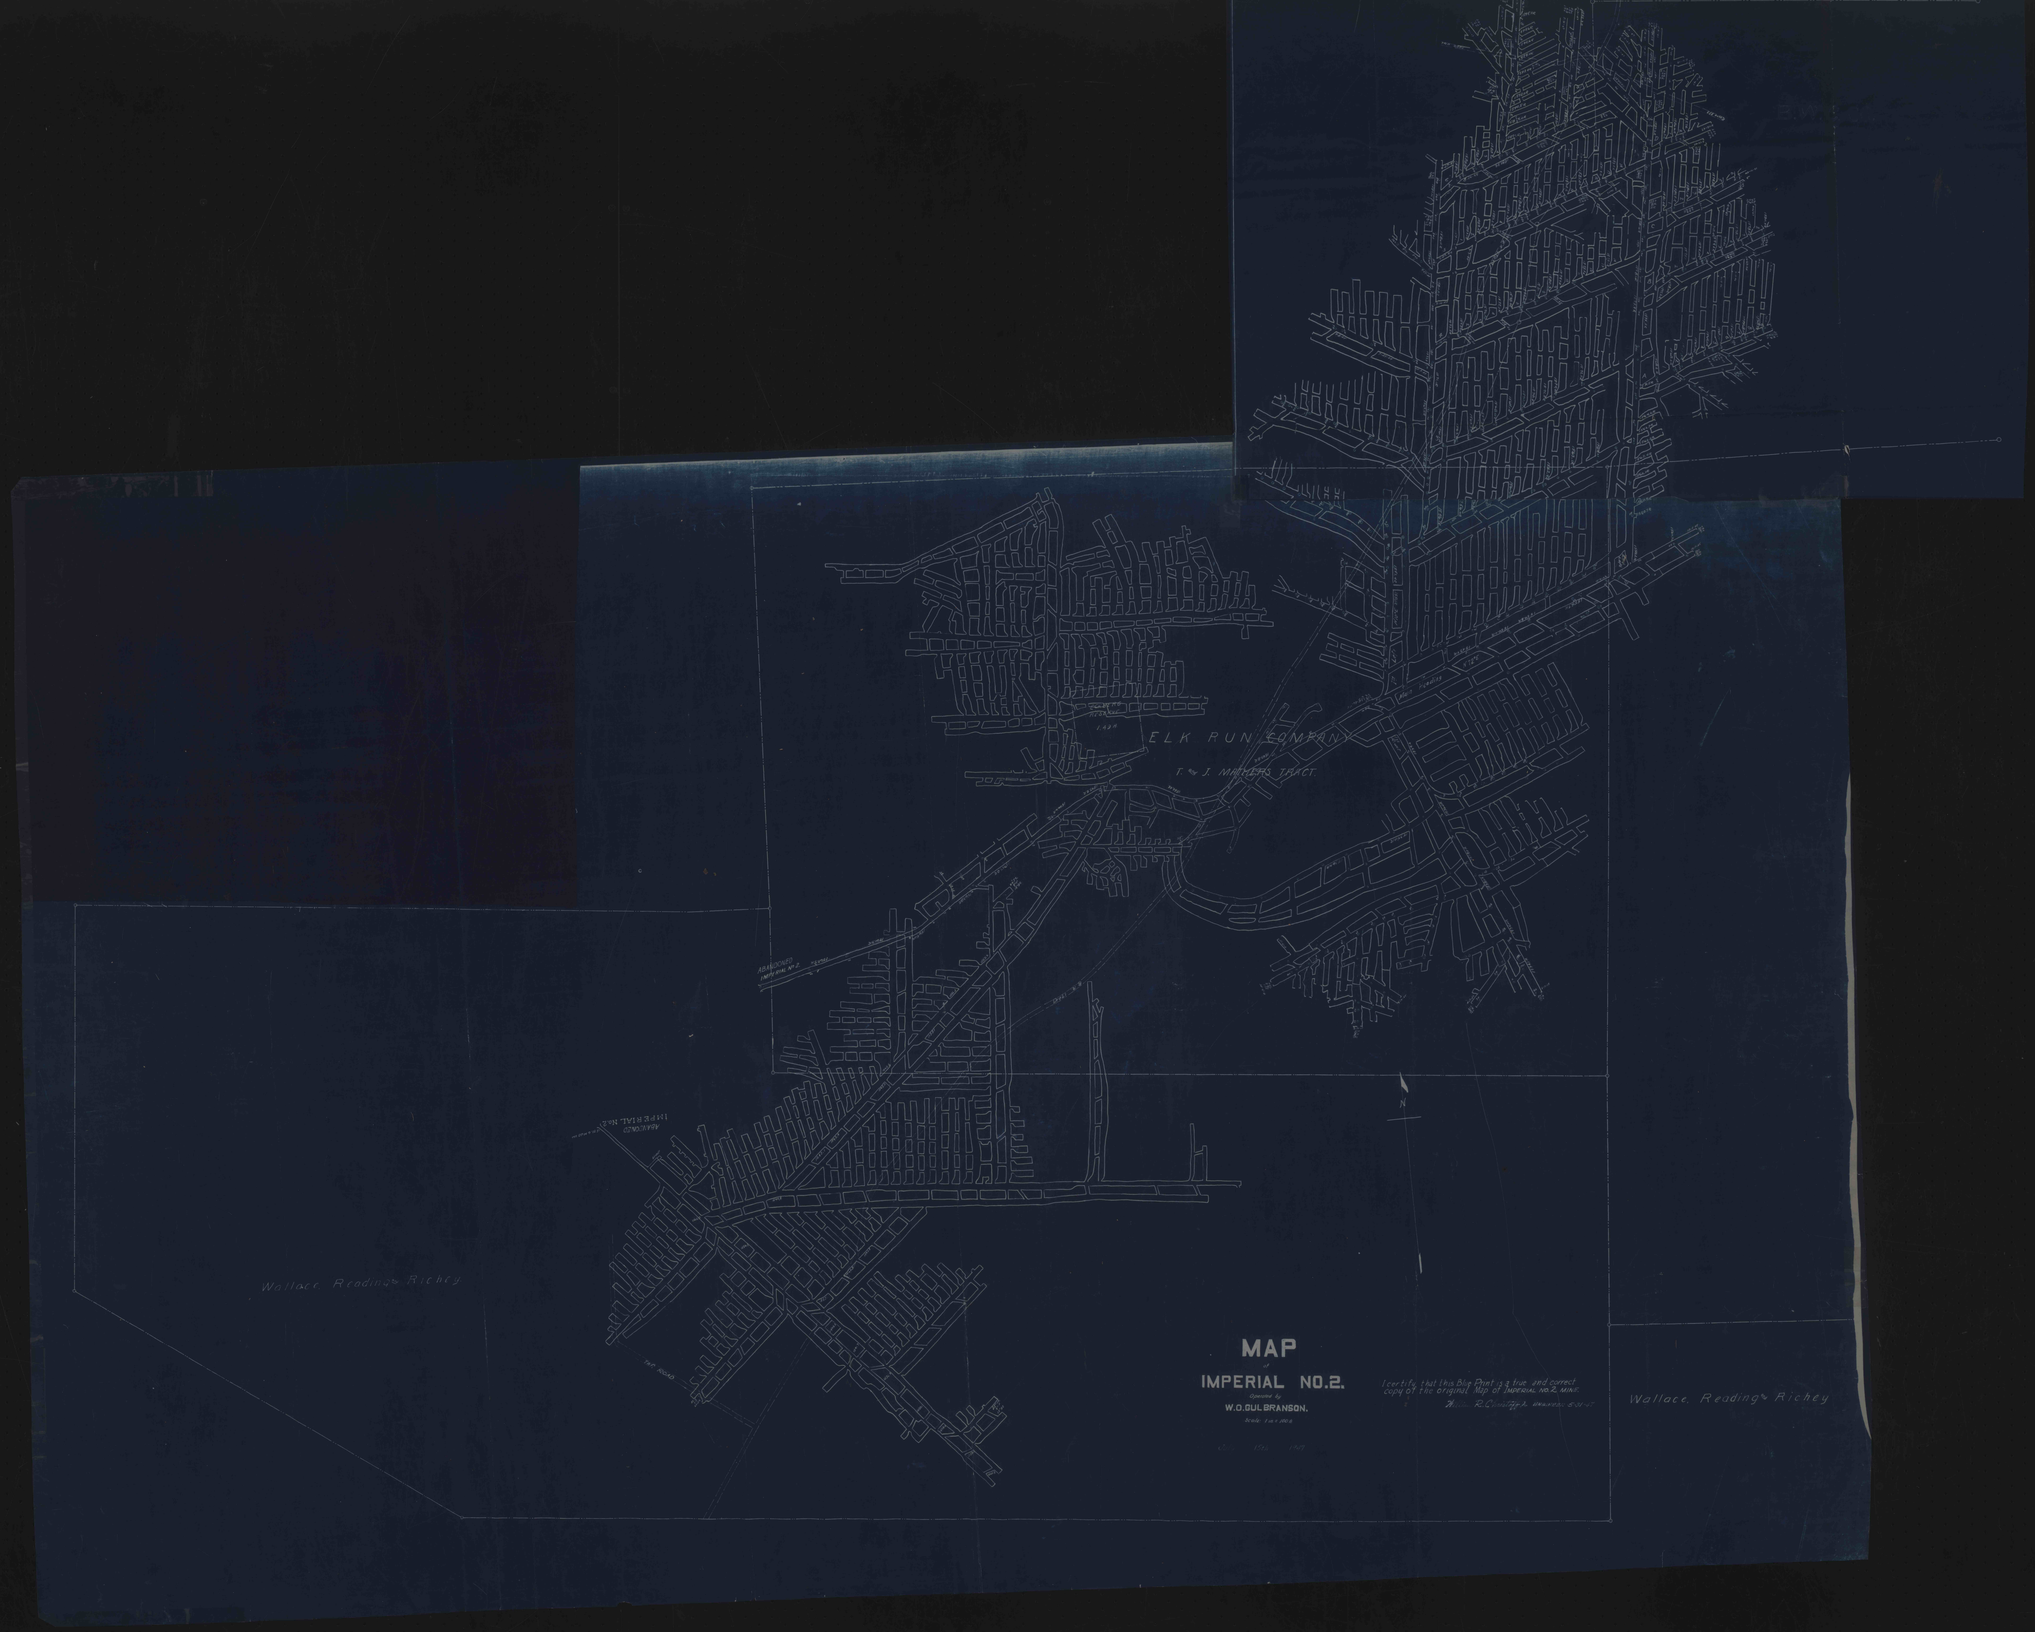
ELK RUN COMPANY
T. & J. MATHERS TRACT
Wallace Reading & Richey
Wallace Reading & Richey
MAP
IMPERIAL NO.2.
Operated by
W.O.GUL BRANSON.
Scale 1 in = 100 ft
Certify that this Blue Print is a true and correct copy of the original Map of IMPERIAL NO.2, MINE.
William R. Quinlan & Brandon, Sc. Ltd.