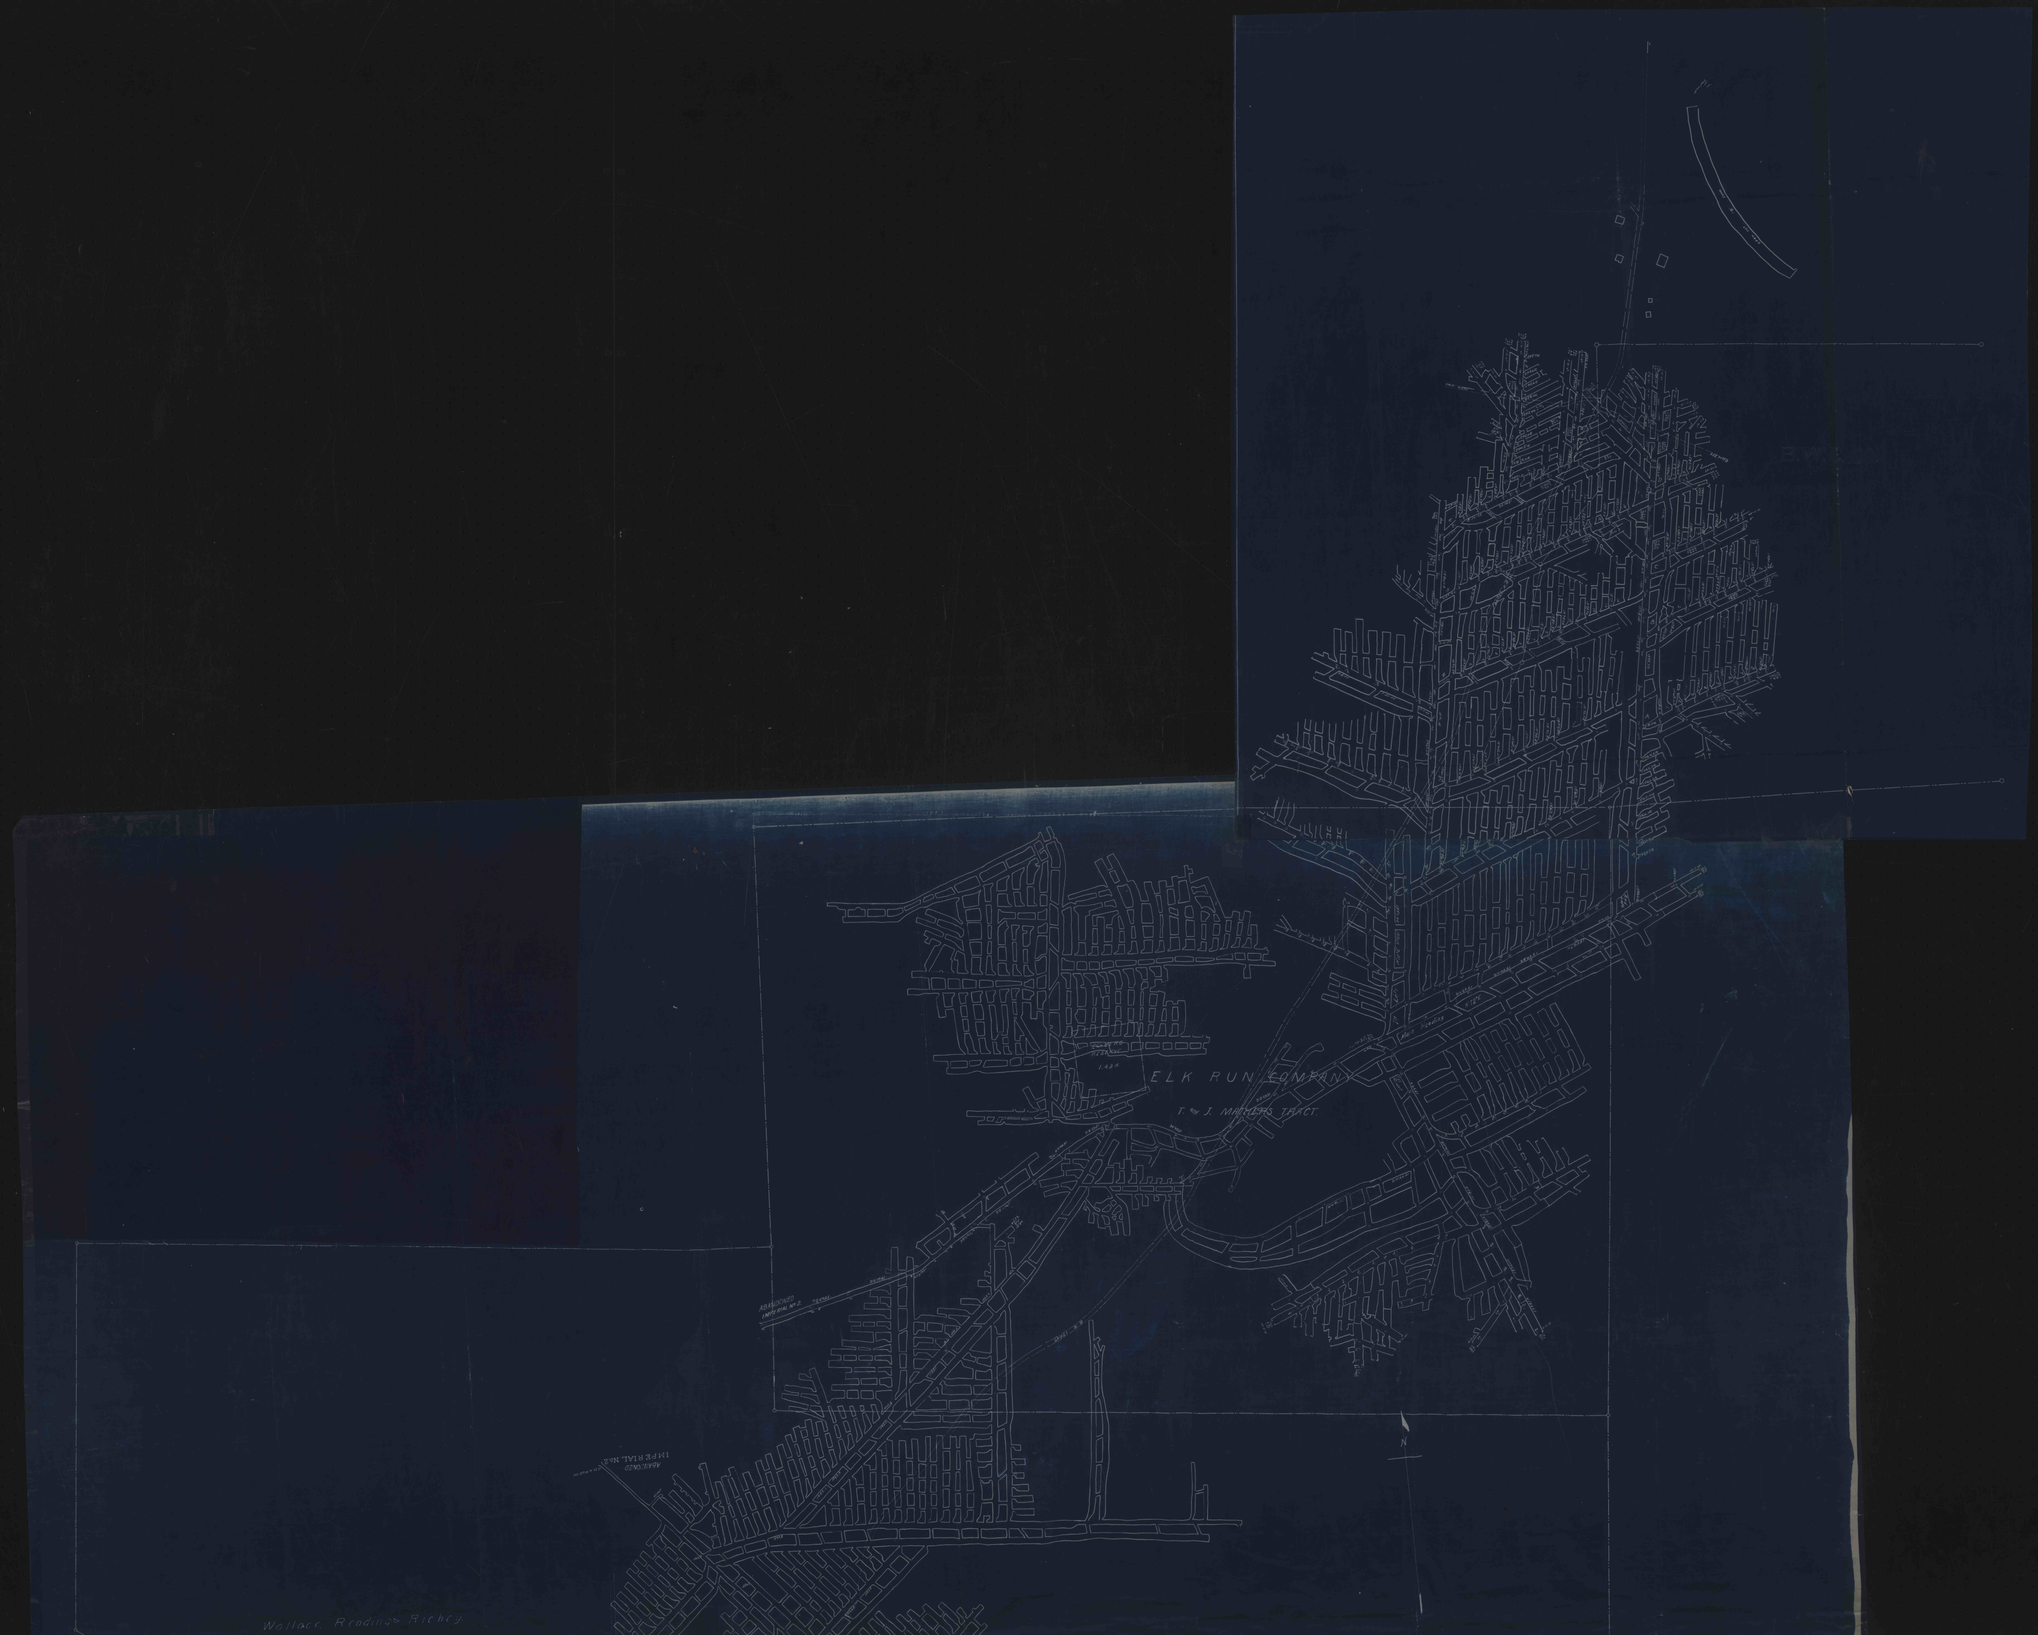
ELK RUN COMPANY
T. & J. MASTERS TRACT
Wallace Readings Richey