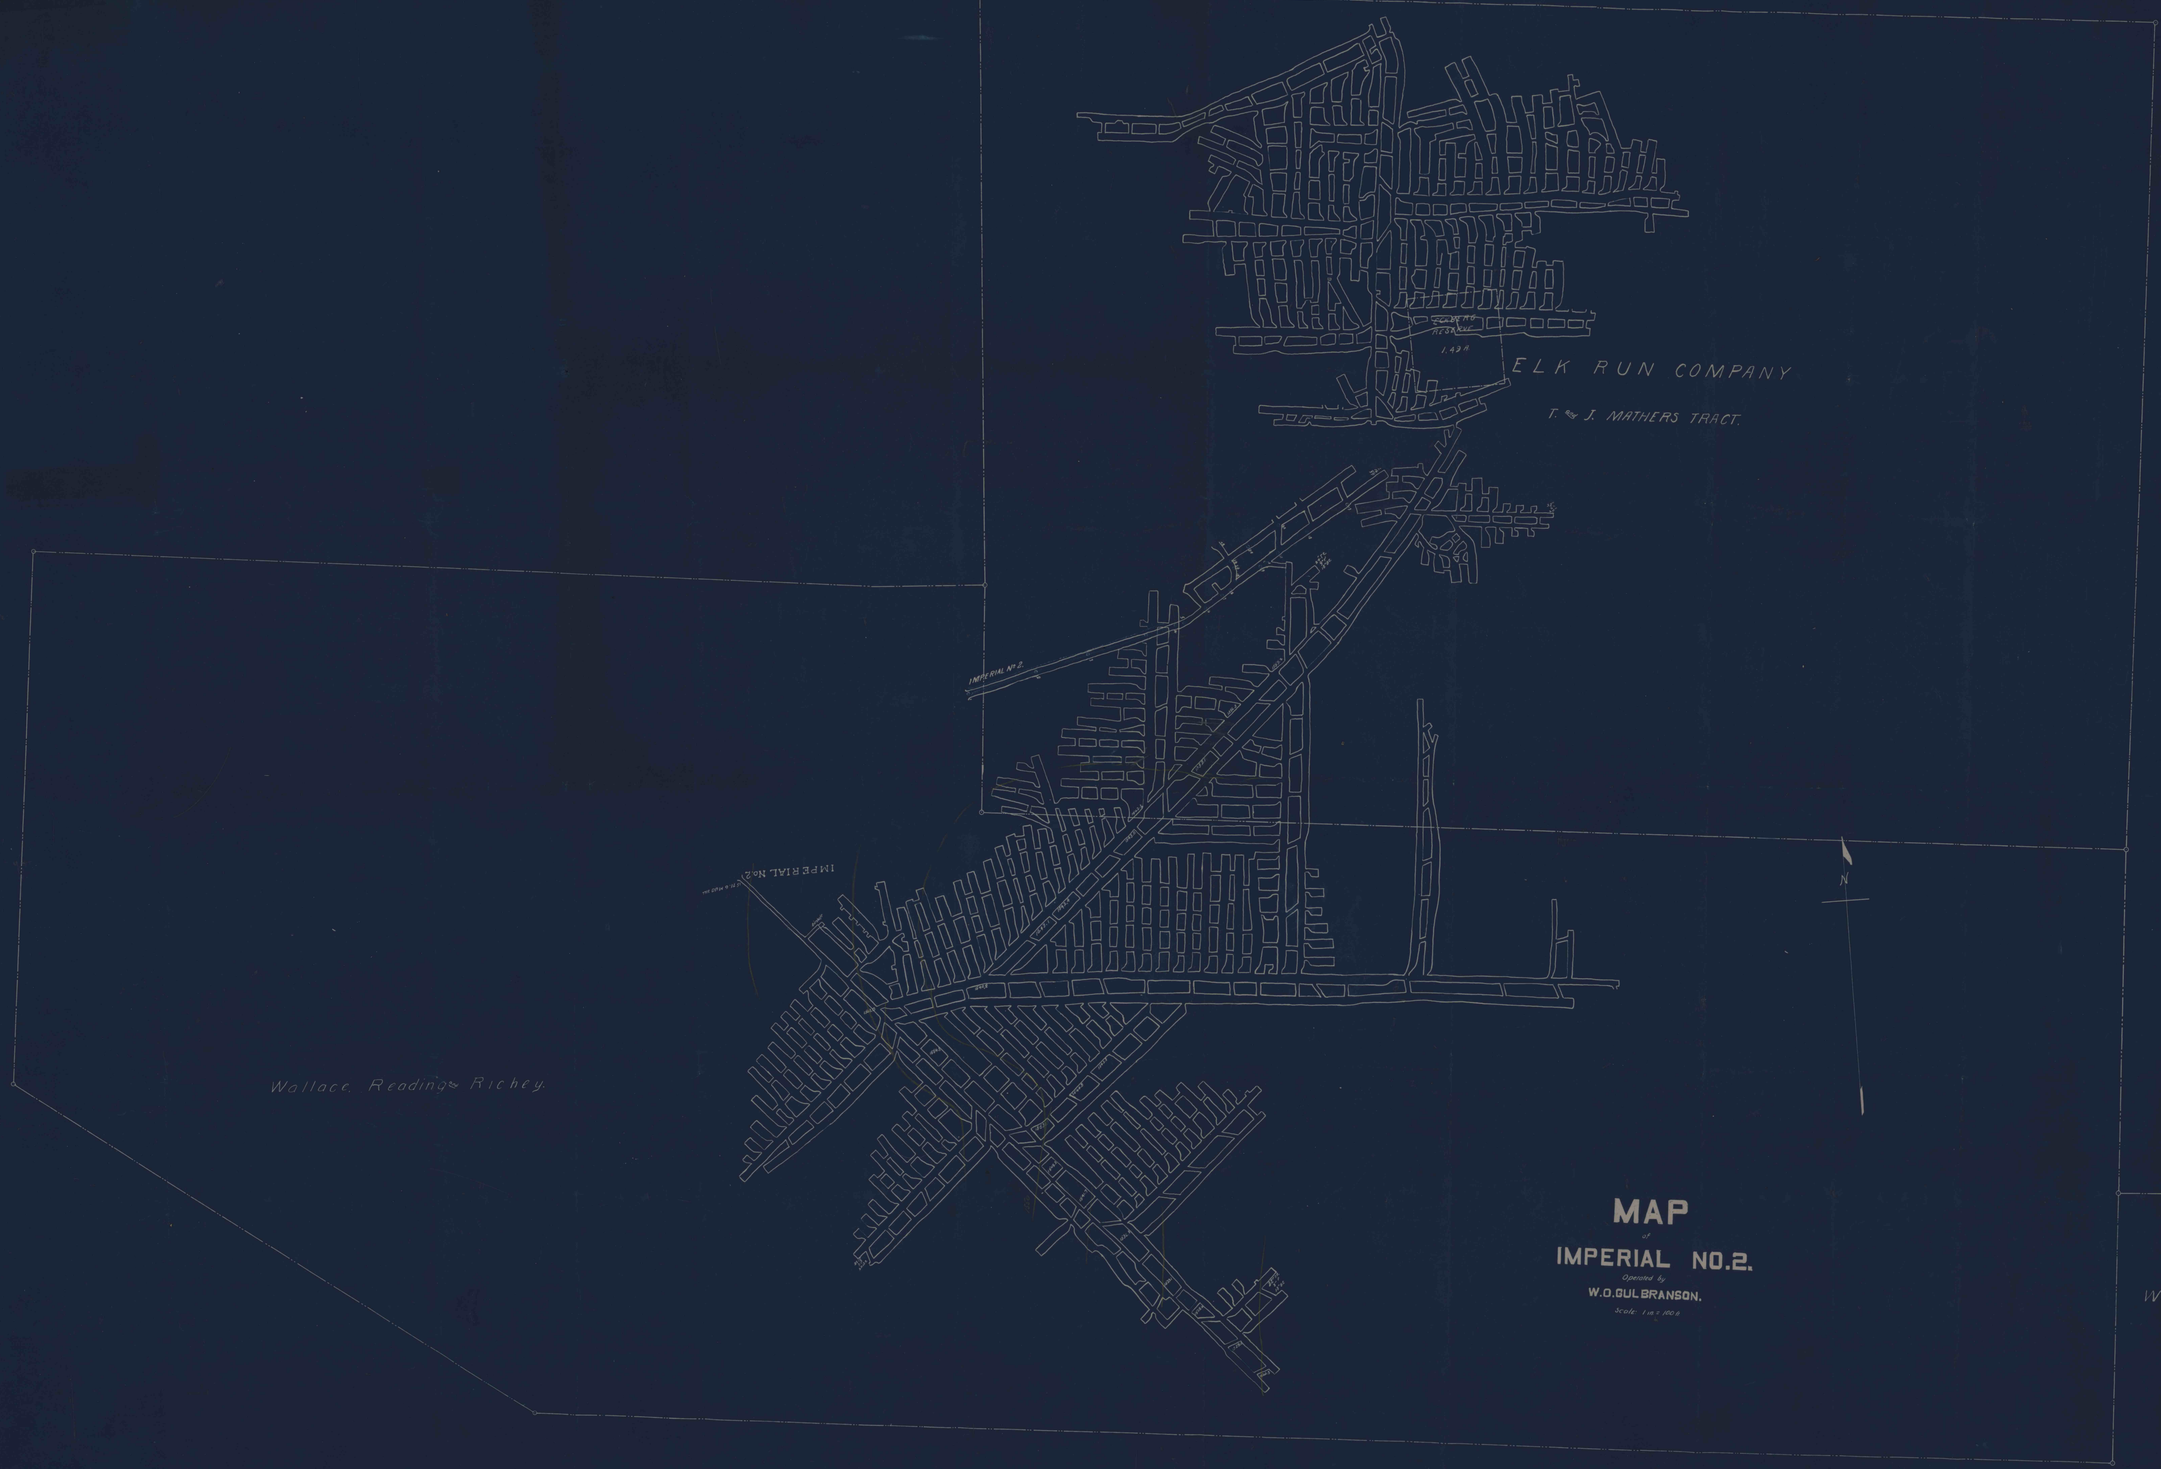
ELK RUN COMPANY
T. & J. MATHERS TRACT.
IMPERIAL No. 2.
IMPERIAL No. 2.
Wallace, Reading & Richey
Wallace, Reading & Richey
N
MAP
of
IMPERIAL NO. 2.
Operated by
W. O. GULBRANSON.
Scale: 1 in = 100 ft