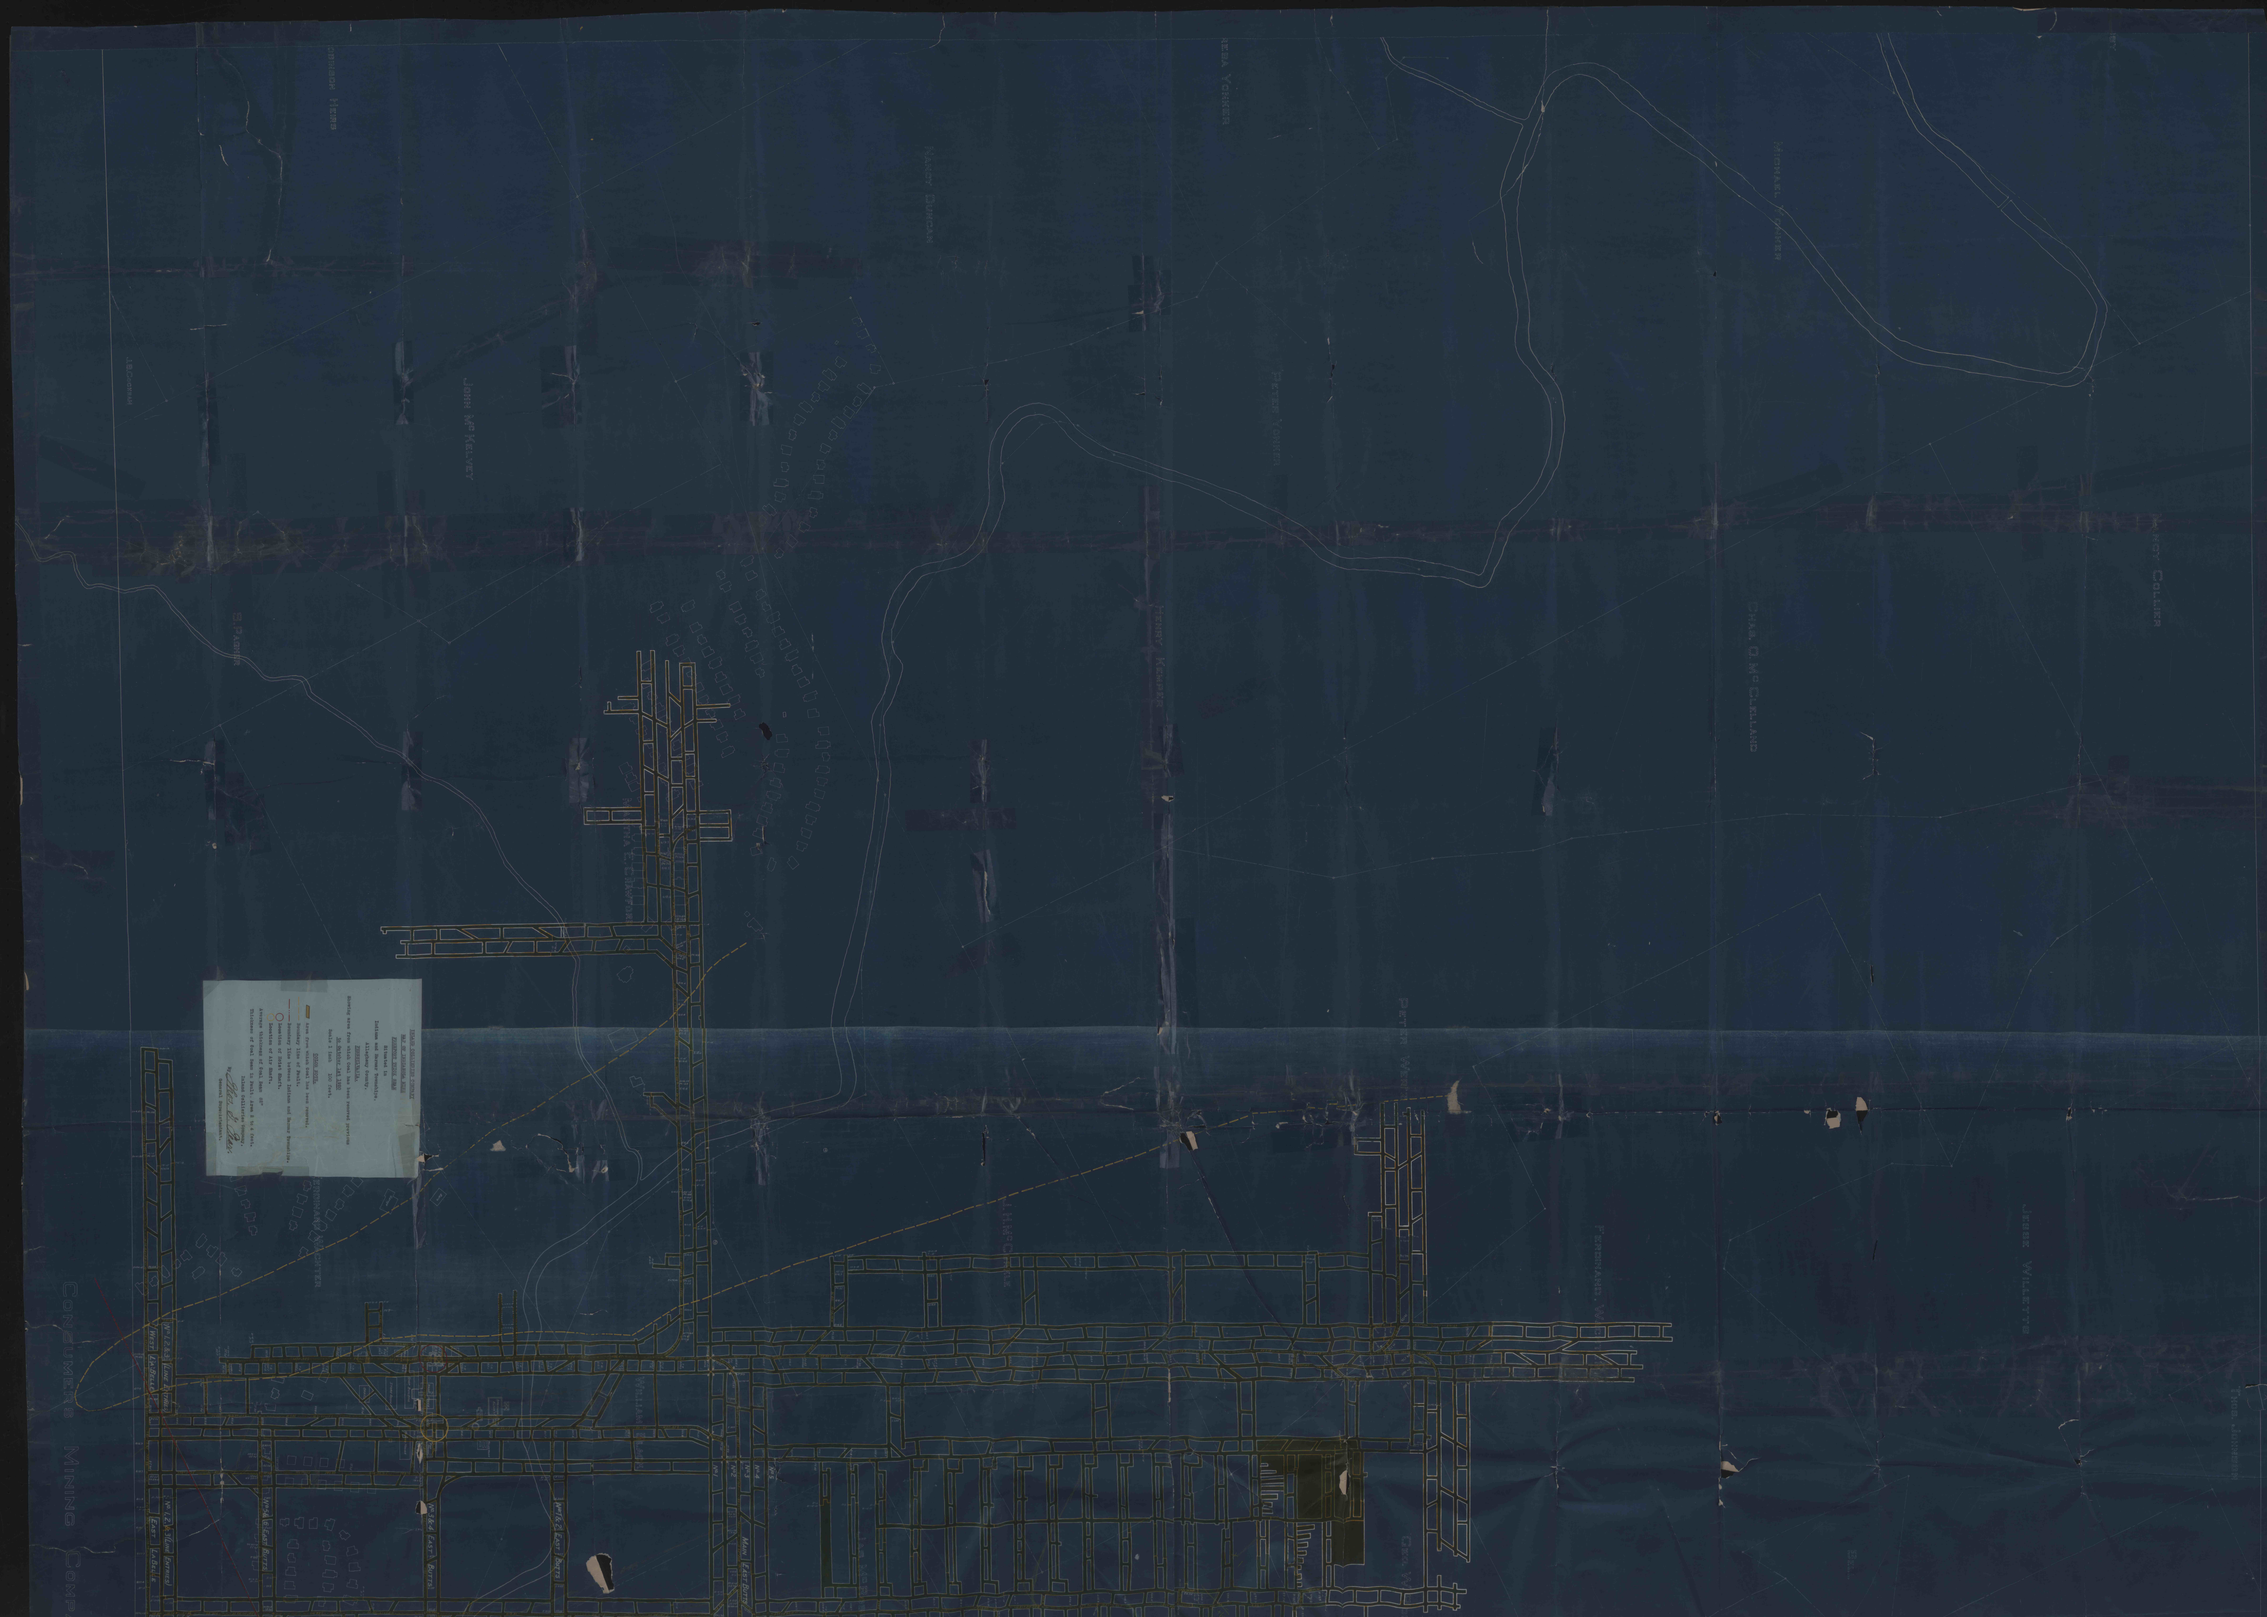

Michael Yonker
Peter Yonker
Henry Kelper
Chas. O. McClelland
Nancy Collier
Jesse Willette
Peter Wright
Consumers Mining Comp