

OLLIER

PETER QUINTE

JESSE WILLETTE

BELL

FRANK AND THOMAS

W. H. C. CLELLAND

MARGARET QUINTE

FERNAND W.


PETER WENT

Geo. W.

JAC. H.

HENRY KEMPER

J. H. P. S.

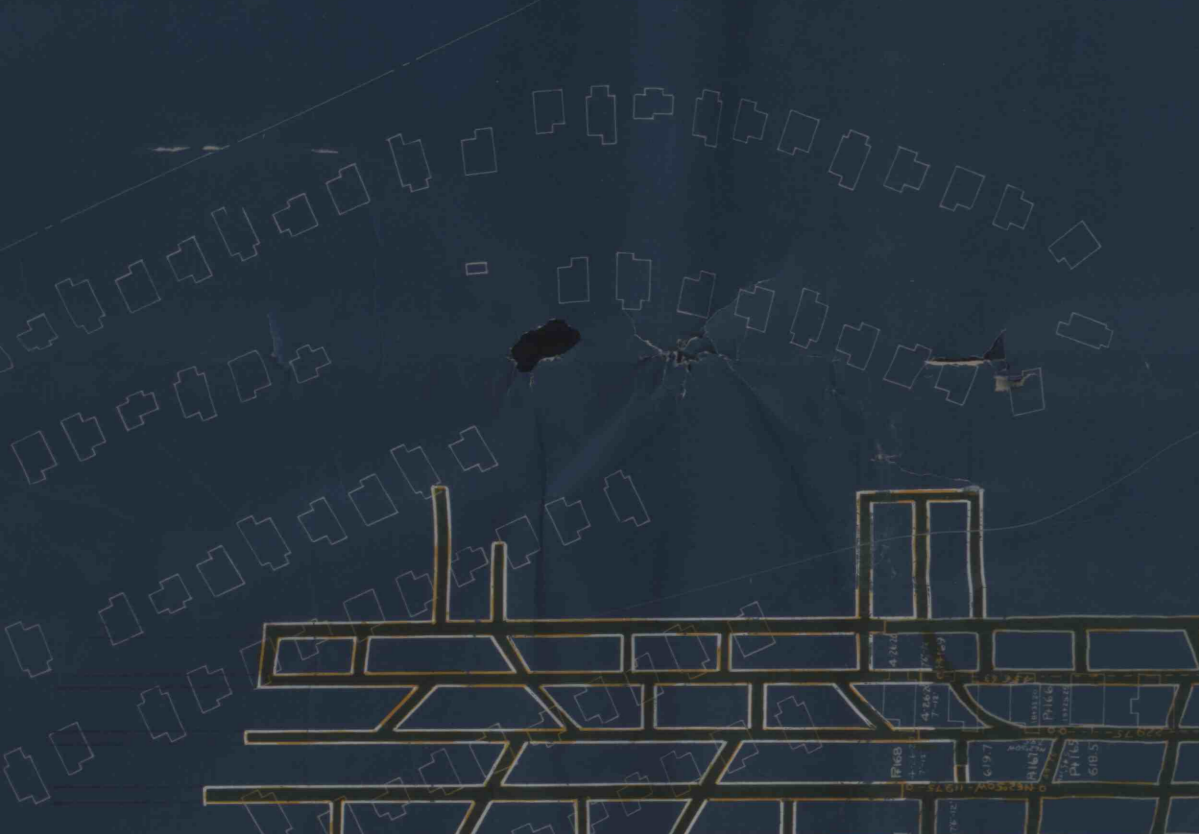

 J. H. P. S.