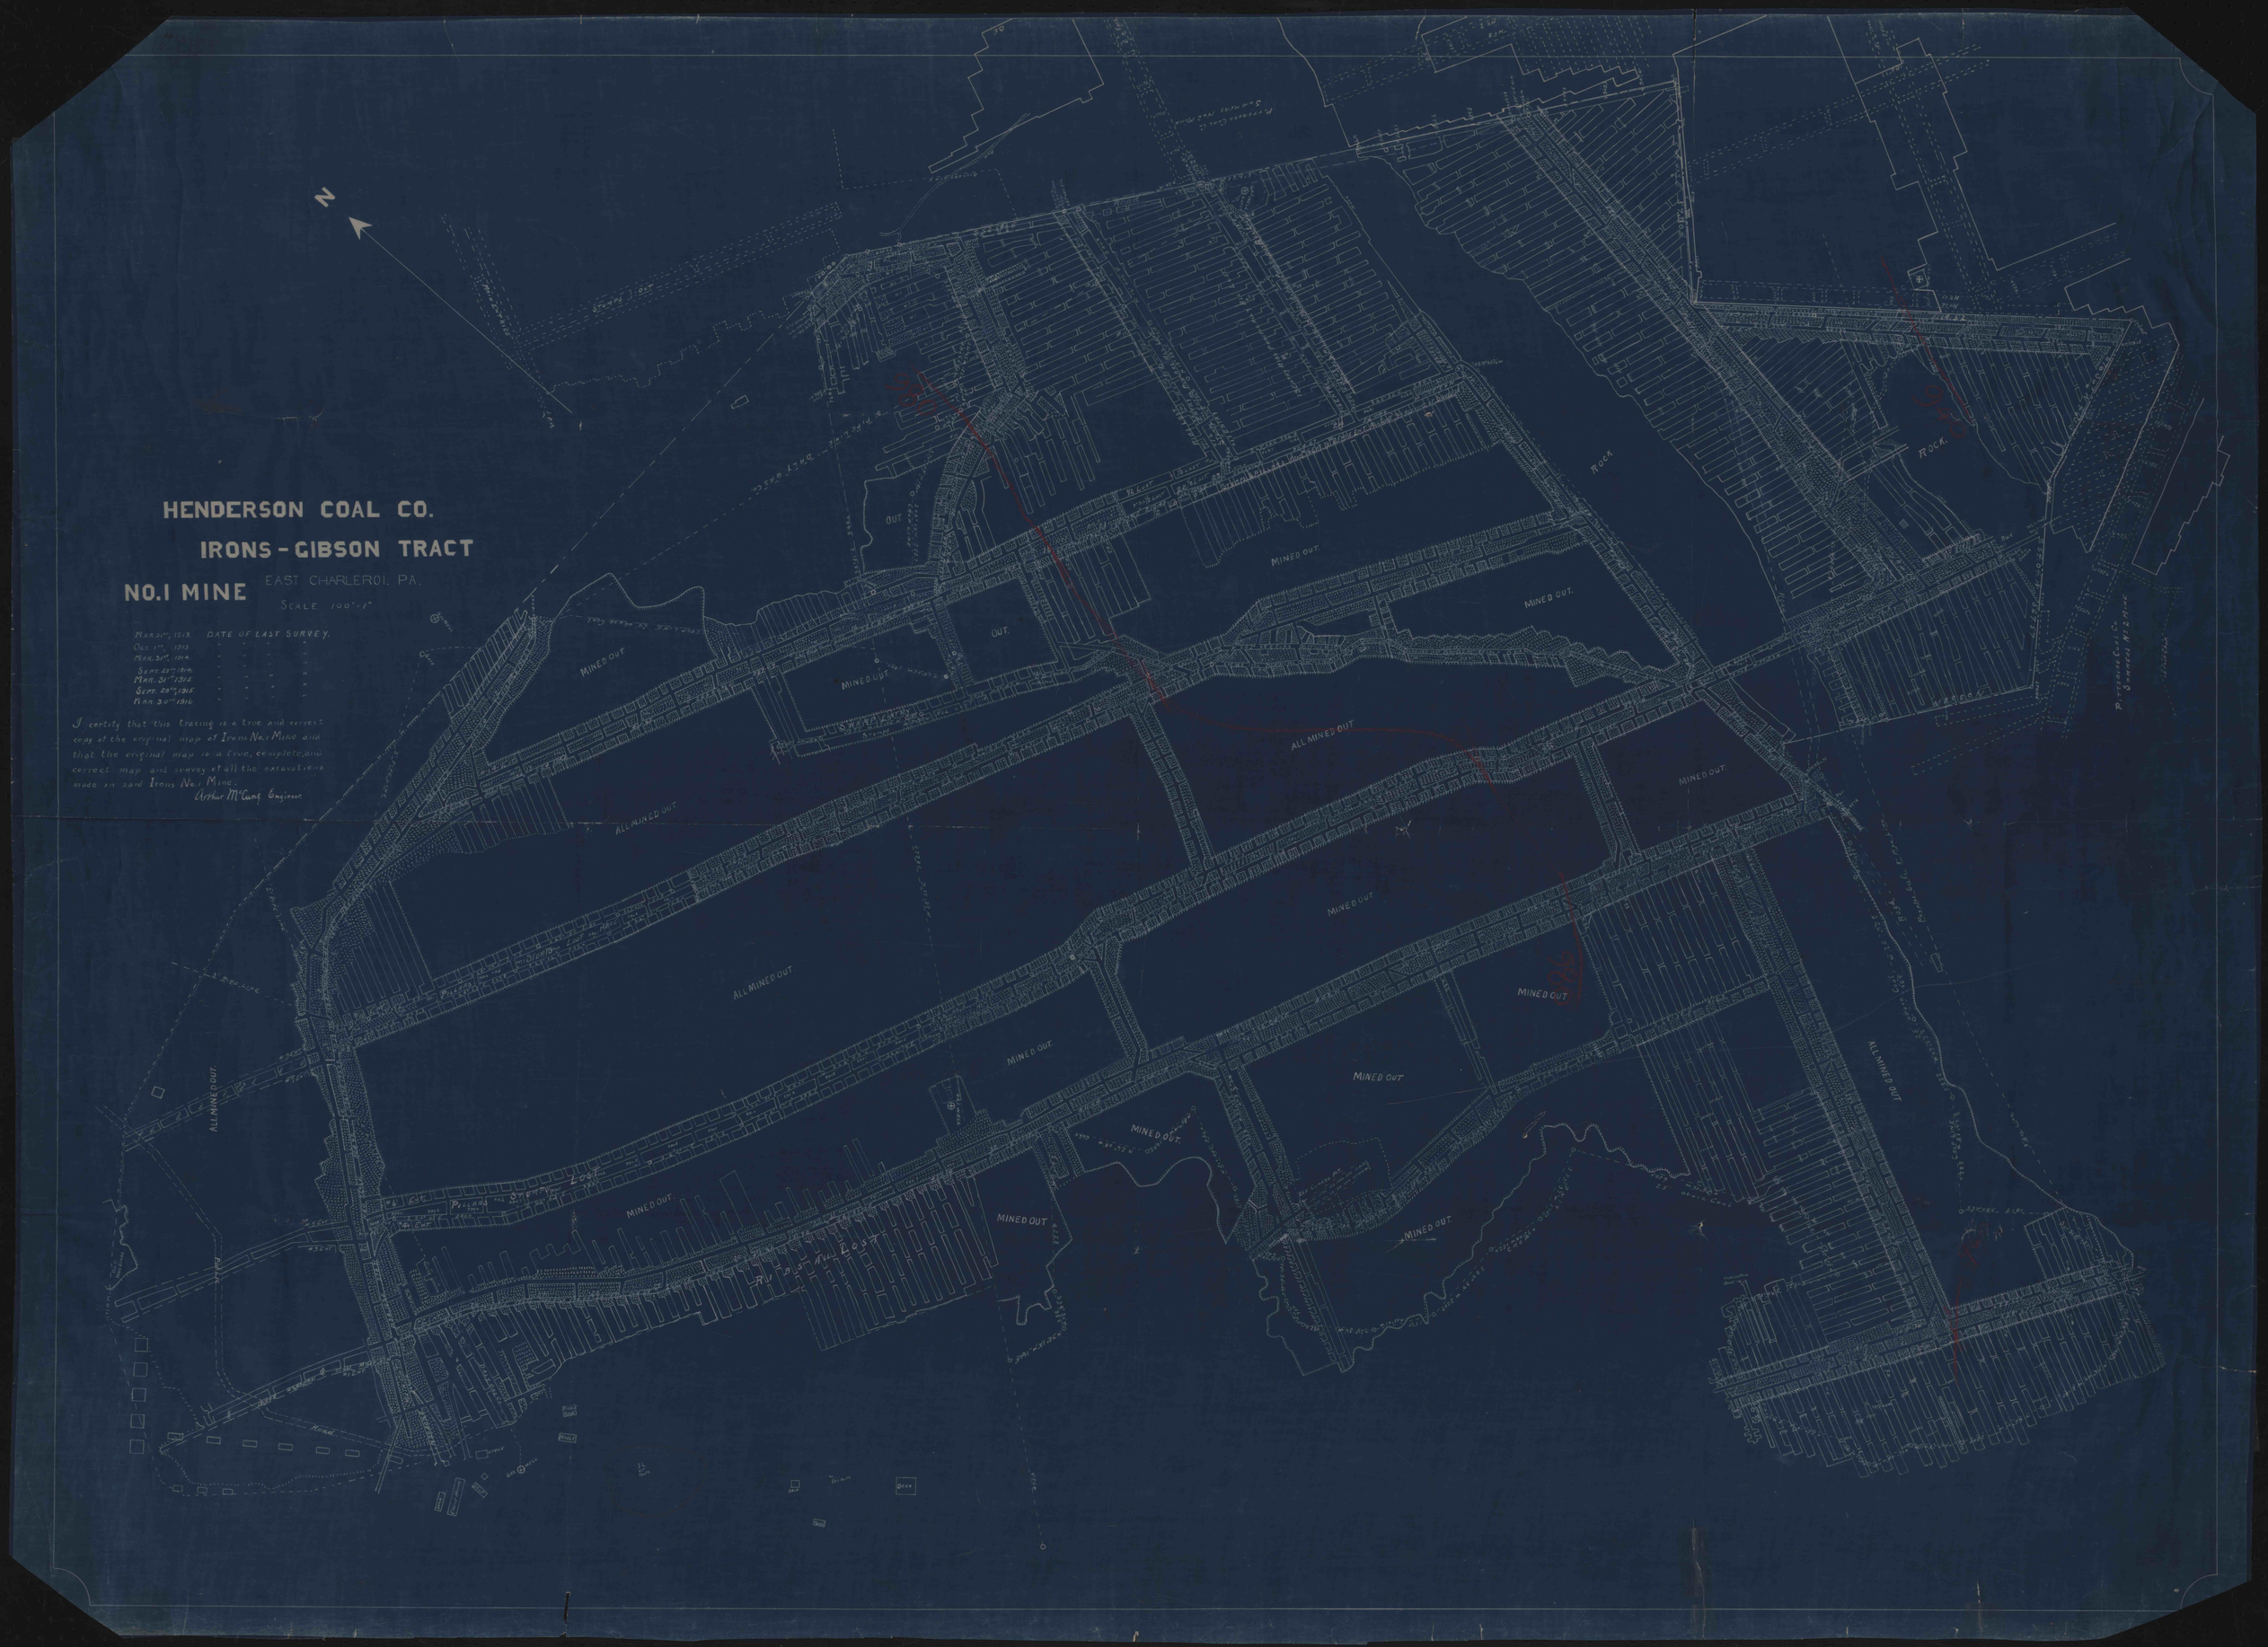
HENDERSON COAL CO.
IRONS - GIBSON TRACT
NO.1 MINE
EAST CHARLEROI, PA.
SCALE 100'=1"
DATE OF LAST SURVEY.
MAR. 31st, 1913.
OCT. 1st, 1913
MAR. 31st, 1914
SEPT. 29th, 1914
MAR. 31st, 1915
SEPT. 29th, 1915
MAR. 30th, 1916
I certify that this tracing is a true and correct copy of the original map of Irons No.1 Mine and that the original map is a true, complete, and correct map and survey of all the excavations made in said Irons No.1 Mine.
Arthur McCurg Engineer.
N
MINED OUT
ALL MINED OUT
ROCK
Pittsburgh Coal Co.
Scottdale No. 2 Mine