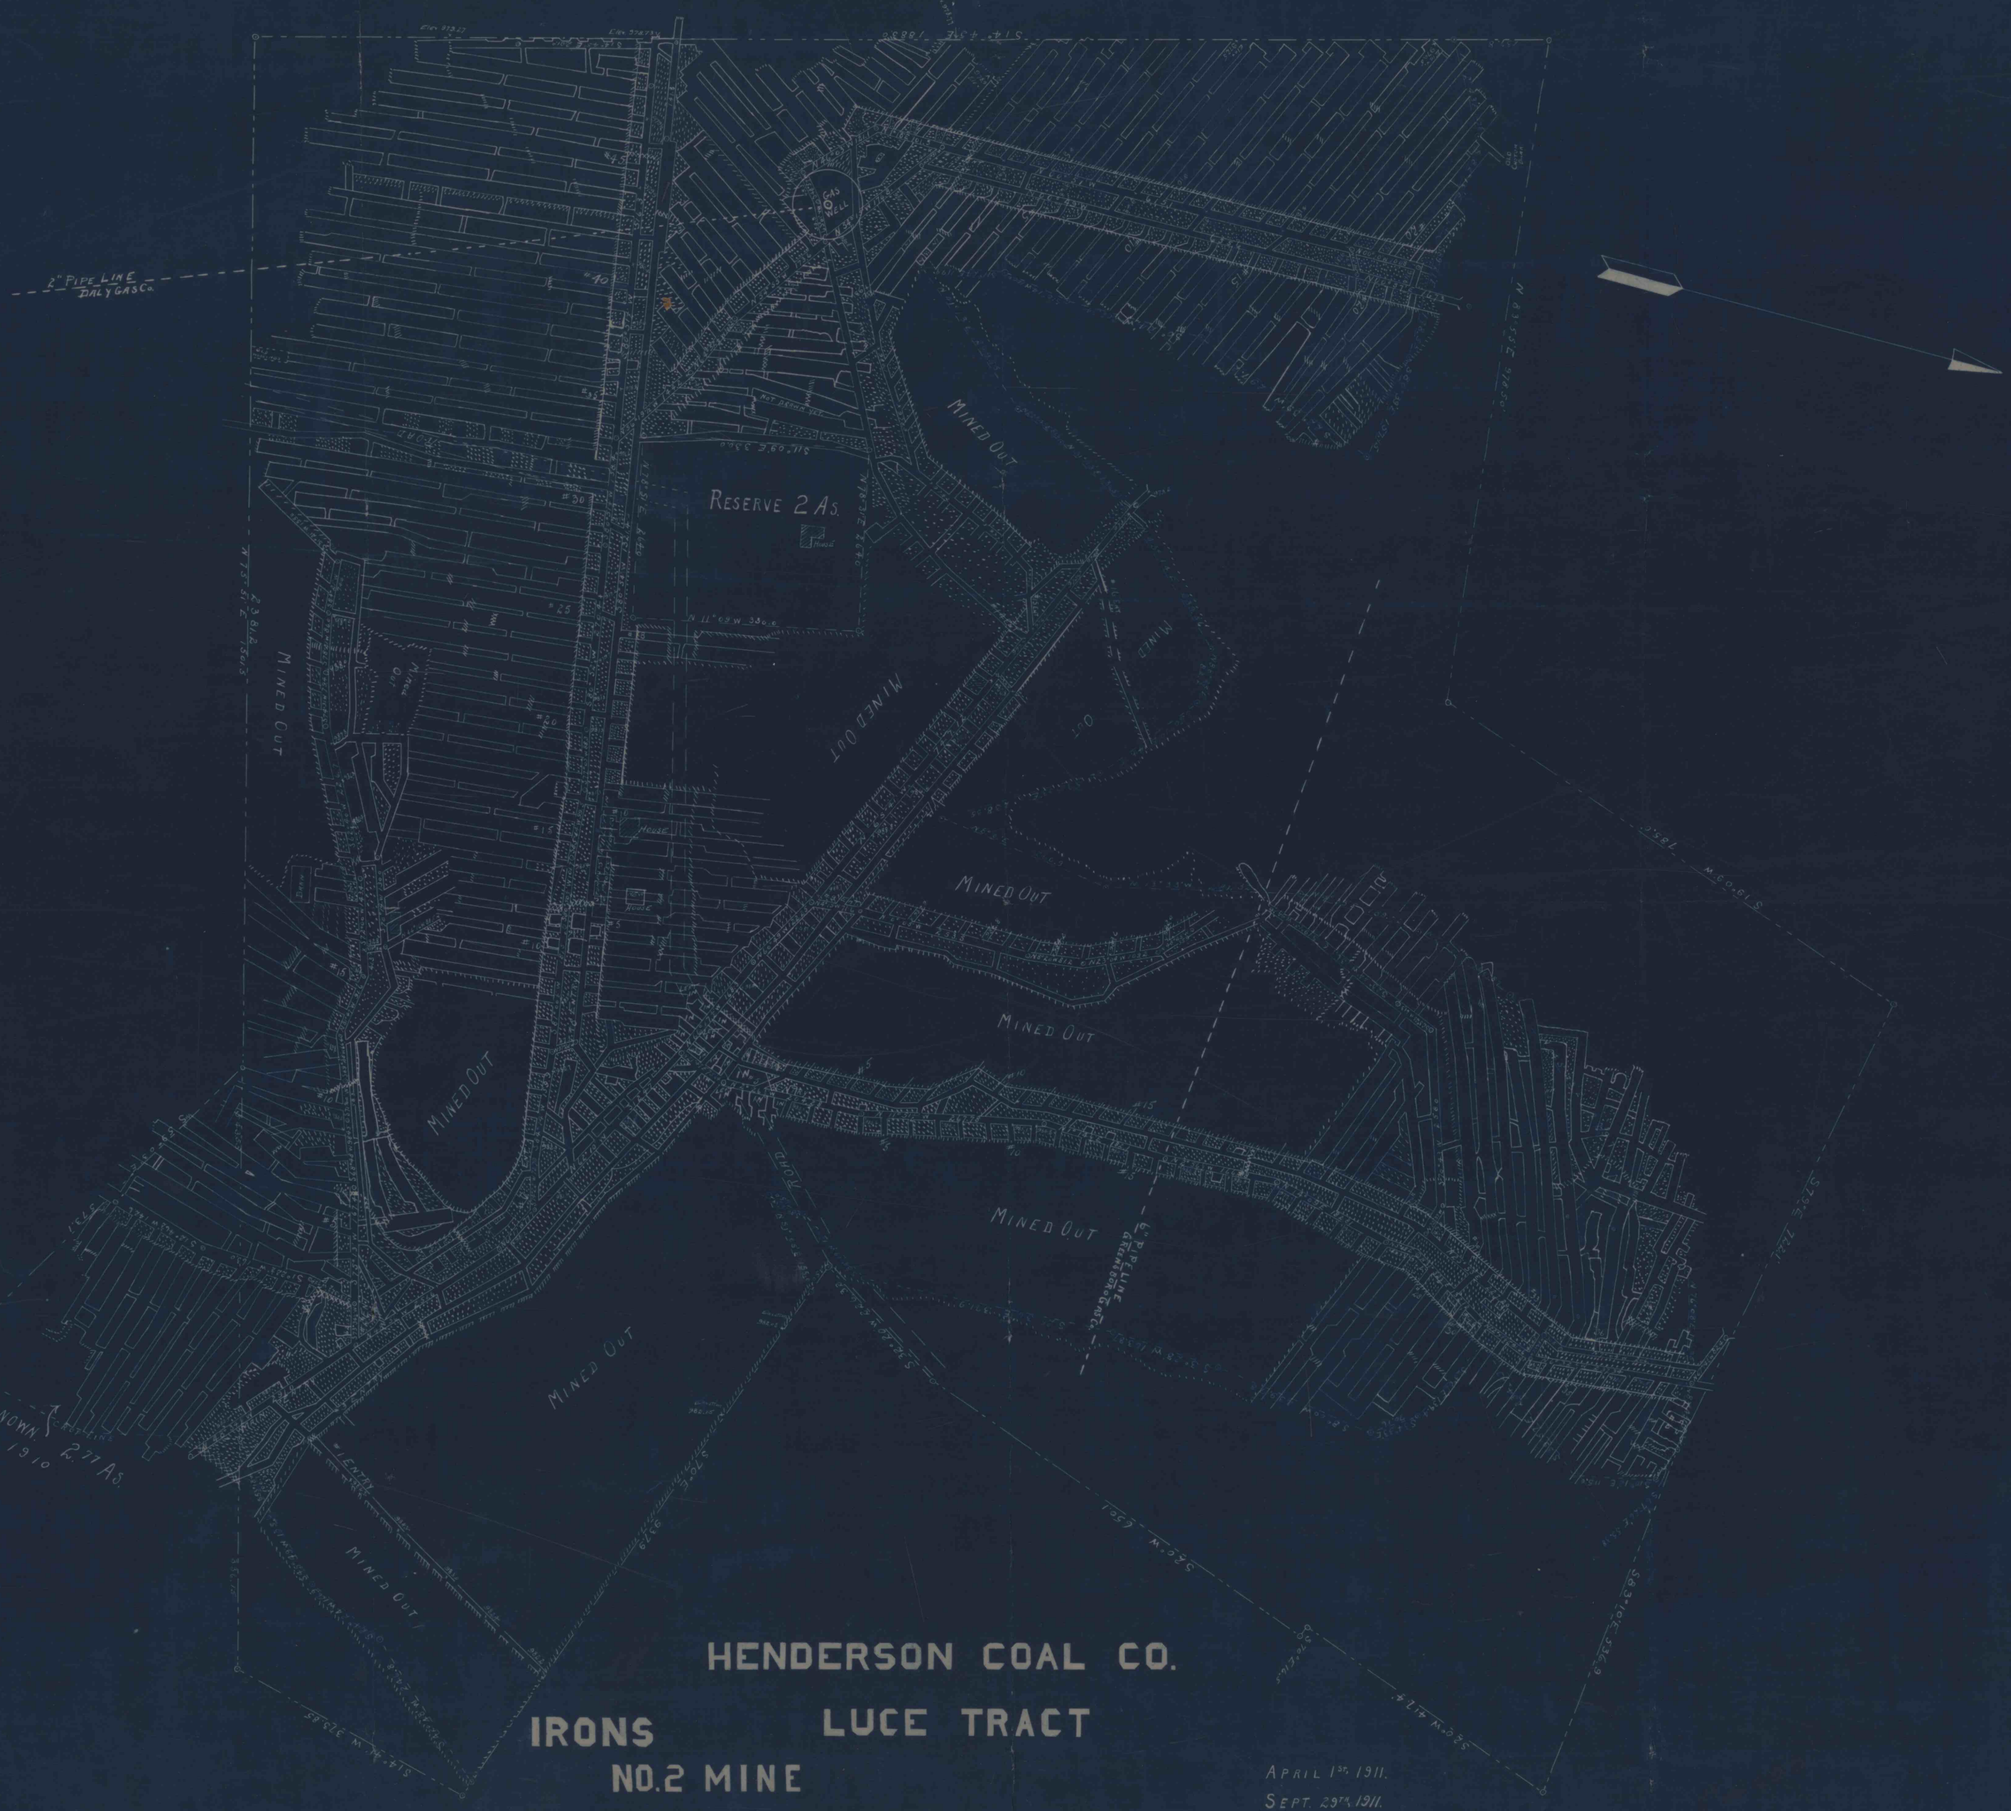
2" PIPE LINE
BALY GAS Co.
RESERVE 2 As.
MINED OUT
MINED OUT
MINED OUT