


*2. Identification of Buttes*  

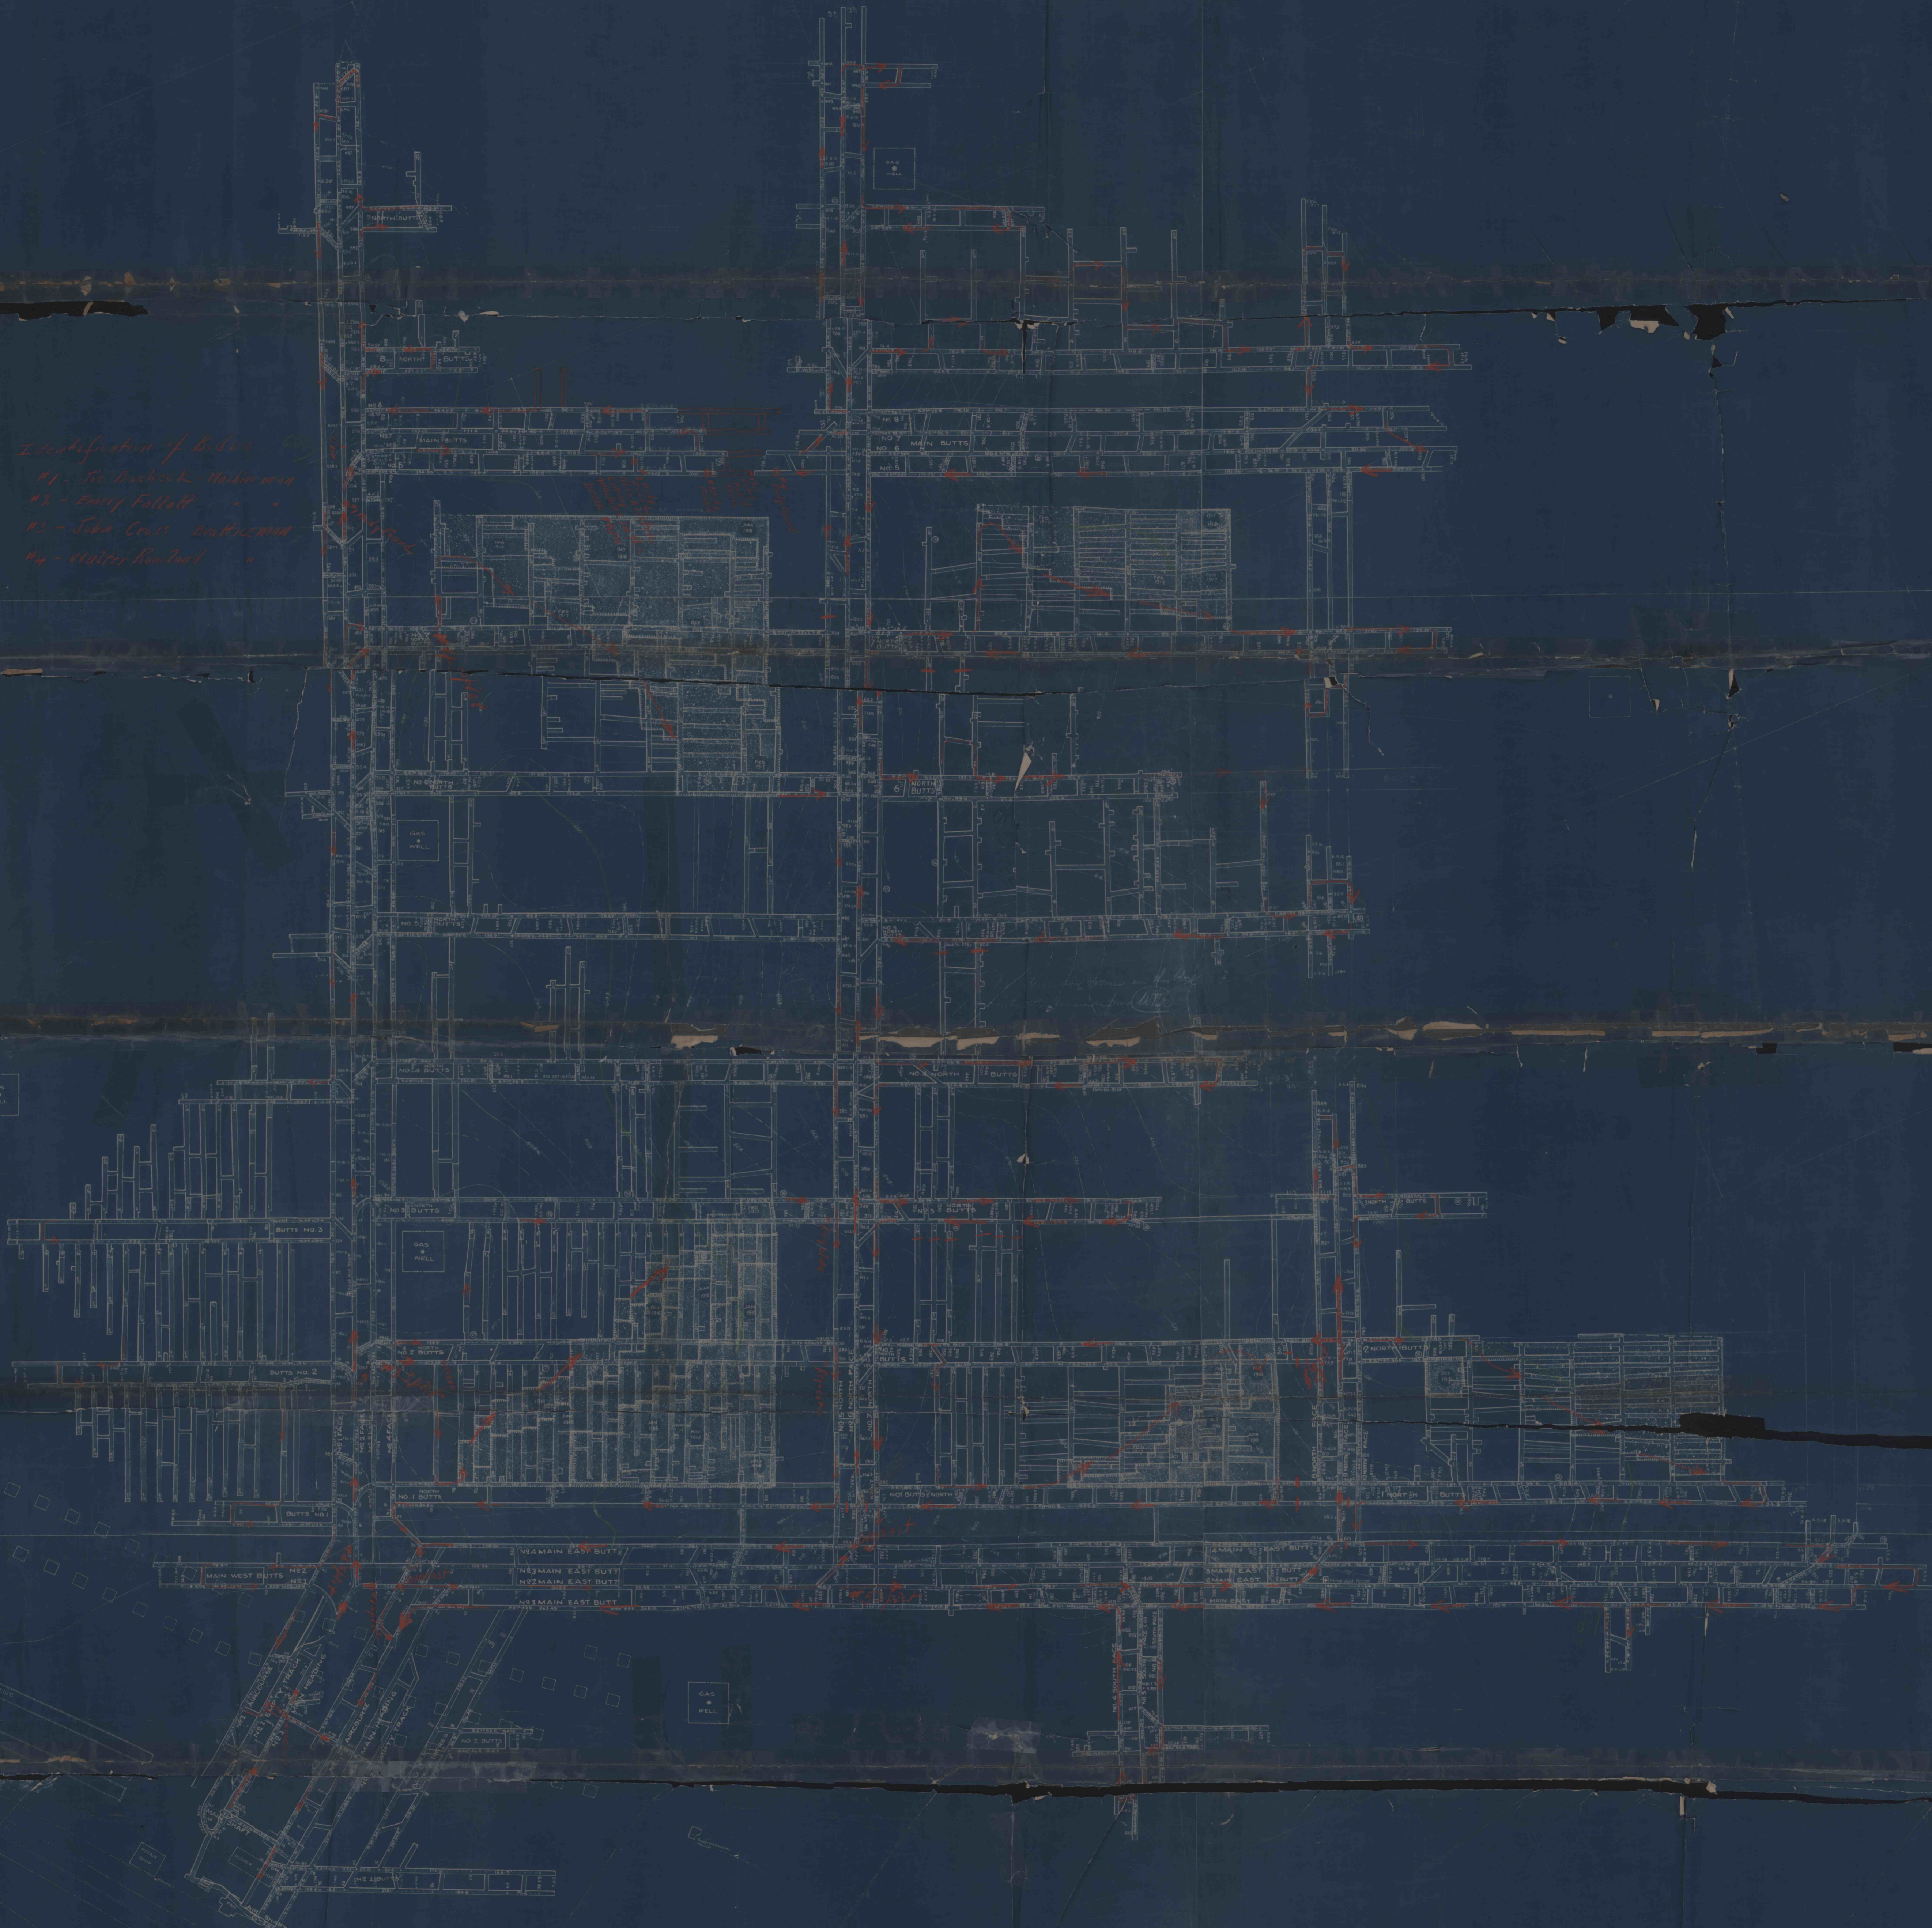



