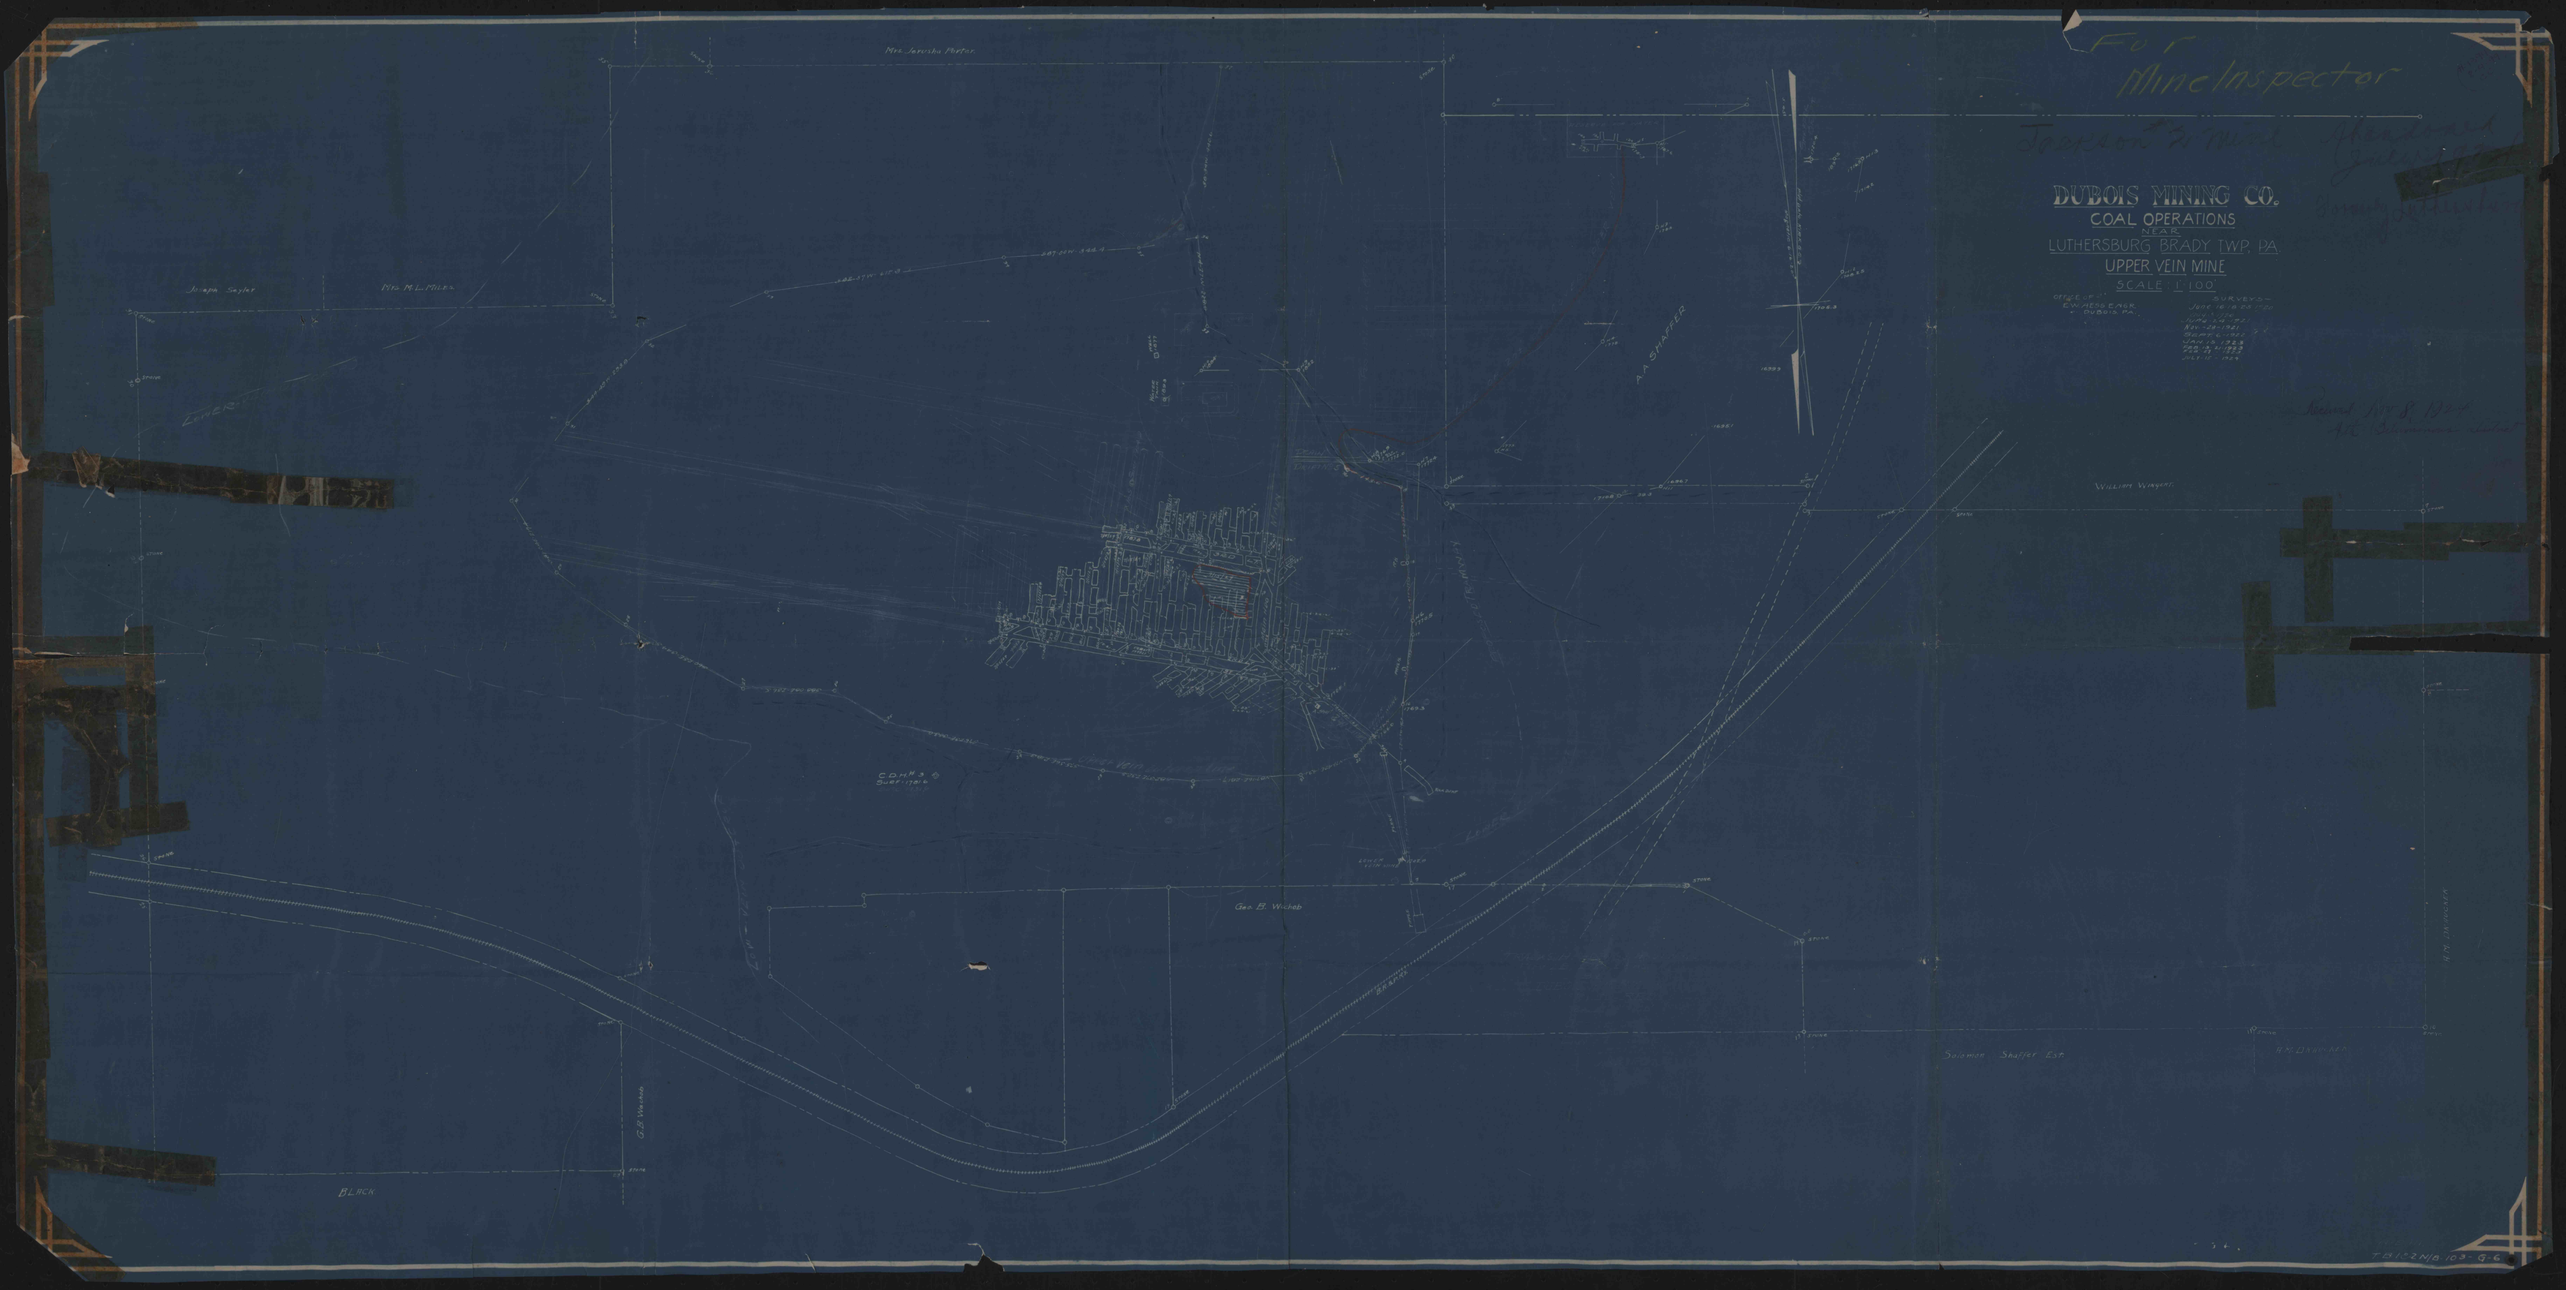
For
Mine Inspector
Jackson & Mine
Abandoned
July 1924
Formerly Luthersburg
DUBOIS MINING CO.
COAL OPERATIONS
NEAR
LUTHERSBURG BRADY TWP. PA.
UPPER VEIN MINE
SCALE: 1"=100'
OFFICE OF
E.W. MESS ENGR.
DUBOIS, PA.
SURVEYS—
June 16-18 & 25-1920
July 1-1920
June 20-1921
Nov. 20-1921
Sept. 6-1922
Jan. 13-1923
Feb. 13-1923
Feb. 21-1923
July 11-1924
Received Nov 8, 1924
Mrs. Jerusha Porter
Joseph Sayler
Mrs. M.L. Miles
A.A. Shaffer
William Wingert
Geo. B. Wichob
Salomon Shaffer Est.
G.B. Wichob
Black
T.B.102 N/B 103-G-6