



Imperial
Tracing Cloth

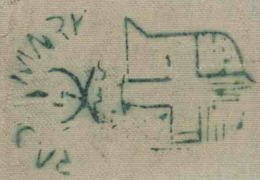

GREAT
BRITAIN

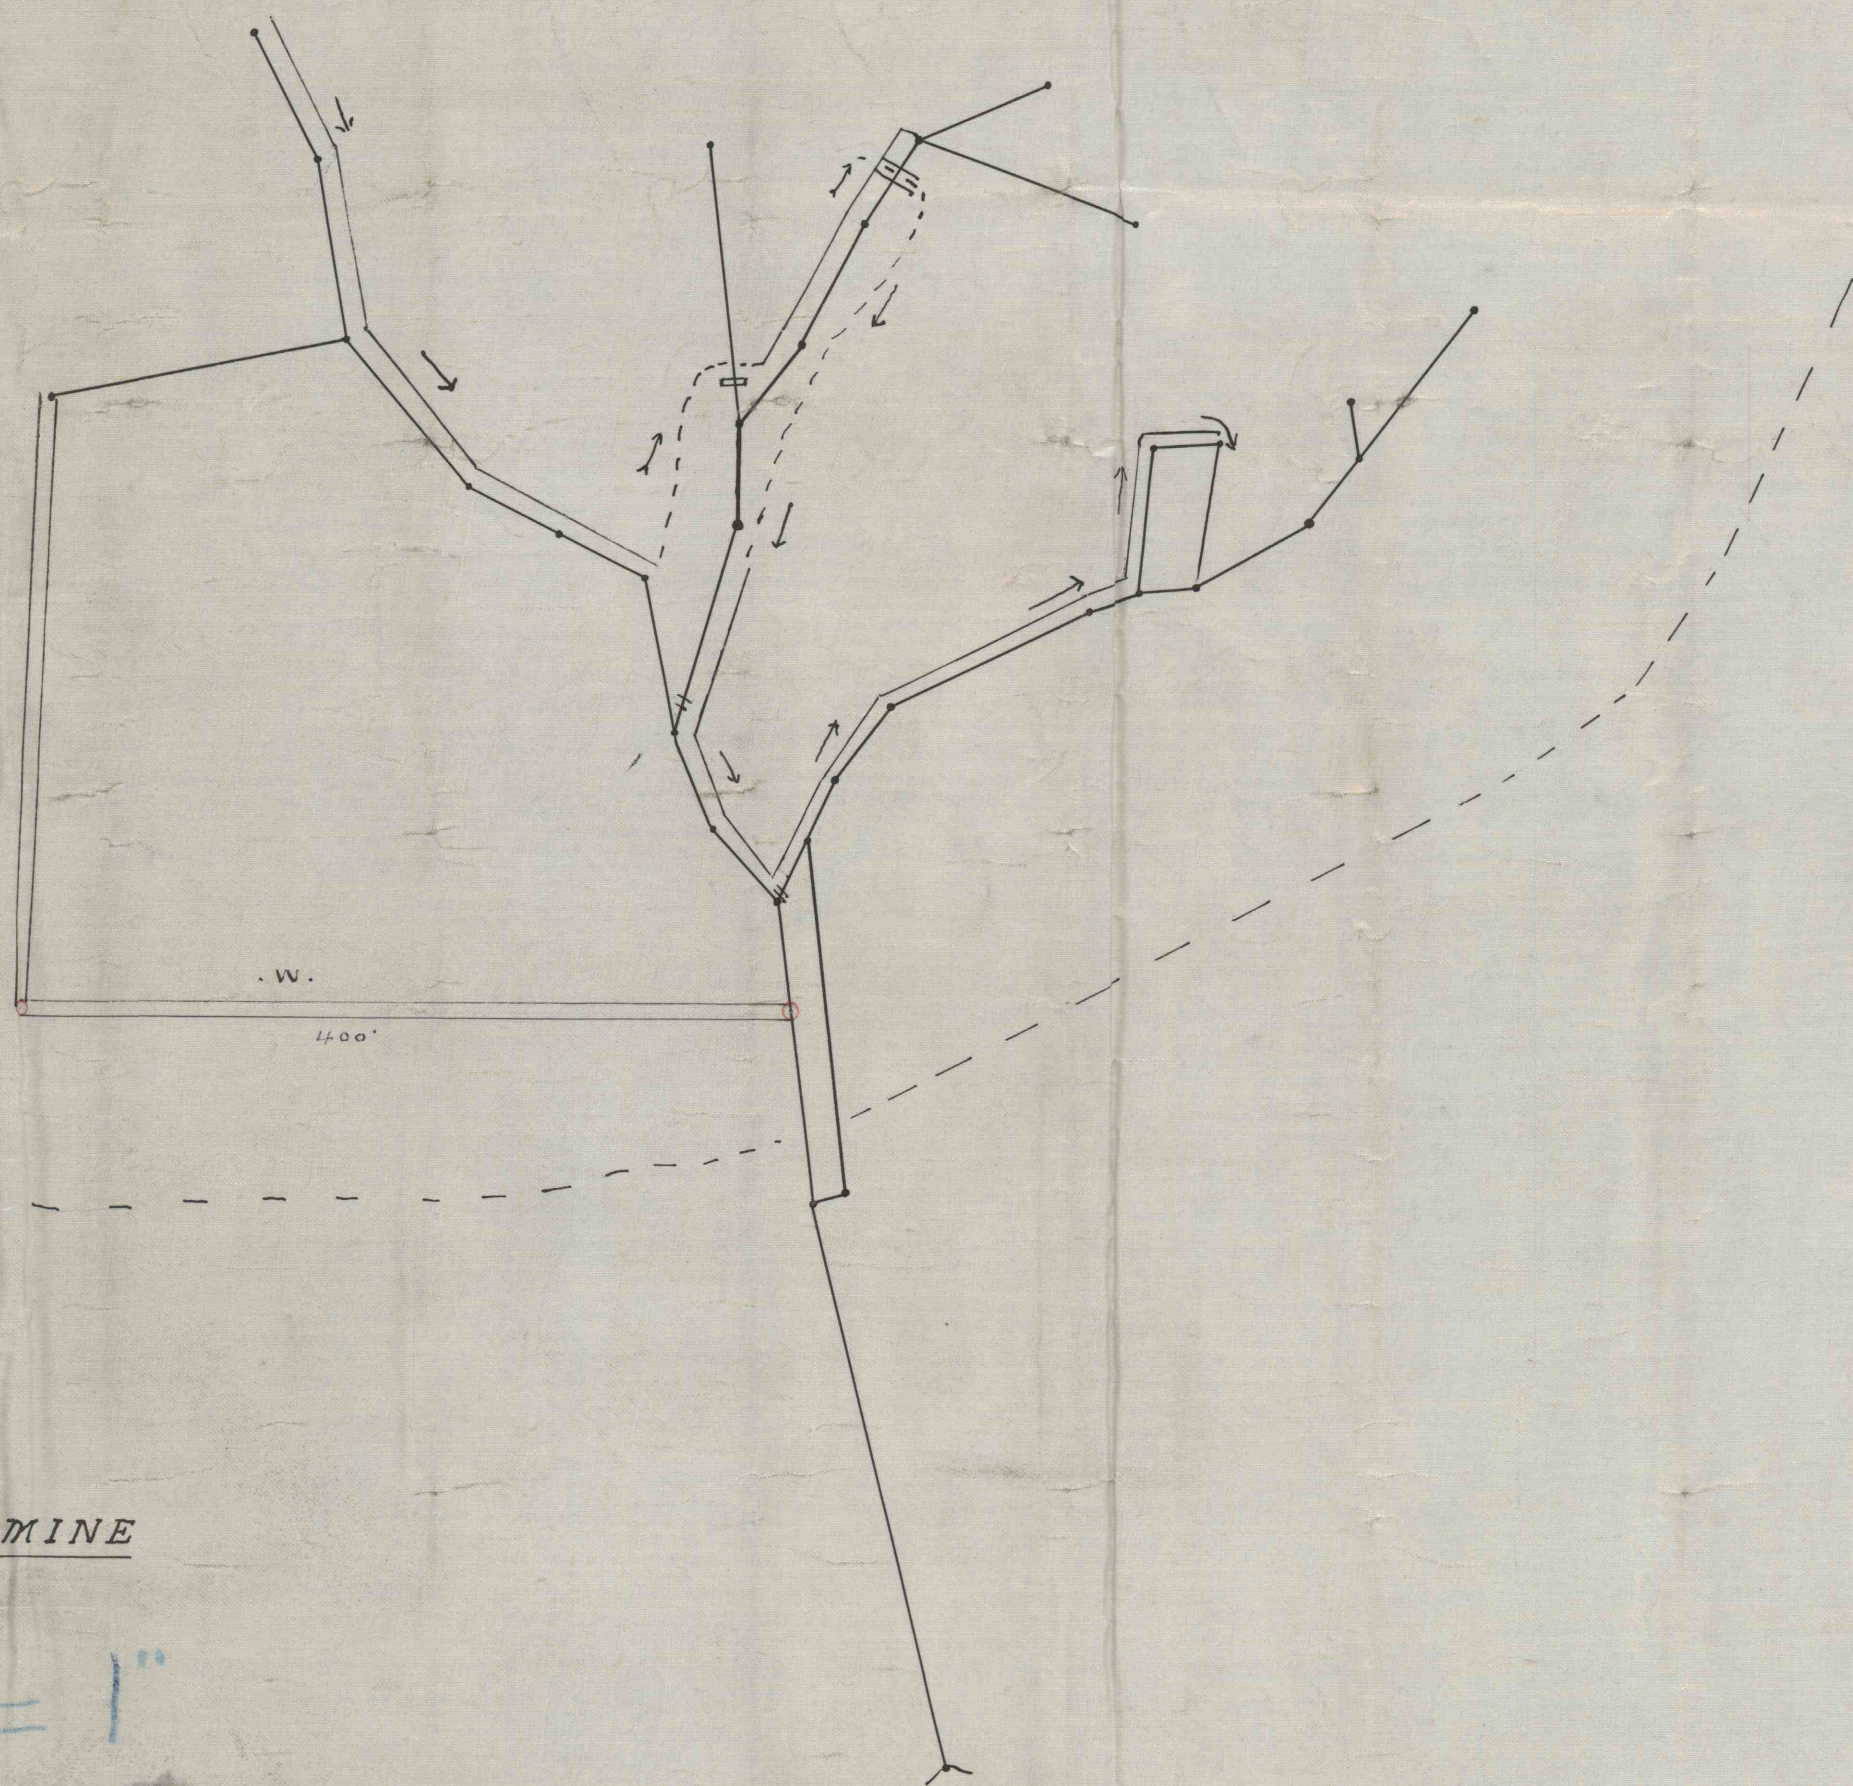

MAP OF JENKING'S BROS, MINE
BLOSSBURG, PA.

100' = 1"

Wm Knapp Inspector

1406
8-10-99
CC

10"

10"